


6 INCH WHITE LINE
 MM 2.301 ~ 2.917 RT (SOLID)(EDGE LINE)
 MM 2.301 ~ 2.917 LT (SOLID)(EDGE LINE)

6 INCH YELLOW LINE
 MM 2.301 ~ 2.410 CL (SOLID)(DBL)
 MM 2.410 ~ 2.500 CL (SOLID LT, DASHED RT)
 MM 2.500 ~ 2.917 CL (DASHED)

LETTER OR SYMBOL
 MM 2.306 RT (↗)

MILLED RUMBLE STRIPS
 MM 2.301 ~ 2.917 CL
 MM 2.301 ~ 2.630 LT
 MM 2.671 ~ 2.917 LT
 MM 2.320 ~ 2.630 RT
 MM 2.671 ~ 2.917 RT

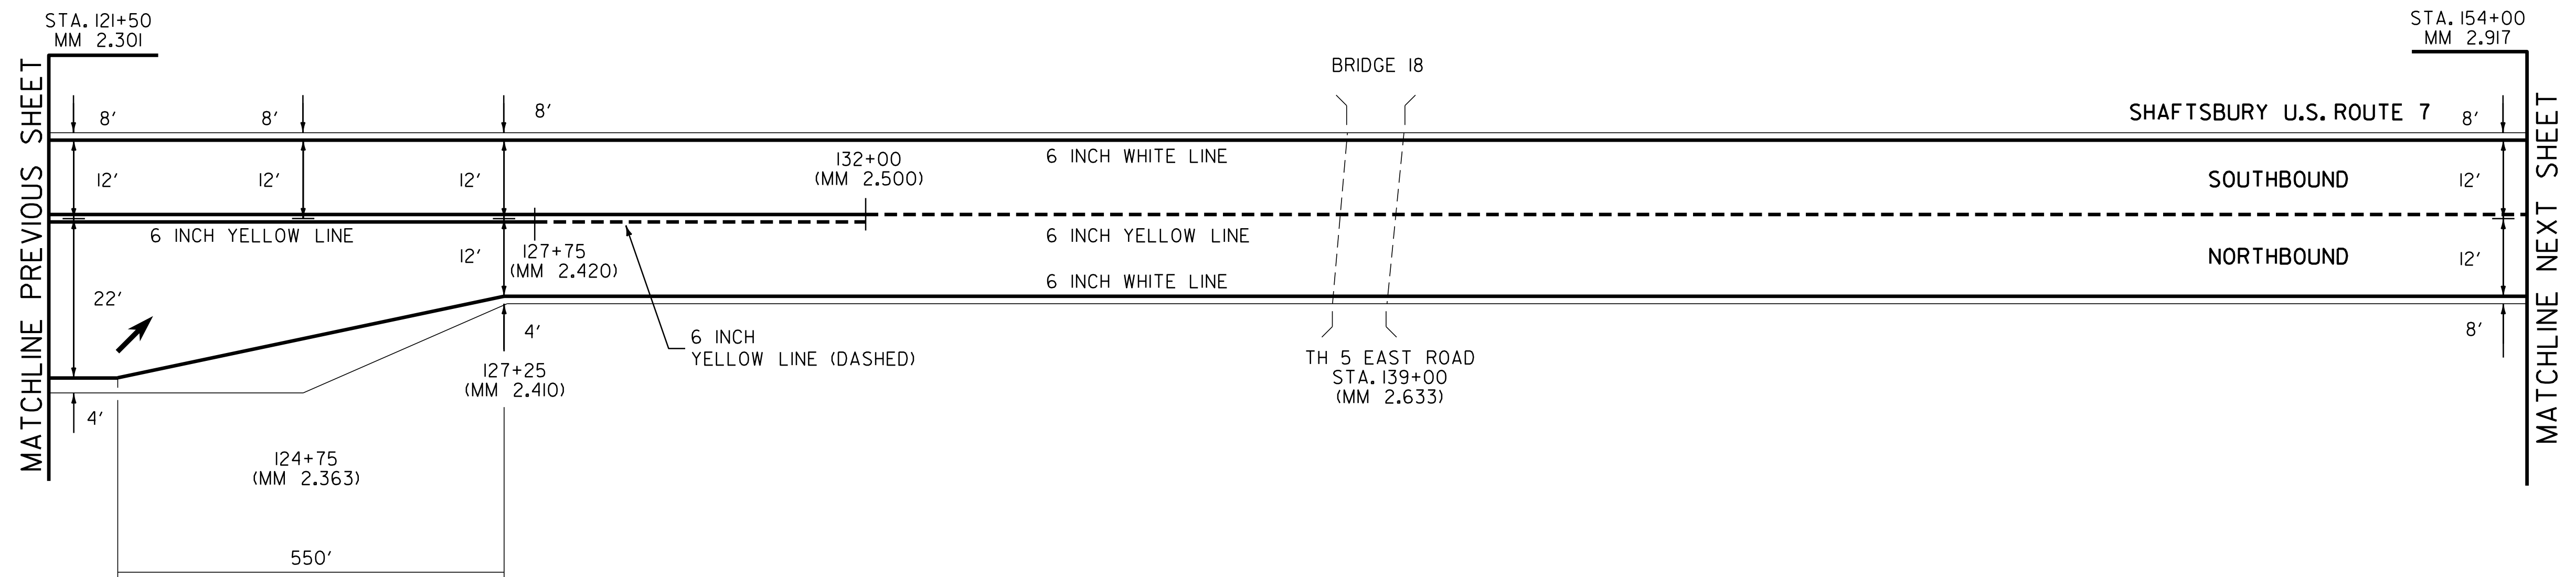

NOT TO SCALE

PAVING PROJECT LAYOUT #10	PROJECT NAME: BENNINGTON-MANCHESTER	PLOT DATE: 22-AUG-2013 14:34
	PROJECT NUMBER: NH SURF(29)	DRAWN BY: JLR
	FILE NAME: 11b026.dgn	CHECKED BY: PVT. MGT.
	PROJECT LEADER: M. FOWLER	SHEET 19 OF 63
DESIGNED BY: JLR		
11b026-19.i		