

6 INCH WHITE LINE


MM 2.917 ~ 3.541 RT (SOLID)(EDGE LINE)
 MM 3.380 ~ 3.541 RT (DASHED)(12' RT)
 MM 2.917 ~ 3.541 LT (SOLID)(EDGE LINE)

6 INCH YELLOW LINE

MM 2.917 ~ 3.260 CL (DASHED)
 MM 3.260 ~ 3.340 CL (DASH LT, SOLID RT)
 MM 3.340 ~ 3.541 CL (SOLID)(DBL)

MILLED RUMBLE STRIPS

MM 2.917 ~ 3.541 CL
 MM 2.917 ~ 2.925 LT
 MM 2.975 ~ 3.541 LT
 MM 2.917 ~ 3.541 RT

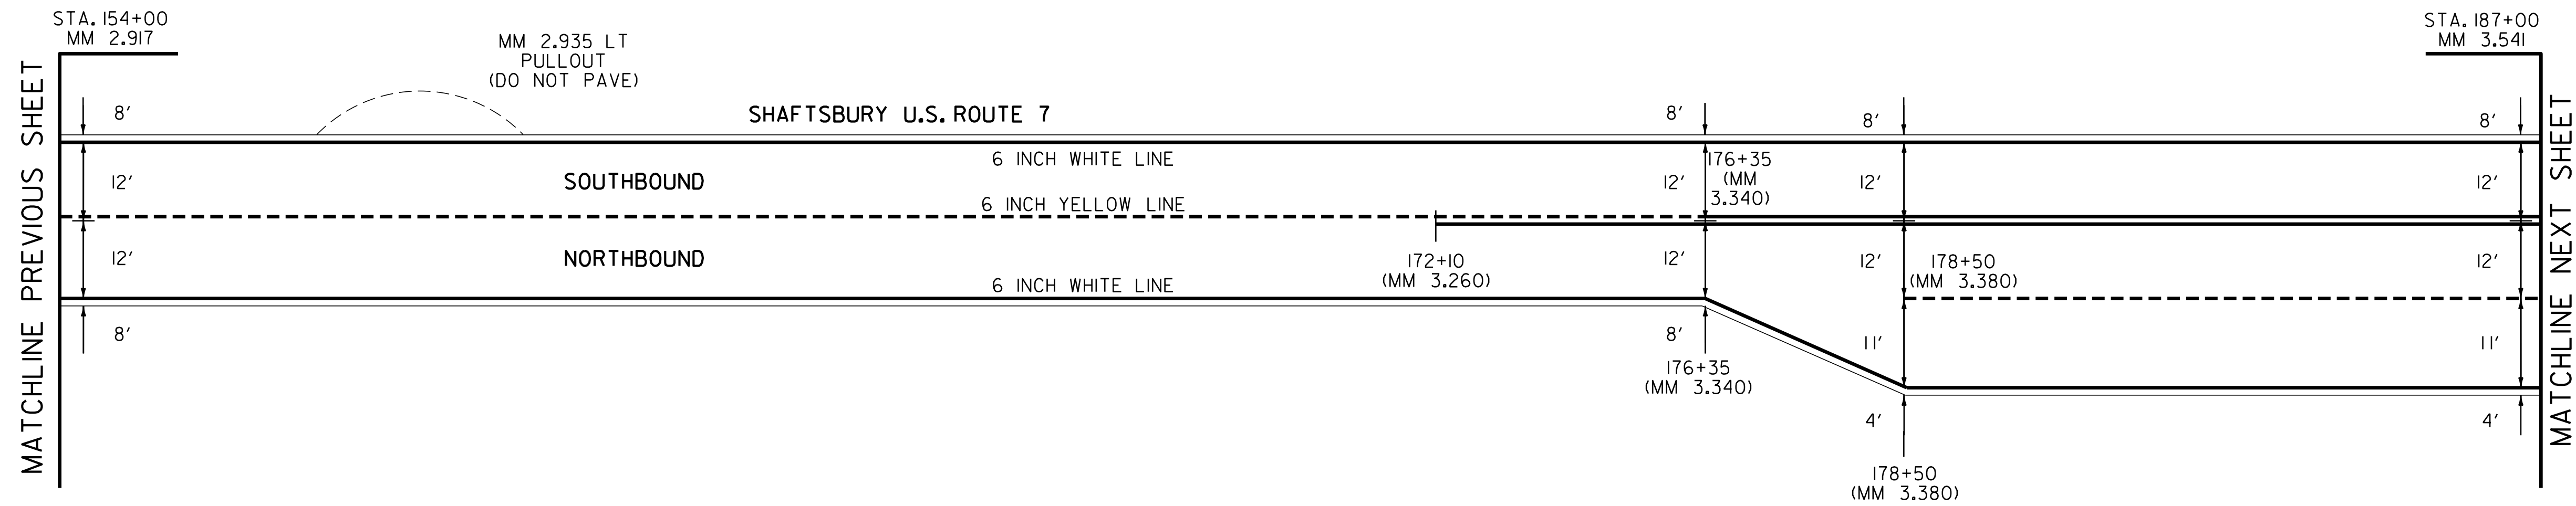

NOT TO SCALE

PAVING PROJECT LAYOUT #11	PROJECT NAME: BENNINGTON-MANCHESTER	PLOT DATE: 22-AUG-2013 14:34
	PROJECT NUMBER: NH SURF(29)	DRAWN BY: JLR
	FILE NAME: 11b026.dgn	CHECKED BY: PVT. MGT.
	PROJECT LEADER: M. FOWLER	SHEET 20 OF 63
	DESIGNED BY: JLR	
	11b026-20.i	