

6 INCH WHITE LINE


MM 3.541 ~ 4.166 LT (SOLID)(EDGE LINE)
MM 3.541 ~ 4.166 RT (SOLID)(EDGE LINE)
MM 3.541 ~ 4.166 RT (DASHED)(12' RT)

6 INCH YELLOW LINE

MM 3.541 ~ 4.166 CL (SOLID)(DBL)

MILLED RUMBLE STRIPS

MM 3.541 ~ 4.166 CL
MM 3.541 ~ 4.166 LT
MM 3.541 ~ 4.095 RT

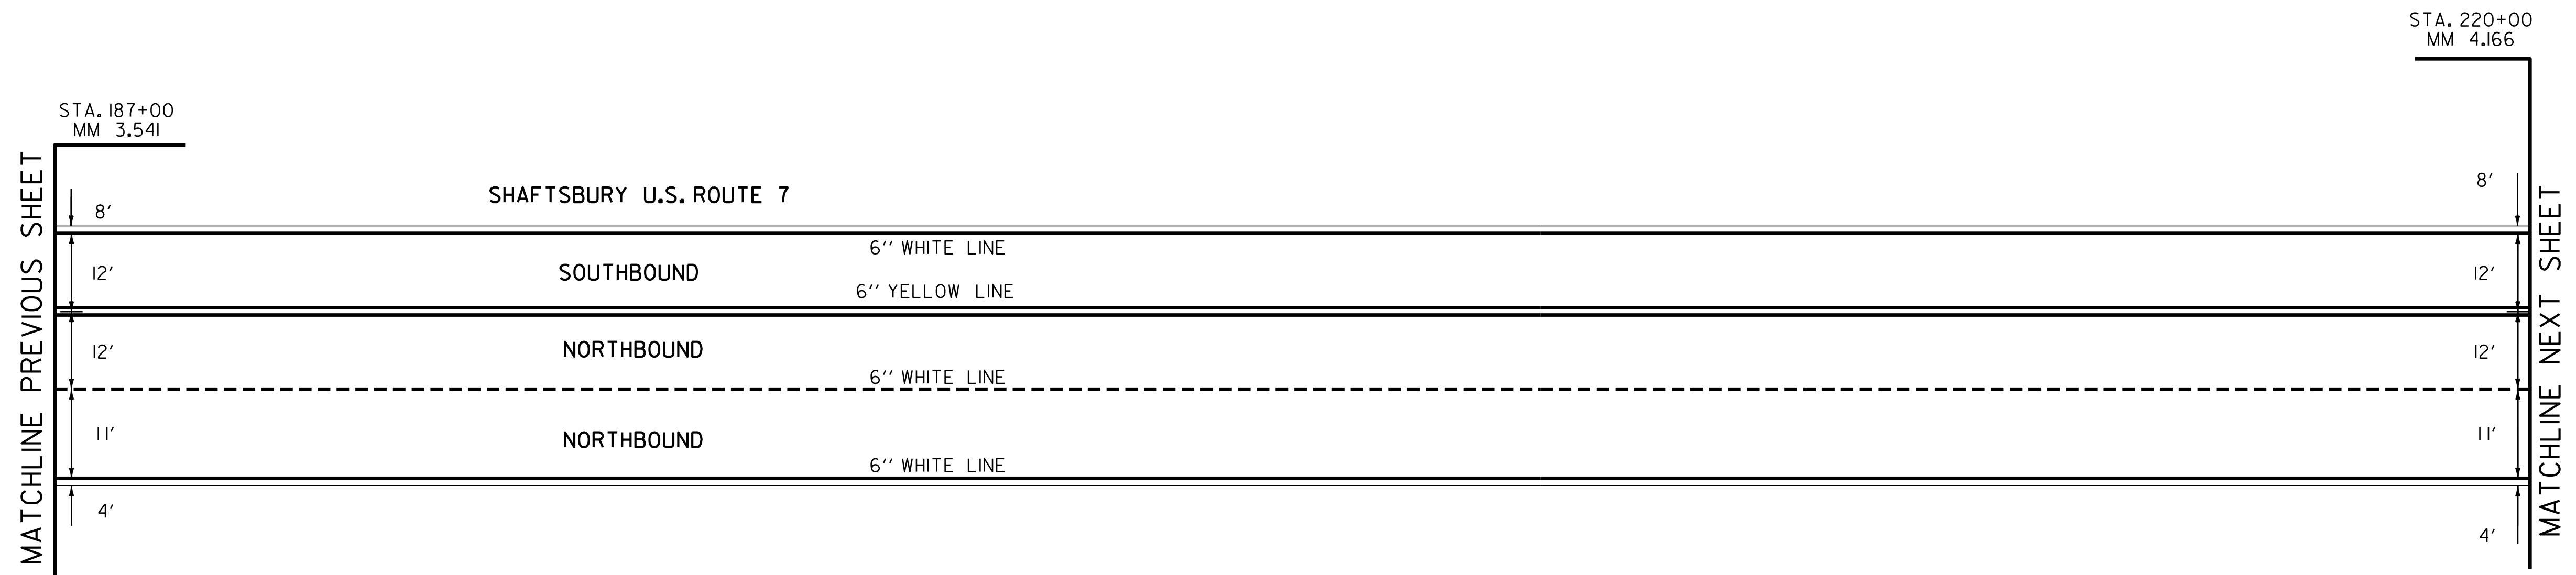

NOT TO SCALE

PAVING PROJECT LAYOUT #12	PROJECT NAME: BENNINGTON-MANCHESTER
	PROJECT NUMBER: NH SURF(29)
	FILE NAME: 11b026.dgn
	PLOT DATE: 22-AUG-2013 14:34
PROJECT LEADER: M. FOWLER	DRAWN BY: JLR
DESIGNED BY: JLR	CHECKED BY: PVT. MGT.
11b026-21.i	SHEET 21 OF 63