


6 INCH WHITE LINE
 MM 0.057 ~ 0.682 RT (SOLID)(EDGE LINE)
 MM 0.057 ~ 0.682 LT (DASHED)(12' LT)
 MM 0.057 ~ 0.682 LT (SOLID)(EDGE LINE)

6 INCH YELLOW LINE
 MM 0.057 ~ 0.682 CL (SOLID)(DBL)

MILLED RUMBLE STRIPS
 MM 0.057 ~ 0.682 CL
 MM 0.057 ~ 0.682 LT
 MM 0.057 ~ 0.682 RT

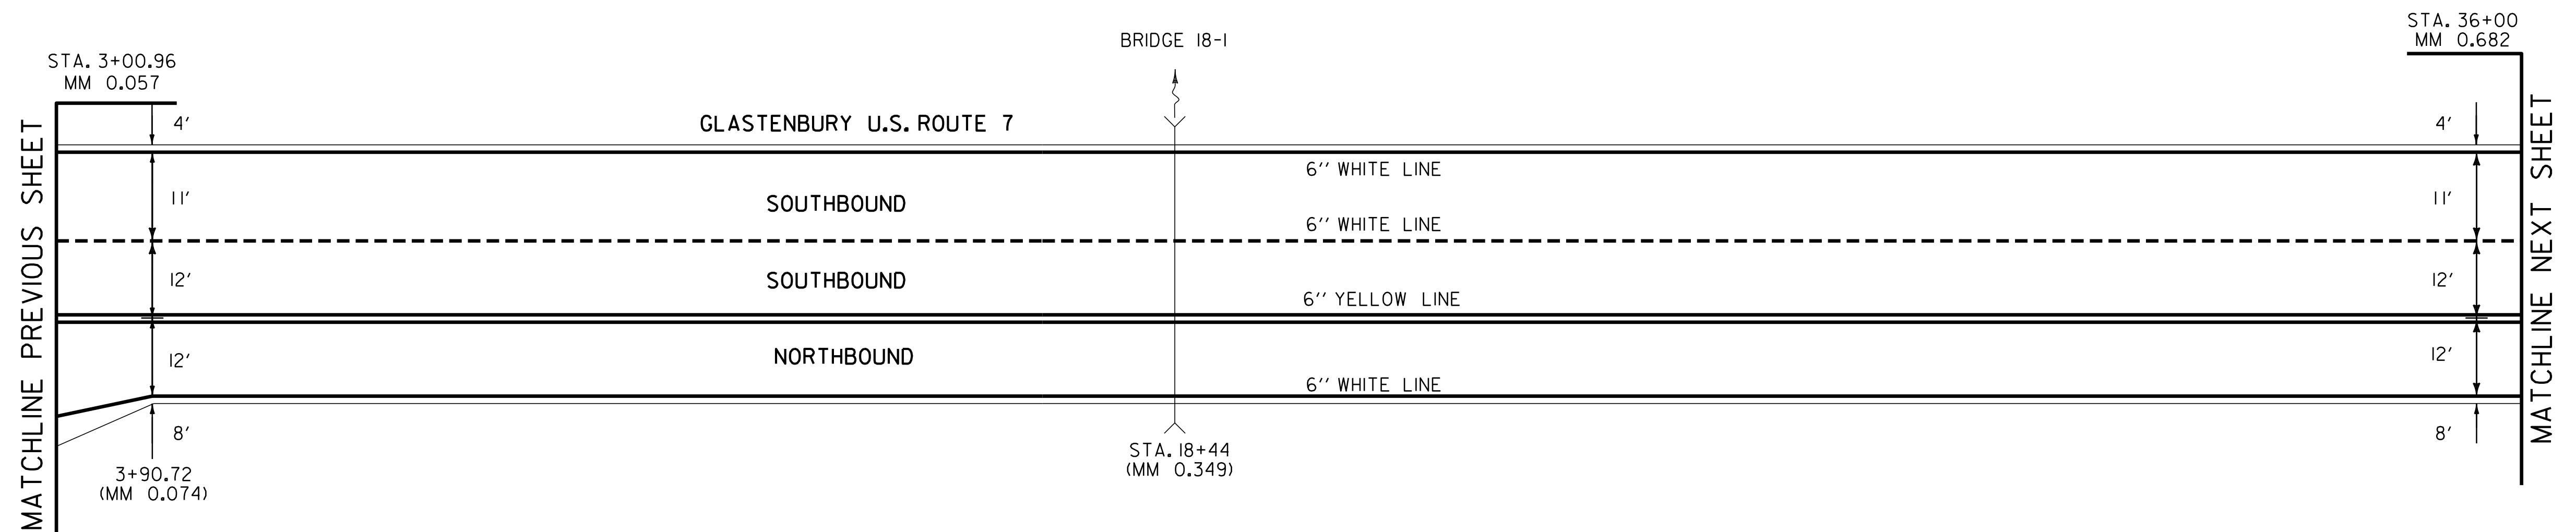

NOT TO SCALE

PAVING PROJECT LAYOUT #14	PROJECT NAME: BENNINGTON-MANCHESTER	FILE NAME: 11b026.dgn	PLOT DATE: 22-AUG-2013 14:34
	PROJECT NUMBER: NH SURF(29)	PROJECT LEADER: M. FOWLER	DRAWN BY: JLR
		DESIGNED BY: JLR	CHECKED BY: PVT. MGT.