


6 INCH WHITE LINE
 MM 0.682 ~ 5.217 RT (SOLID)(EDGE LINE)
 MM 0.682 ~ 5.217 LT (DASHED)(12' LT)
 MM 0.682 ~ 5.217 LT (SOLID)(EDGE LINE)

6 INCH YELLOW LINE
 MM 0.682 ~ 5.217 CL (SOLID)(DBL)

MILLED RUMBLE STRIPS
 MM 0.682 ~ 5.217 CL
 MM 0.682 ~ 0.715 LT
 MM 0.805 ~ 5.217 LT
 MM 0.682 ~ 5.217 RT

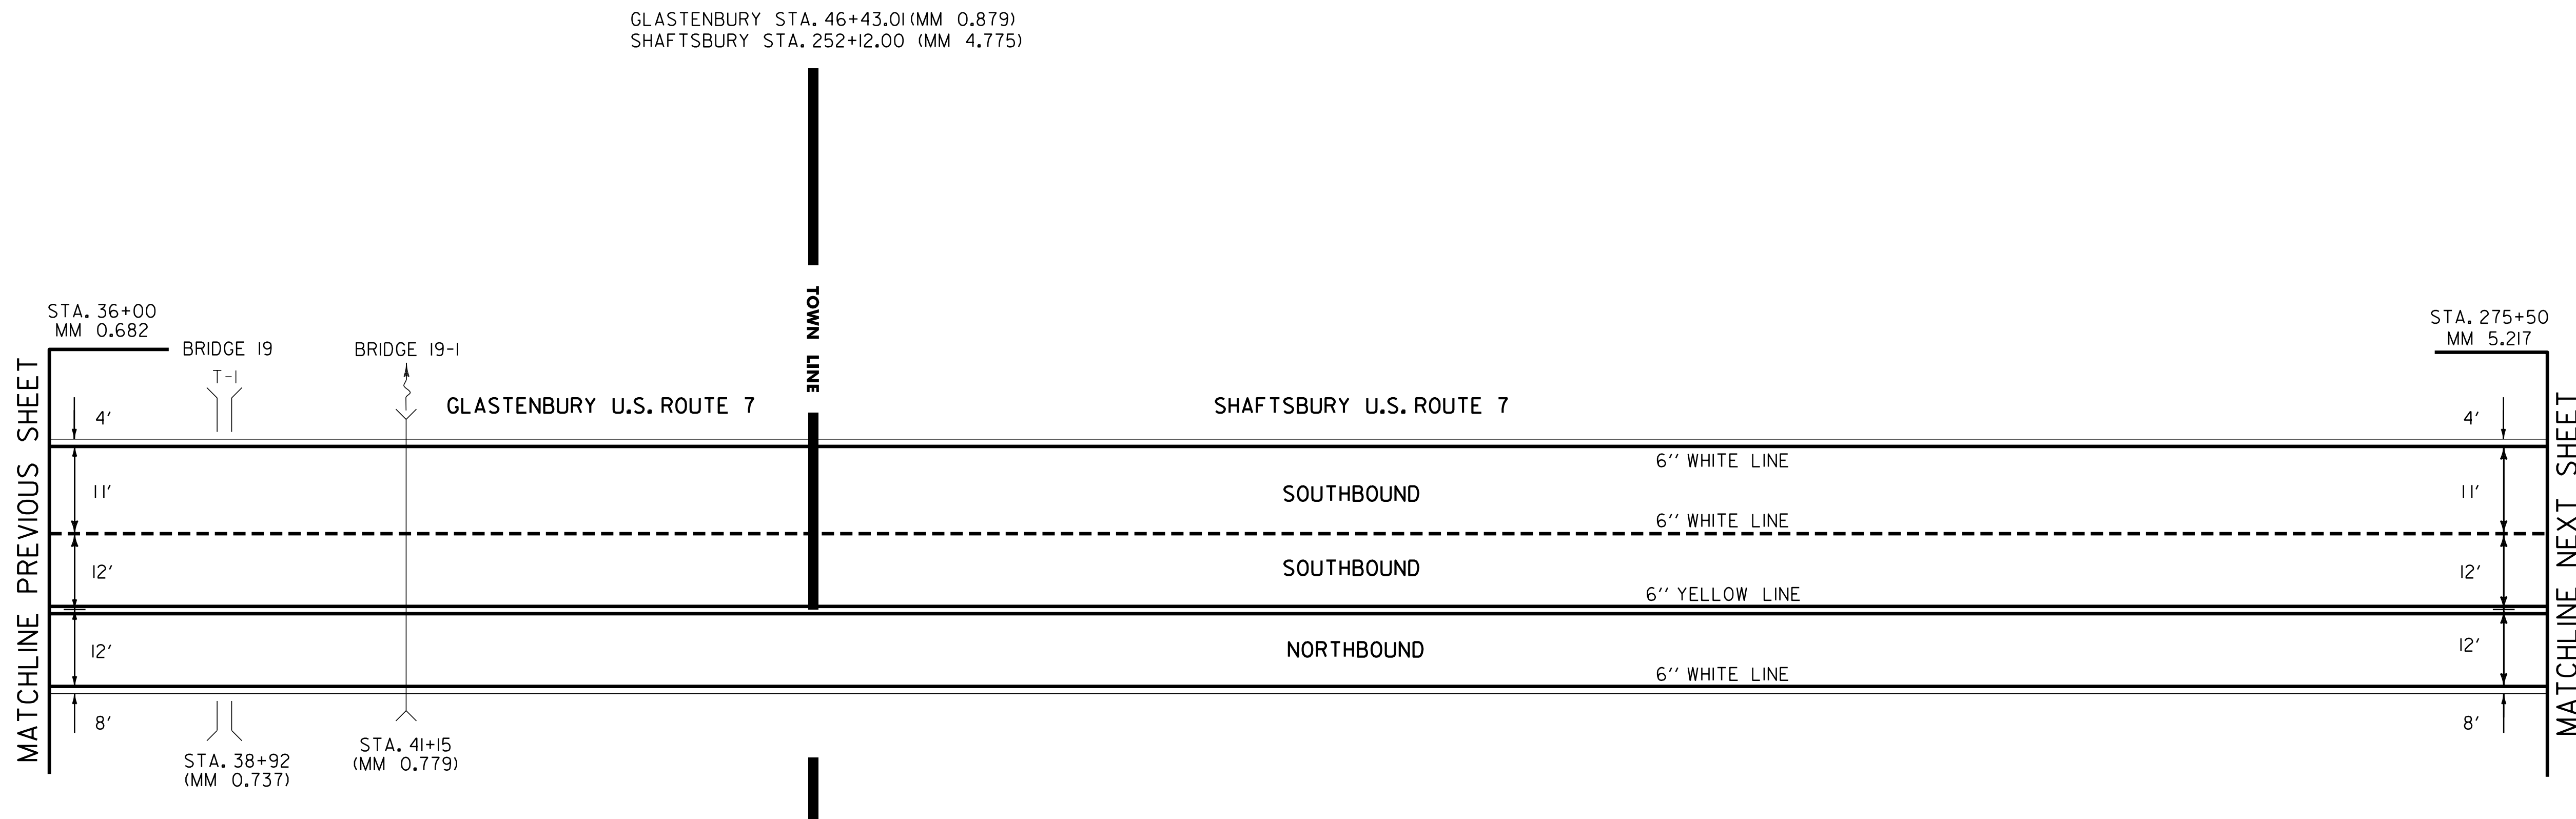

NOT TO SCALE

PAVING PROJECT LAYOUT #15	PROJECT NAME: BENNINGTON-MANCHESTER
	PROJECT NUMBER: NH SURF(29)
	FILE NAME: 11b026.dgn
	PLOT DATE: 22-AUG-2013 14:34
PROJECT LEADER: M. FOWLER	DRAWN BY: JLR
DESIGNED BY: JLR	CHECKED BY: PVT. MGT.
11b026-24.i	SHEET 24 OF 63