


6 INCH WHITE LINE
 MM 5.217 ~ 1.363 RT (SOLID)(EDGE LINE)
 MM 5.217 ~ 1.363 LT (DASHED)(12' LT)
 MM 5.217 ~ 1.363 LT (SOLID)(EDGE LINE)

6 INCH YELLOW LINE
 MM 5.217 ~ 1.363 CL (SOLID)(DBL)

MILLED RUMBLE STRIPS
 MM 5.217 ~ 1.363 CL
 MM 5.217 ~ 0.955 LT
 MM 1.020 ~ 1.363 LT
 MM 5.217 ~ 1.363 RT

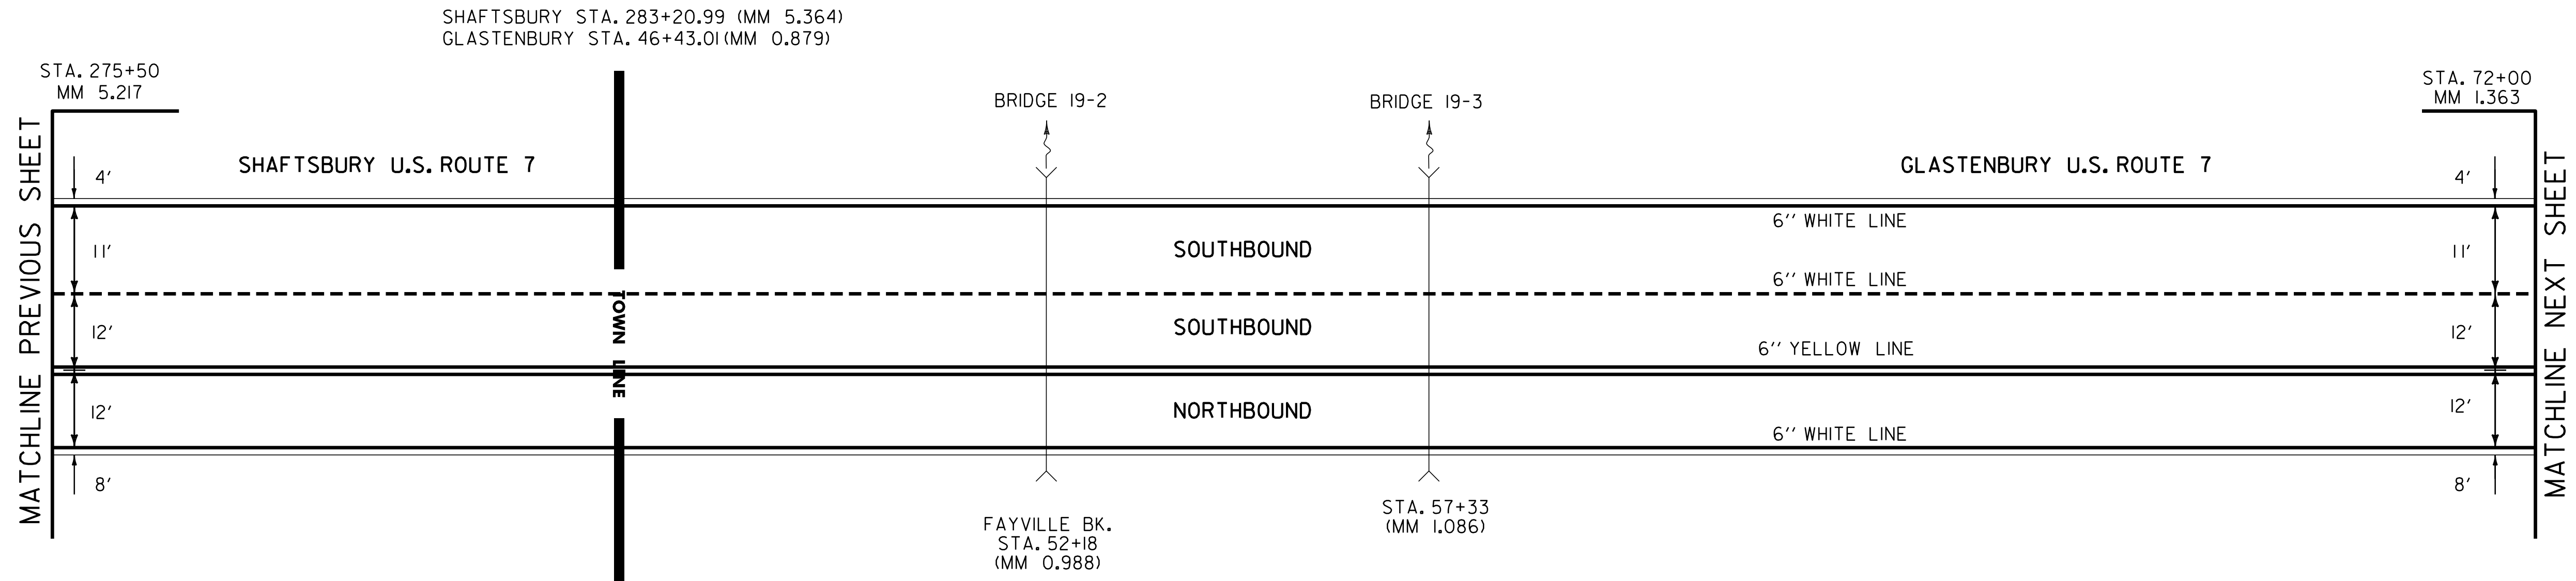

NOT TO SCALE

| | |
|--|-------------------------------------|
| PAVING PROJECT LAYOUT #16 | PROJECT NAME: BENNINGTON-MANCHESTER |
| | PROJECT NUMBER: NH SURF(29) |
| | FILE NAME: 11b026.dgn |
| | PLOT DATE: 22-AUG-2013 14:34 |
| DESIGNED BY: JLR | DRAWN BY: JLR |
| 11b026-25.i | CHECKED BY: PVT. MGT. |
| | SHEET 25 OF 63 |