


6 INCH WHITE LINE  
 MM 1.363 ~ 0.246 RT (SOLID)(EDGE LINE)  
 MM 1.363 ~ 0.246 LT (DASHED)(12' LT)  
 MM 1.363 ~ 0.246 LT (SOLID)(EDGE LINE)

6 INCH YELLOW LINE  
 MM 1.363 ~ 0.246 CL (SOLID)(DBL)

MILLED RUMBLE STRIPS  
 MM 1.363 ~ 0.246 CL  
 MM 1.363 ~ 1.475 LT  
 MM 1.654 ~ 0.246 LT  
 MM 1.363 ~ 0.246 RT

GLASTENBURY STA. 94+18.99 (MM 1.784)  
 SUNDERLAND STA. 0+00.00 (MM 0.000)

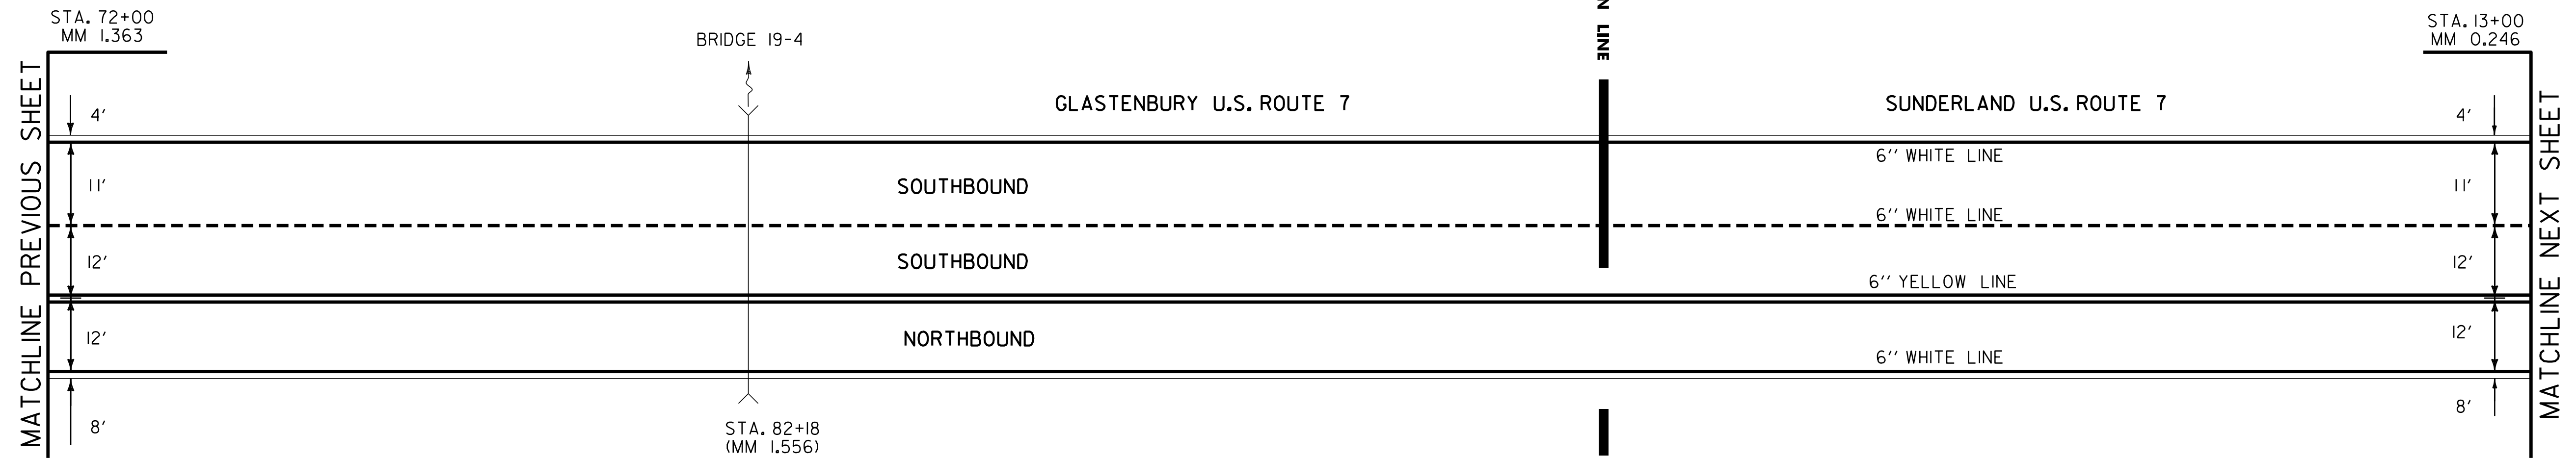

NOT TO SCALE

<b>PAVING PROJECT LAYOUT #17</b>	PROJECT NAME: BENNINGTON-MANCHESTER	FILE NAME: 11b026.dgn	PLOT DATE: 22-AUG-2013 14:34
	PROJECT NUMBER: NH SURF(29)	PROJECT LEADER: M. FOWLER	DRAWN BY: JLR
		DESIGNED BY: JLR	CHECKED BY: PVT. MGT.
		11b026-26.i	