

6 INCH WHITE LINE


(ALL LINES WILL INCLUDE BREAKS FOR RAMPS)  
 MM 0.933 ~ 1.614 LT (SOLID)(EDGE LINE)  
 MM 0.933 ~ 1.614 RT (SOLID)(EDGE LINE)

6 INCH YELLOW LINE

MM 0.933 ~ 0.956 CL (SOLID RT, DASH LT)  
 MM 0.956 ~ 1.614 CL (SOLID)(DBL)

MILLED RUMBLE STRIPS

MM 0.933 ~ 1.614 CL  
 MM 0.933 ~ 1.005 LT  
 MM 1.170 ~ 1.504 LT  
 MM 1.545 ~ 1.614 LT  
 MM 0.933 ~ 1.290 RT  
 MM 1.435 ~ 1.550 RT  
 MM 1.580 ~ 1.614 RT

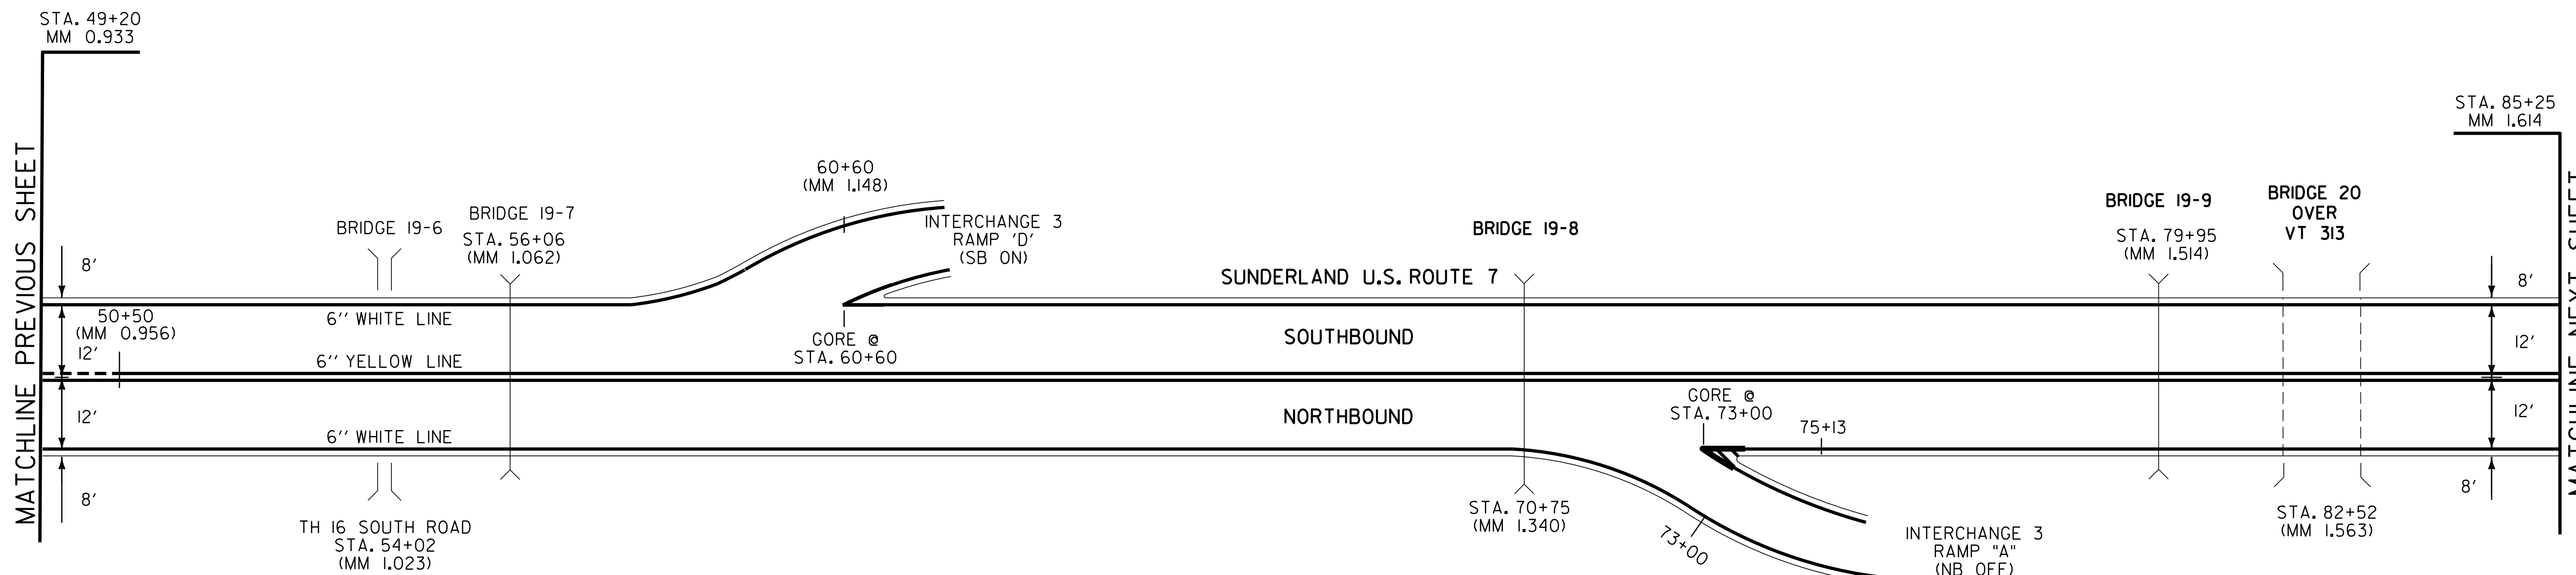

FOR INTERCHANGE #3 DETAILS,  
 SEE SHEET 48

NOT TO SCALE

<b>PAVING PROJECT LAYOUT #19</b>	PROJECT NAME: BENNINGTON-MANCHESTER	FILE NAME: 11b026.dgn	PLOT DATE: 22-AUG-2013 14:34
	PROJECT NUMBER: NH SURF(29)	PROJECT LEADER: M. FOWLER	DRAWN BY: JLR
		DESIGNED BY: JLR	CHECKED BY: PVT. MGT.
		11b026-28.i	SHEET 28 OF 63