


6 INCH WHITE LINE
 MM 2.301 ~ 2.983 LT (SOLID)(EDGE LINE)
 MM 2.301 ~ 2.983 RT (SOLID)(EDGE LINE)

6 INCH YELLOW LINE
 MM 2.301 ~ 2.330 CL (DASHED)
 MM 2.330 ~ 2.500 CL (DASHED LT, SOLID RT)
 MM 2.500 ~ 2.530 CL (SOLID)(DBL)
 MM 2.530 ~ 2.680 CL (SOLID LT, DASHED RT)
 MM 2.680 ~ 2.983 CL (DASHED)

MILLED RUMBLE STRIPS
 MM 2.301 ~ 2.983 CL
 MM 2.301 ~ 2.505 LT
 MM 2.550 ~ 2.983 LT
 MM 2.301 ~ 2.505 RT
 MM 2.535 ~ 2.983 RT

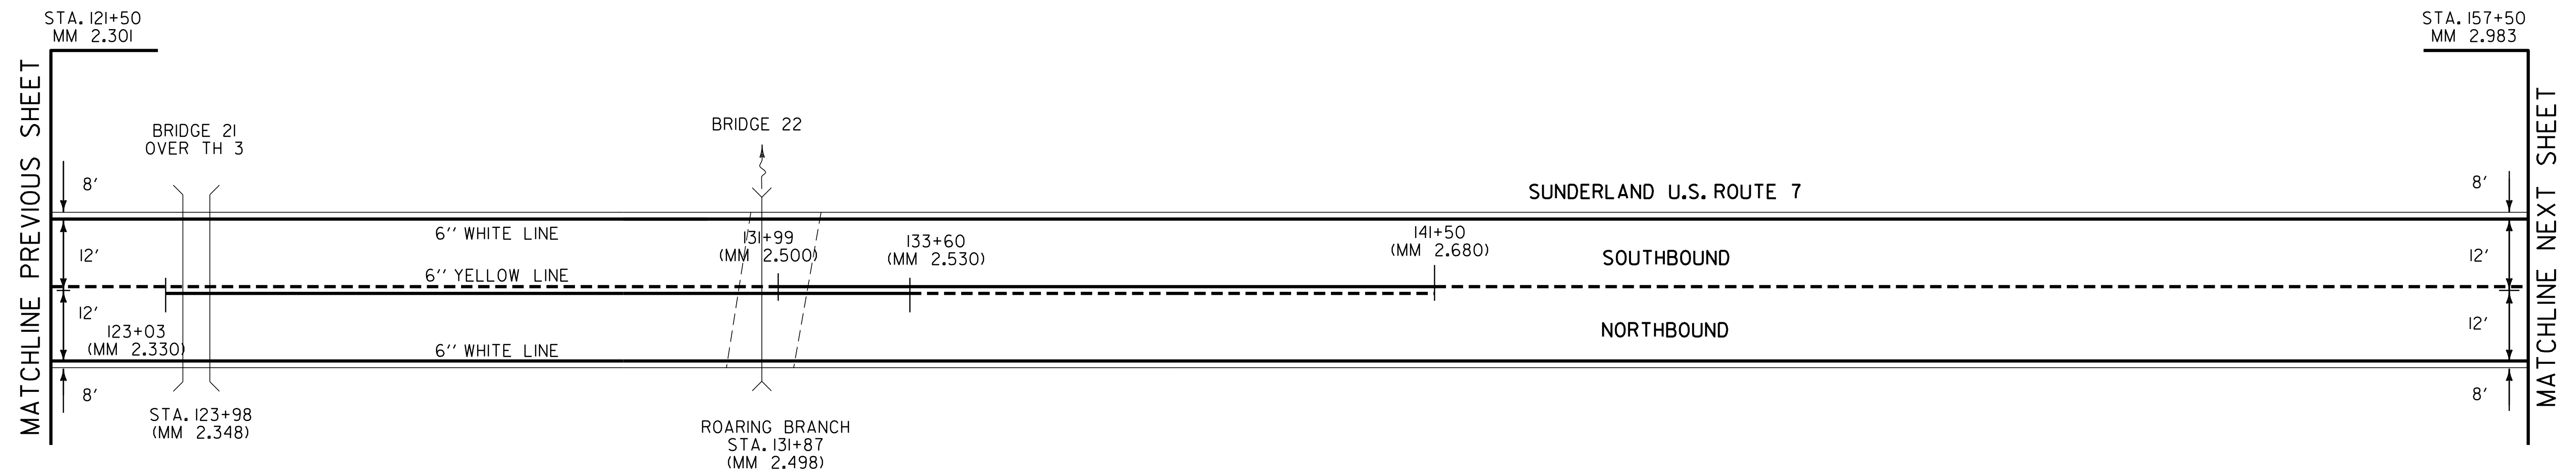

NOT TO SCALE

PAVING PROJECT LAYOUT #21	PROJECT NAME: BENNINGTON-MANCHESTER
	PROJECT NUMBER: NH SURF(29)
	FILE NAME: 11b026.dgn
	PLOT DATE: 22-AUG-2013 14:34
PROJECT LEADER: M. FOWLER	DRAWN BY: JLR
DESIGNED BY: JLR	CHECKED BY: PVT. MGT.
11b026-30.i	SHEET 30 OF 63