


6 INCH WHITE LINE
 MM 2.983 ~ 3.665 LT (SOLID)(EDGE LINE)
 MM 2.983 ~ 3.665 RT (SOLID)(EDGE LINE)

6 INCH YELLOW LINE
 MM 2.983 ~ 3.665 CL (DASHED)

MILLED RUMBLE STRIPS
 MM 2.983 ~ 3.665 CL
 MM 2.983 ~ 3.665 LT
 MM 2.983 ~ 3.665 RT

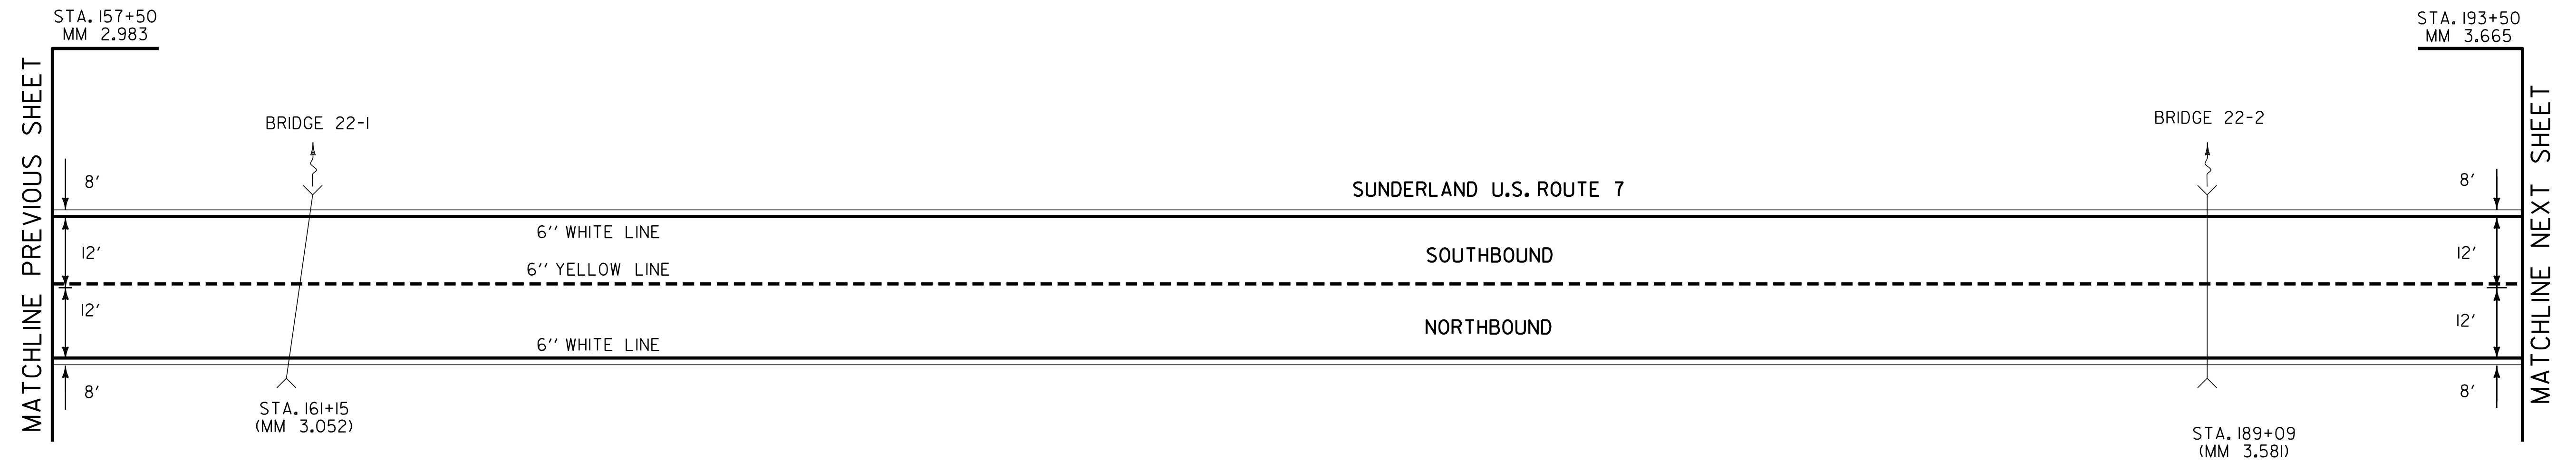

NOT TO SCALE

**PAVING
 PROJECT
 LAYOUT
 #22**

PROJECT NAME: BENNINGTON-MANCHESTER
 PROJECT NUMBER: NH SURF(29)

FILE NAME: 11b026.dgn
 PROJECT LEADER: M. FOWLER
 DESIGNED BY: JLR
 11b026-31.i

PLOT DATE: 22-AUG-2013 14:34
 DRAWN BY: JLR
 CHECKED BY: PVT. MGT.
 SHEET 31 OF 63