


6 INCH WHITE LINE  
 MM 3.665 ~ 4.346 LT (SOLID)(EDGE LINE)  
 MM 3.665 ~ 4.346 RT (SOLID)(EDGE LINE)  
 MM 4.310 ~ 4.346 RT (DASHED)(12' RT)

6 INCH YELLOW LINE  
 MM 3.665 ~ 4.190 CL (DASHED)  
 MM 4.190 ~ 4.270 CL (DASHED LT, SOLID RT)  
 MM 4.270 ~ 4.346 CL (SOLID)(DBL)

MILLED RUMBLE STRIPS  
 MM 3.665 ~ 4.346 CL  
 MM 3.665 ~ 4.346 LT  
 MM 3.665 ~ 4.346 RT

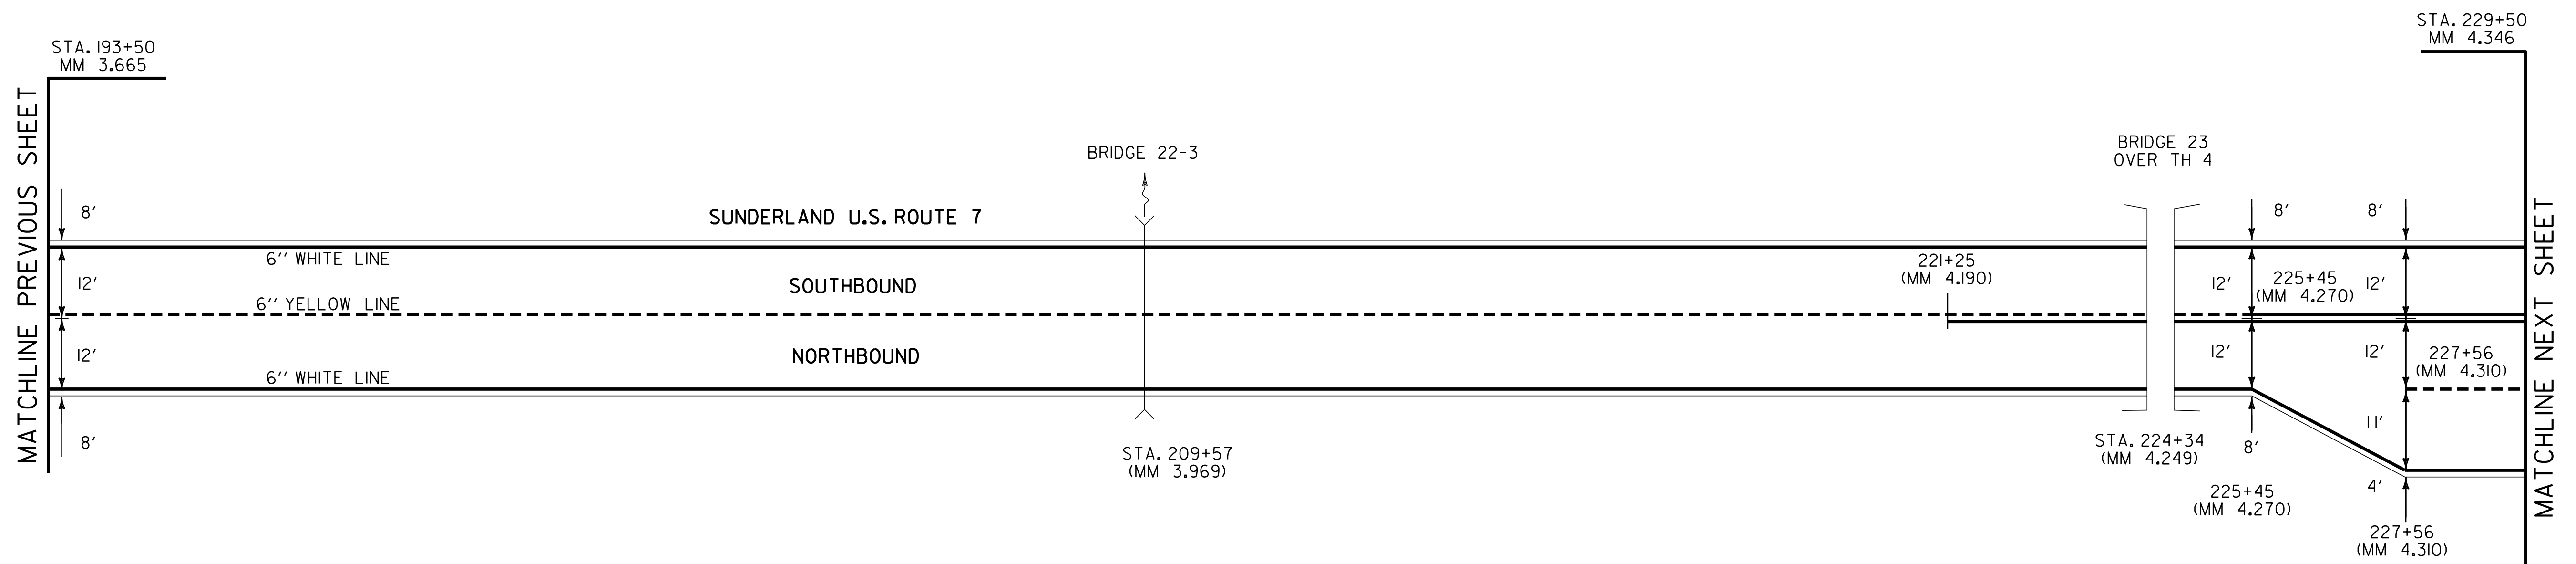

NOT TO SCALE

<b>PAVING PROJECT LAYOUT #23</b>	PROJECT NAME: BENNINGTON-MANCHESTER
	PROJECT NUMBER: NH SURF(29)
	FILE NAME: 11b026.dgn
	PLOT DATE: 22-AUG-2013 14:34
PROJECT LEADER: M. FOWLER	DRAWN BY: JLR
DESIGNED BY: JLR	CHECKED BY: PVT. MGT.
11b026-32.i	SHEET 32 OF 63