


6 INCH WHITE LINE  
 MM 5.033 ~ 5.700 RT (SOLID)(EDGE LINE)  
 MM 5.033 ~ 5.700 LT (SOLID)(EDGE LINE)  
 MM 5.033 ~ 5.091 RT (DASHED)(12' RT)

6 INCH YELLOW LINE  
 MM 5.033 ~ 5.235 CL (SOLID)(DBL)  
 MM 5.235 ~ 5.315 CL (SOLID LT, DASH RT)  
 MM 5.315 ~ 5.700 CL (DASHED)

LETTER OR SYMBOL  
 MM 5.091 RT (↗)  
 MM 5.125 RT (↗)  
 MM 5.159 RT (↗)

MILLED RUMBLE STRIPS  
 MM 5.033 ~ 5.700 CL  
 MM 5.033 ~ 5.700 LT  
 MM 5.033 ~ 5.700 RT

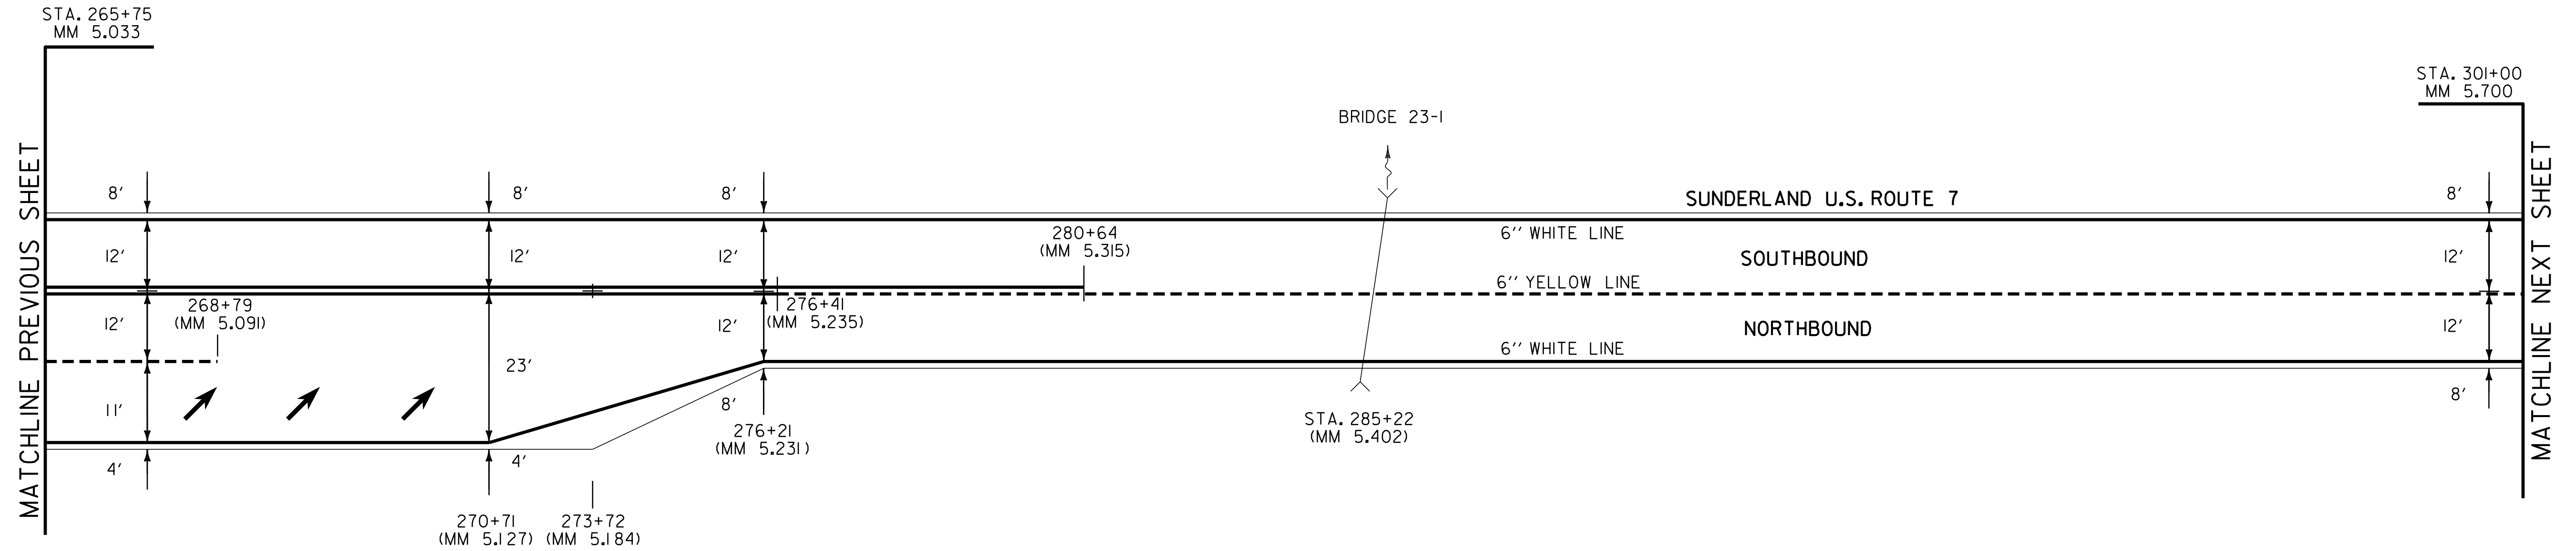

NOT TO SCALE

<b>PAVING PROJECT LAYOUT #25</b>	PROJECT NAME: BENNINGTON-MANCHESTER	PLOT DATE: 22-AUG-2013 14:34
	PROJECT NUMBER: NH SURF(29)	DRAWN BY: JLR
	FILE NAME: I1b026.dgn	CHECKED BY: PVT. MGT.
	PROJECT LEADER: M. FOWLER	SHEET 34 OF 63
DESIGNED BY: JLR		
I1b026-34.i		