


6 INCH WHITE LINE  
 MM 5.700 ~ 6.401 RT (SOLID)(EDGE LINE)  
 MM 5.700 ~ 6.401 LT (SOLID)(EDGE LINE)  
 MM 6.295 ~ 6.401 RT (DASHED)(12' RT)

6 INCH YELLOW LINE  
 MM 5.700 ~ 6.160 CL (DASHED)  
 MM 6.160 ~ 6.240 CL (DASHED LT, SOLID RT)  
 MM 6.240 ~ 6.401 CL (SOLID)(DBL)

MILLED RUMBLE STRIPS  
 MM 5.700 ~ 6.401 CL  
 MM 5.700 ~ 6.401 LT  
 MM 5.700 ~ 6.401 RT

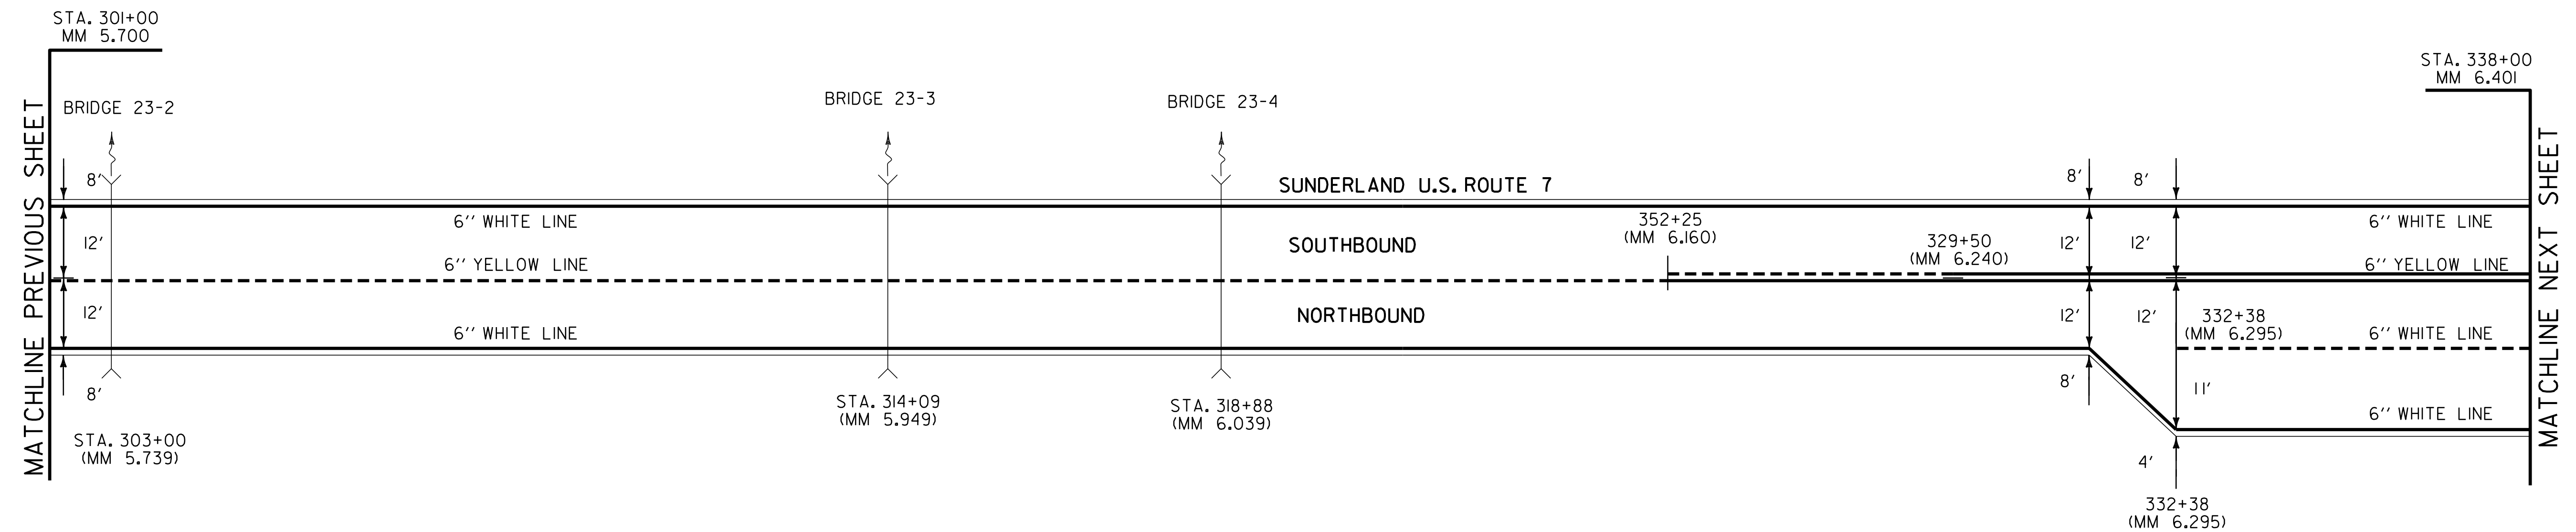

NOT TO SCALE

<b>PAVING PROJECT LAYOUT #26</b>	PROJECT NAME: BENNINGTON-MANCHESTER
	PROJECT NUMBER: NH SURF(29)
	FILE NAME: 11b026.dgn
	PLOT DATE: 22-AUG-2013 14:34
DESIGNED BY: JLR	DRAWN BY: JLR
CHECKED BY: PVT. MGT.	SHEET 35 OF 63
11b026-35.i	