


6 INCH WHITE LINE
 MM 7.083 ~ 0.558 RT (SOLID)(EDGE LINE)
 MM 7.083 ~ 0.558 LT (DASHED)(12' LT)
 MM 7.083 ~ 0.558 LT (SOLID)(EDGE LINE)

6 INCH YELLOW LINE
 MM 7.083 ~ 0.558 CL (SOLID)(DBL)

MILLED RUMBLE STRIPS
 MM 7.083 ~ 0.558 CL
 MM 0.225 ~ 0.440 LT
 MM 7.083 ~ 0.558 RT

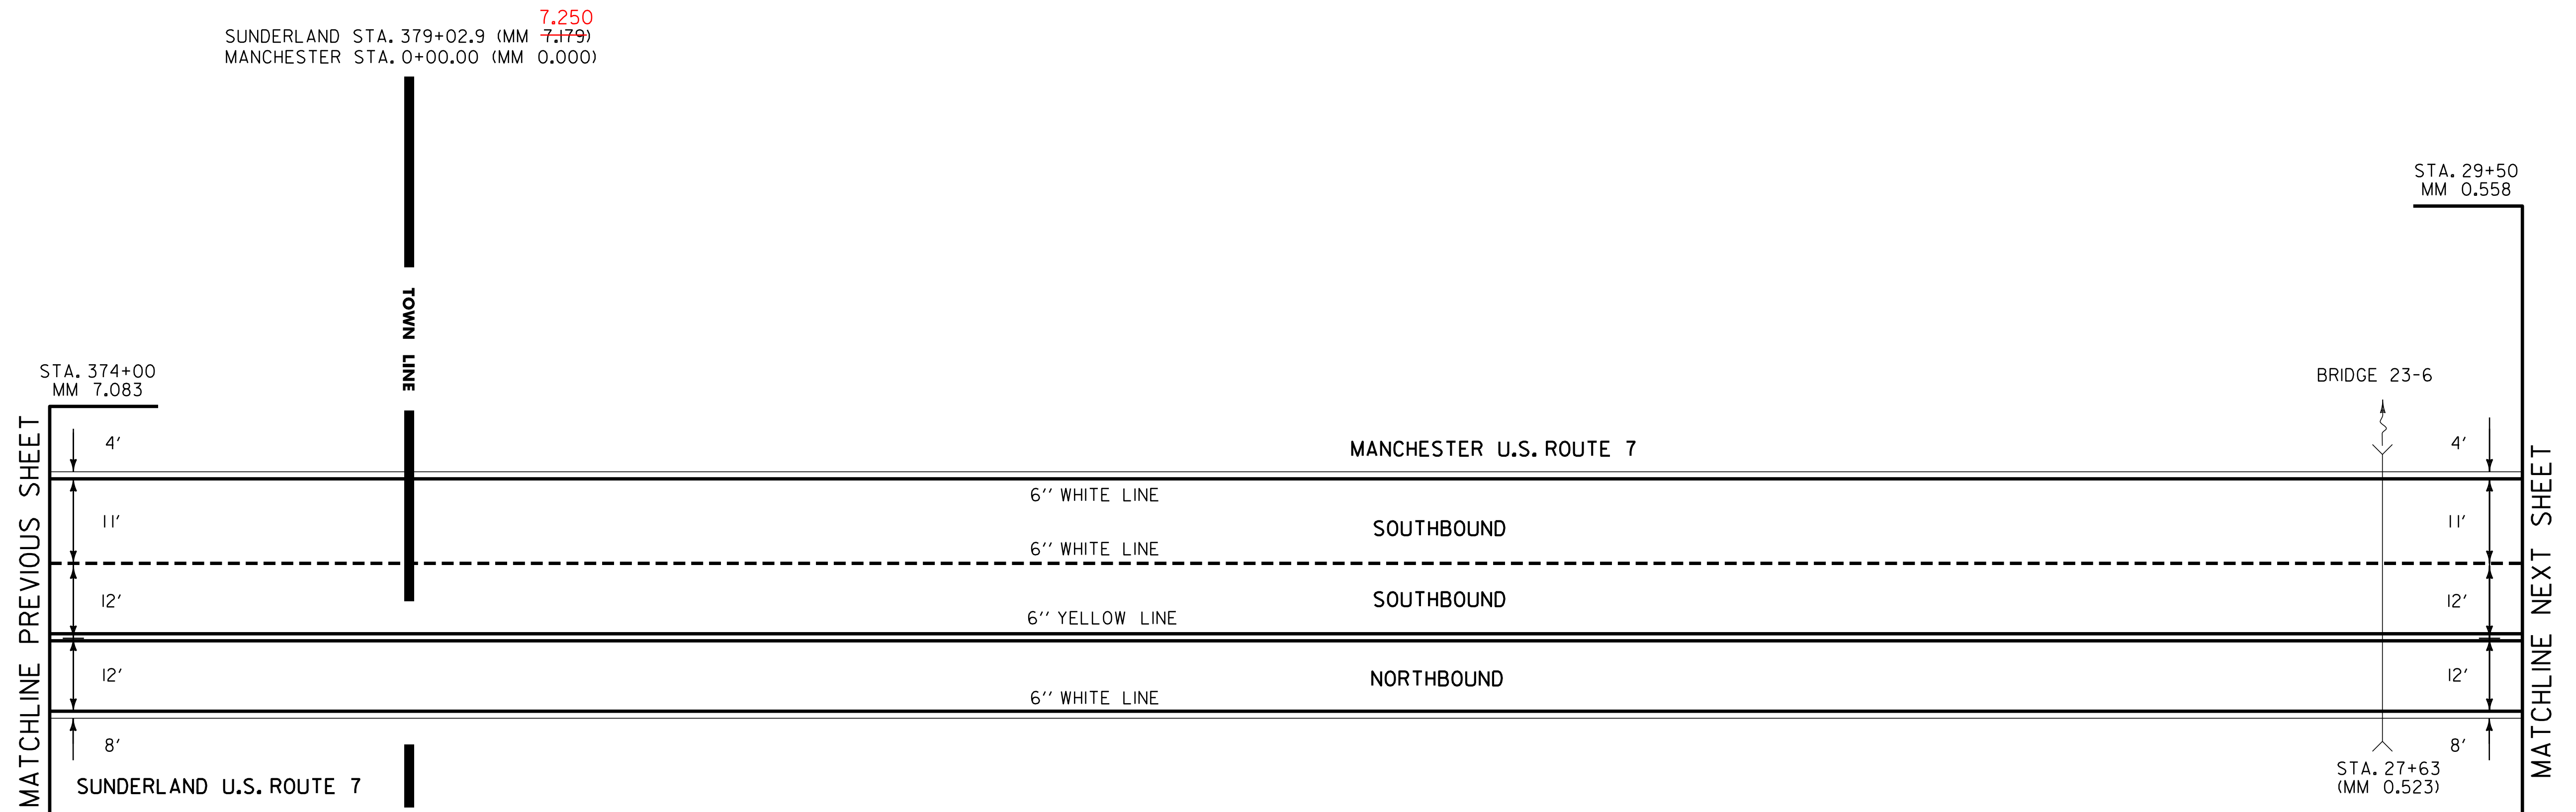

NOT TO SCALE

**PAVING
PROJECT
LAYOUT
#28**

PROJECT NAME: BENNINGTON-MANCHESTER
 PROJECT NUMBER: NH SURF(29)

FILE NAME: 11b026.dgn
 PROJECT LEADER: M. FOWLER
 DESIGNED BY: JLR
 11b026-37.i

PLOT DATE: 22-AUG-2013 14:34
 DRAWN BY: JLR
 CHECKED BY: PVT. MGT.
 SHEET 37 OF 63