


6 INCH WHITE LINE  
 MM 0.558 ~ 1.250 RT (SOLID)(EDGE LINE)  
 MM 0.558 ~ 1.250 LT (DASHED)(12' LT)  
 MM 0.558 ~ 1.250 LT (SOLID)(EDGE LINE)

6 INCH YELLOW LINE  
 MM 0.558 ~ 1.250 CL (SOLID)(DBL)

MILLED RUMBLE STRIPS  
 MM 0.558 ~ 1.250 CL  
 MM 0.750 ~ 0.900 LT  
 MM 1.110 ~ 1.250 LT  
 MM 0.558 ~ 1.250 RT

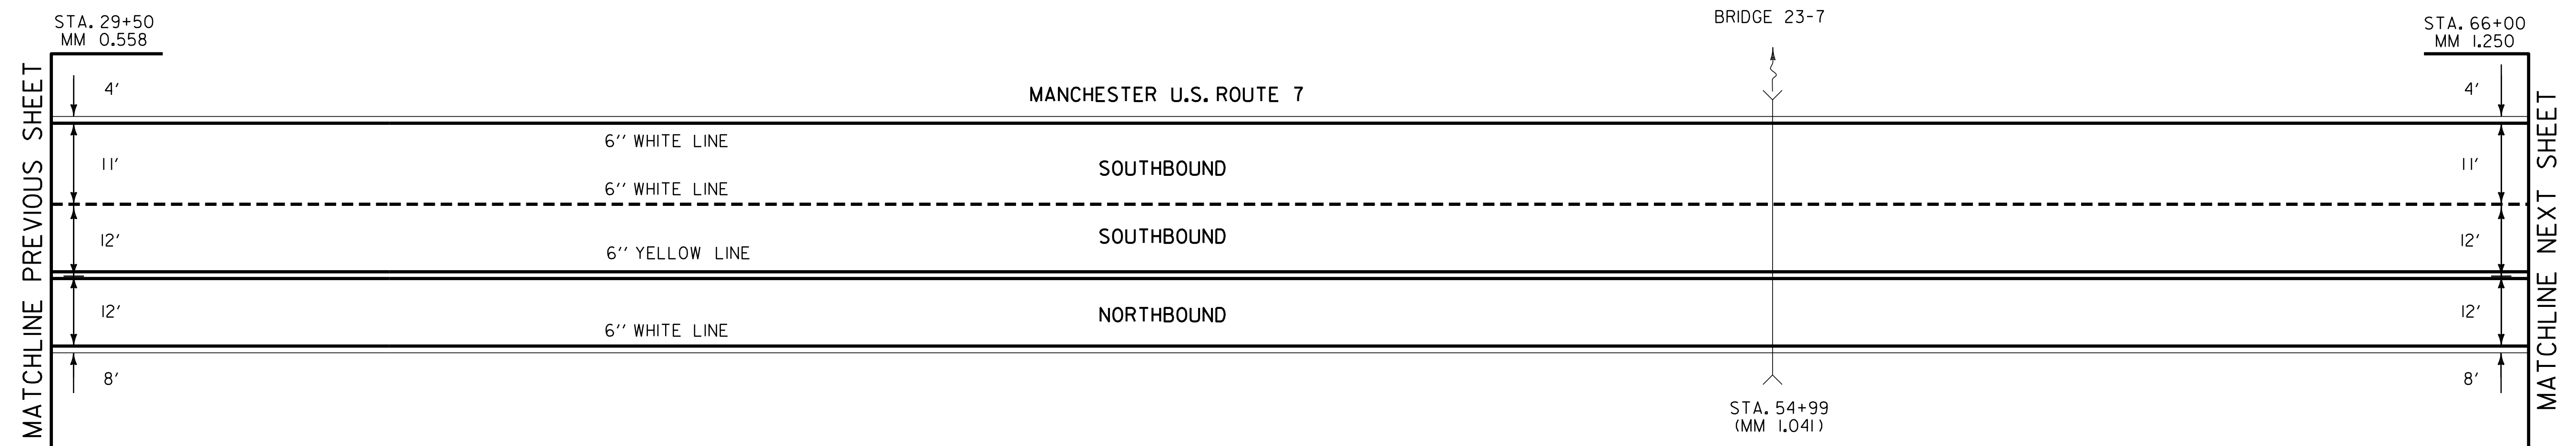

NOT TO SCALE

<b>PAVING PROJECT LAYOUT #29</b>	PROJECT NAME: BENNINGTON-MANCHESTER	FILE NAME: 11b026.dgn	PLOT DATE: 22-AUG-2013 14:34
	PROJECT NUMBER: NH SURF(29)	PROJECT LEADER: M. FOWLER	DRAWN BY: JLR
		DESIGNED BY: JLR	CHECKED BY:
		11b026-38.i	SHEET 38 OF 63