

6 INCH WHITE LINE


MM 2.614 ~ 3.295 RT (SOLID)(EDGE LINE)
 MM 2.614 ~ 3.295 LT (SOLID)(EDGE LINE)
 MM 2.614 ~ 2.717 LT (DASHED)(12' LT)

6 INCH YELLOW LINE

MM 2.614 ~ 2.770 CL (SOLID)(DBL)
 MM 2.770 ~ 2.850 CL (SOLID LT, DASH RT)
 MM 2.850 ~ 3.280 CL (DASHED)
 MM 3.280 ~ 3.295 CL (SOLID RT, DASH LT)

MILLED RUMBLE STRIPS

MM 2.614 ~ 3.295 CL
 MM 2.614 ~ 3.295 LT
 MM 2.614 ~ 3.255 RT
 MM 3.265 ~ 3.295 RT

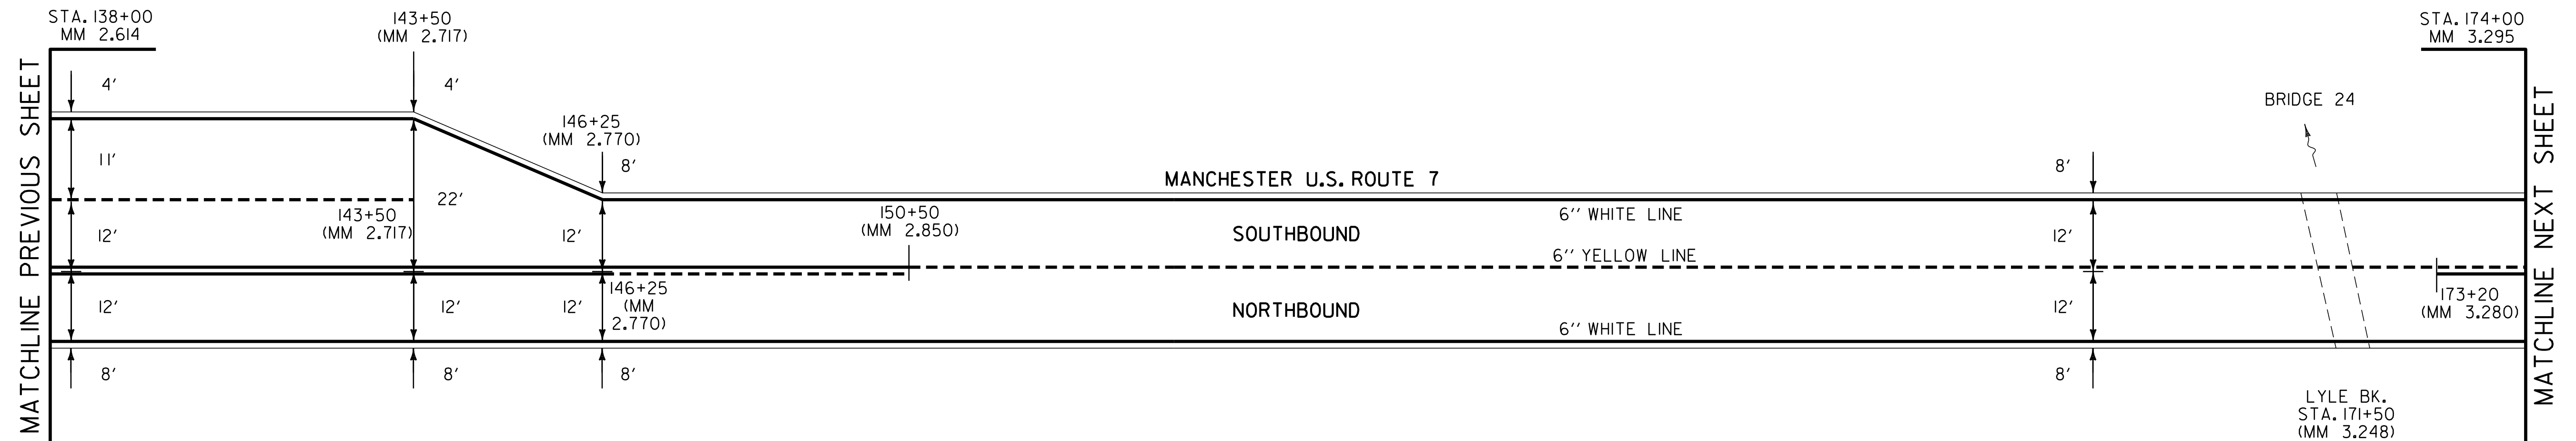

NOT TO SCALE

PAVING PROJECT LAYOUT #32	PROJECT NAME: BENNINGTON - MANCHESTER
	PROJECT NUMBER: NH SURF(29)
	FILE NAME: 11b026.dgn
	PLOT DATE: 22-AUG-2013 14:33
PROJECT LEADER: M. FOWLER	DRAWN BY: J. REDMOND
DESIGNED BY: J. REDMOND	CHECKED BY: PVT. MGT.
11b026-41.i	SHEET 41 OF 63