

4 INCH WHITE LINE
 STA 0+00 LT ~ 3+74 LT LANE LINE (SOLID)
 STA 0+00 LT ~ 4+35 LT EDGE LINE (SOLID)
 STA 3+74 LT ~ 4+35 LT LANE LINE (DASHED)
 STA 0+00 RT ~ 2+00 RT LANE LINE (DASHED)
 STA 0+00 RT ~ ~~4+35~~ RT EDGE LINE (SOLID) **4+80**

LETTER OR SYMBOL
 STA 0+00 LT (↵↑↶)
 STA 0+50 LT (ONLY, ONLY)
 STA 1+71 LT (ONLY, ONLY)
 STA 2+10 LT (↵↑↶)
 STA 3+34 LT (ONLY, ONLY)
 STA 3+74 LT (↵↑↶)
 STA 3+68 RT (↵)
 STA 4+08 RT (ONLY)
 STA **4+55 RT (↵↶) (3)**

TEMPORARY 4 INCH WHITE LINE
 STA 0+00 LT ~ 3+74 LT LANE LINE (SOLID)
 STA 0+00 LT ~ 4+35 LT EDGE LINE (SOLID)
 STA 3+74 LT ~ 4+35 LT LANE LINE (DASHED)
 STA 0+00 RT ~ 2+00 RT LANE LINE (DASHED)
 STA 0+00 RT ~ 4+35 RT EDGE LINE (SOLID)

TEMPORARY LETTER OR SYMBOL
 STA 0+00 LT (↵↑↶)
 STA 2+10 LT (↵↑↶)
 STA 3+74 LT (↵↑↶)
 STA 3+68 RT (↵)

TEMPORARY 4 INCH YELLOW LINE
 STA 0+00 ~ 1+87 LT-RT SINGLE (SOLID)
 STA 1+87 ~ 4+35 LT-RT DOUBLE (SOLID)
 (INCLUDES DIAGONALS)

TEMPORARY 24 INCH STOP BAR
 STA 0+00 LT



4 INCH YELLOW LINE
 STA 0+00 ~ 1+87 LT-RT SINGLE (SOLID)
~~STA 1+87 ~ 4+35 LT-RT DOUBLE (SOLID)~~
 (INCLUDES DIAGONALS)

8 INCH WHITE LINE
 STA 0+00 LT ~ 3+74 LT LANE LINE (SOLID)(12' LT)
 STA 3+74 LT ~ 4+35 LT LANE LINE (DOTTED)(12' LT)
 STA 2+00 RT ~ 3+68 RT LANE LINE (DOTTED)(12' RT)
 STA 3+68 RT ~ ~~4+35~~ RT LANE LINE (SOLID)(12' RT) **4+80**

TEMPORARY 8 INCH WHITE LINE
 STA 0+00 LT ~ 3+74 LT LANE LINE (SOLID)
 STA 3+74 LT ~ 4+35 LT LANE LINE (DOTTED)
 STA 2+00 RT ~ 3+68 RT LANE LINE (DOTTED)
 STA 3+68 RT ~ 4+35 RT LANE LINE (SOLID)

24 INCH STOP BAR
 STA 0+00 LT
 STA **4+80 RT**

PAINTED 8" YELLOW TO MATCH
 EXISTING FROM 4+35 TO 4+80 RT

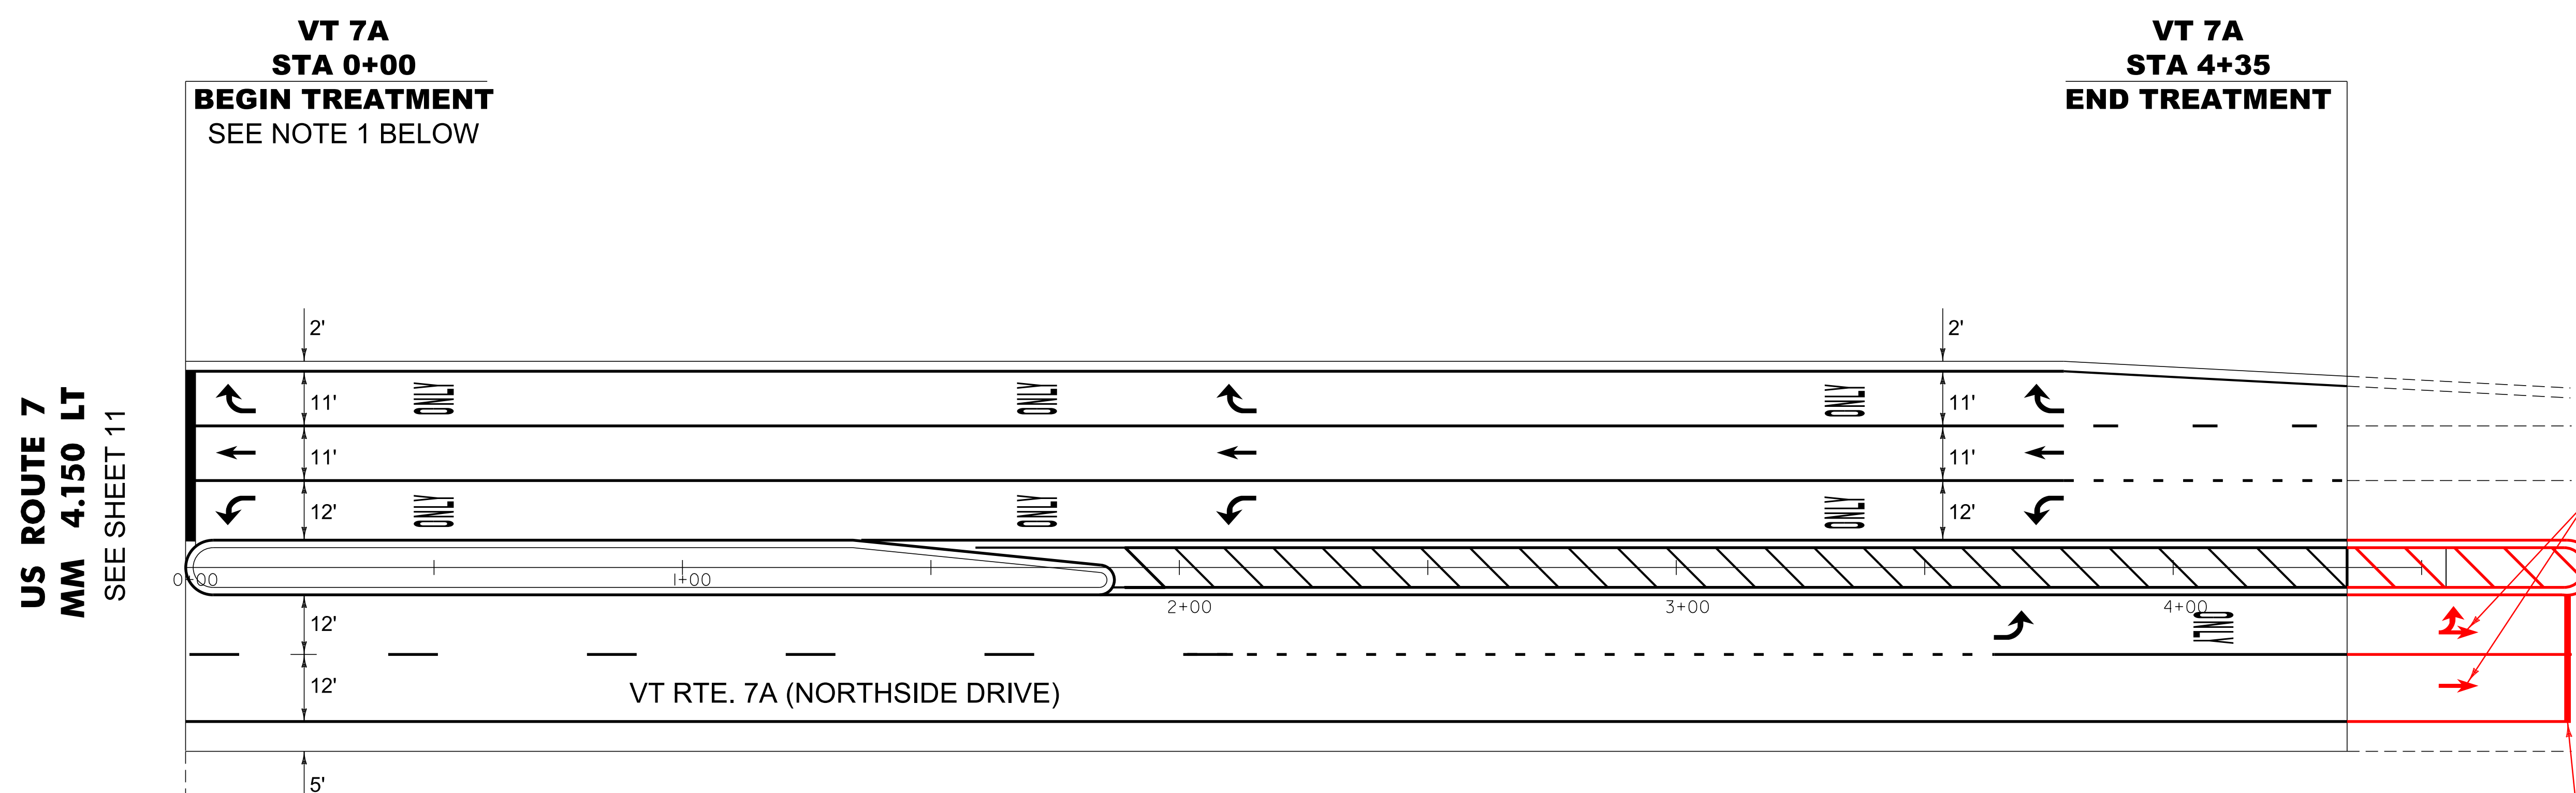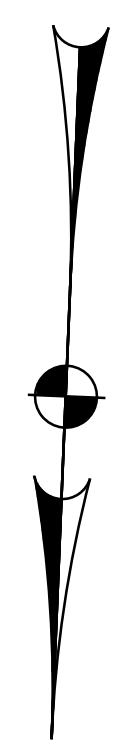

US ROUTE 7
MM 4.150 LT
 SEE SHEET 11

VT 7A
STA 0+00
BEGIN TREATMENT
 SEE NOTE 1 BELOW

VT 7A
STA 4+35
END TREATMENT

NOTE 1.
 COLD PLANE 1.5", PAVE WITH 1.5" TYPE IVS, APPLY ALTERNATE A OR B.
 TACK COAT APPLICATION:
 COLD PLANED SURFACE--0.080 GAL/SY SPECIAL PROVISION (EMULSIFIED ASPHALT) (RS-1H OR CRS-1H)
 ALL OTHER PAVED SURFACES--0.080 GAL/SY SPECIAL PROVISION (EMULSIFIED ASPHALT) (RS-1H OR CRS-1H)

NOT TO SCALE

PAVING PROJECT LAYOUT #35 (VT. RTE. 7A NORTHSIDE DR.)	PROJECT NAME: BENNINGTON-MANCHESTER	FILE NAME: iib026.dgn	PLOT DATE: 22-AUG-2013 14:33
	PROJECT NUMBER: NH SURF(29)	PROJECT LEADER: M. FOWLER	DRAWN BY: PVT. MGT.
		DESIGNED BY: PVT. MGT.	CHECKED BY: PVT. MGT.