

6 INCH YELLOW LINE

RAMP A STA. 6+90 TO STA. 13+48 SOLID LT.
 RAMP D STA. 5+70 TO STA. 23+95 SOLID LT.
 RAMP B STA. 0+55 TO STA. 8+60 SOLID LT.
 RAMP C STA. 9+85 TO STA. 24+80 SOLID LT.
 (WITH GAP AT LEFT TURN APPROACH
 TO VT. ROUTE 313)
 RAMP C ISLAND
 RAMP D ISLAND

6 INCH WHITE LINE



RAMP D STA. 5+70 TO STA. 31+33 SOLID RT.
 RAMP D STA. 26+85 TO STA. 27+85 DASHED LT.
 RAMP D ISLAND
 RAMP A STA. 0+00 TO STA. 13+58 SOLID RT.
 RAMP A STA. 0+00 TO STA. 4+95 DOTTED LT.
 RAMP B STA. 0+23 TO STA. 18+90 SOLID RT.
 RAMP B STA. 10+17 TO STA. 18+90 DOTTED LT.
 RAMP C STA. 0+00 TO STA. 24+80 SOLID RT.
 RAMP C STA. 0+00 TO STA. 6+20 DOTTED LT.
 RAMP C ISLAND

12 INCH WHITE LINE

RAMP A STA. 4+95 TO STA. 6+90 SOLID LT.
 RAMP D STA. 23+95 TO STA. 26+85 SOLID LT.
 RAMP D ISLAND GORE SOLID LT. AND RT.
 RAMP B STA. 8+60 TO STA. 10+17 SOLID LT.
 RAMP C STA. 6+20 TO STA. 9+85 SOLID LT.
 RAMP C ISLAND GORE SOLID LT. AND RT.

LETTER OR SYMBOL

RAMP A STA. 8+76 "STOP"
 RAMP A STA. 8+95 "AHEAD"
 RAMP A "STOP"
 RAMP C "STOP"
 RAMP A WRONG WAY ARROW
 RAMP C WRONG WAY ARROW
 RAMP C (V)(4)6
 RAMP D (V)(4)5
 RAMP C "STOP AHEAD" (9)
24 INCH STOP BAR
 RAMP A
 RAMP C

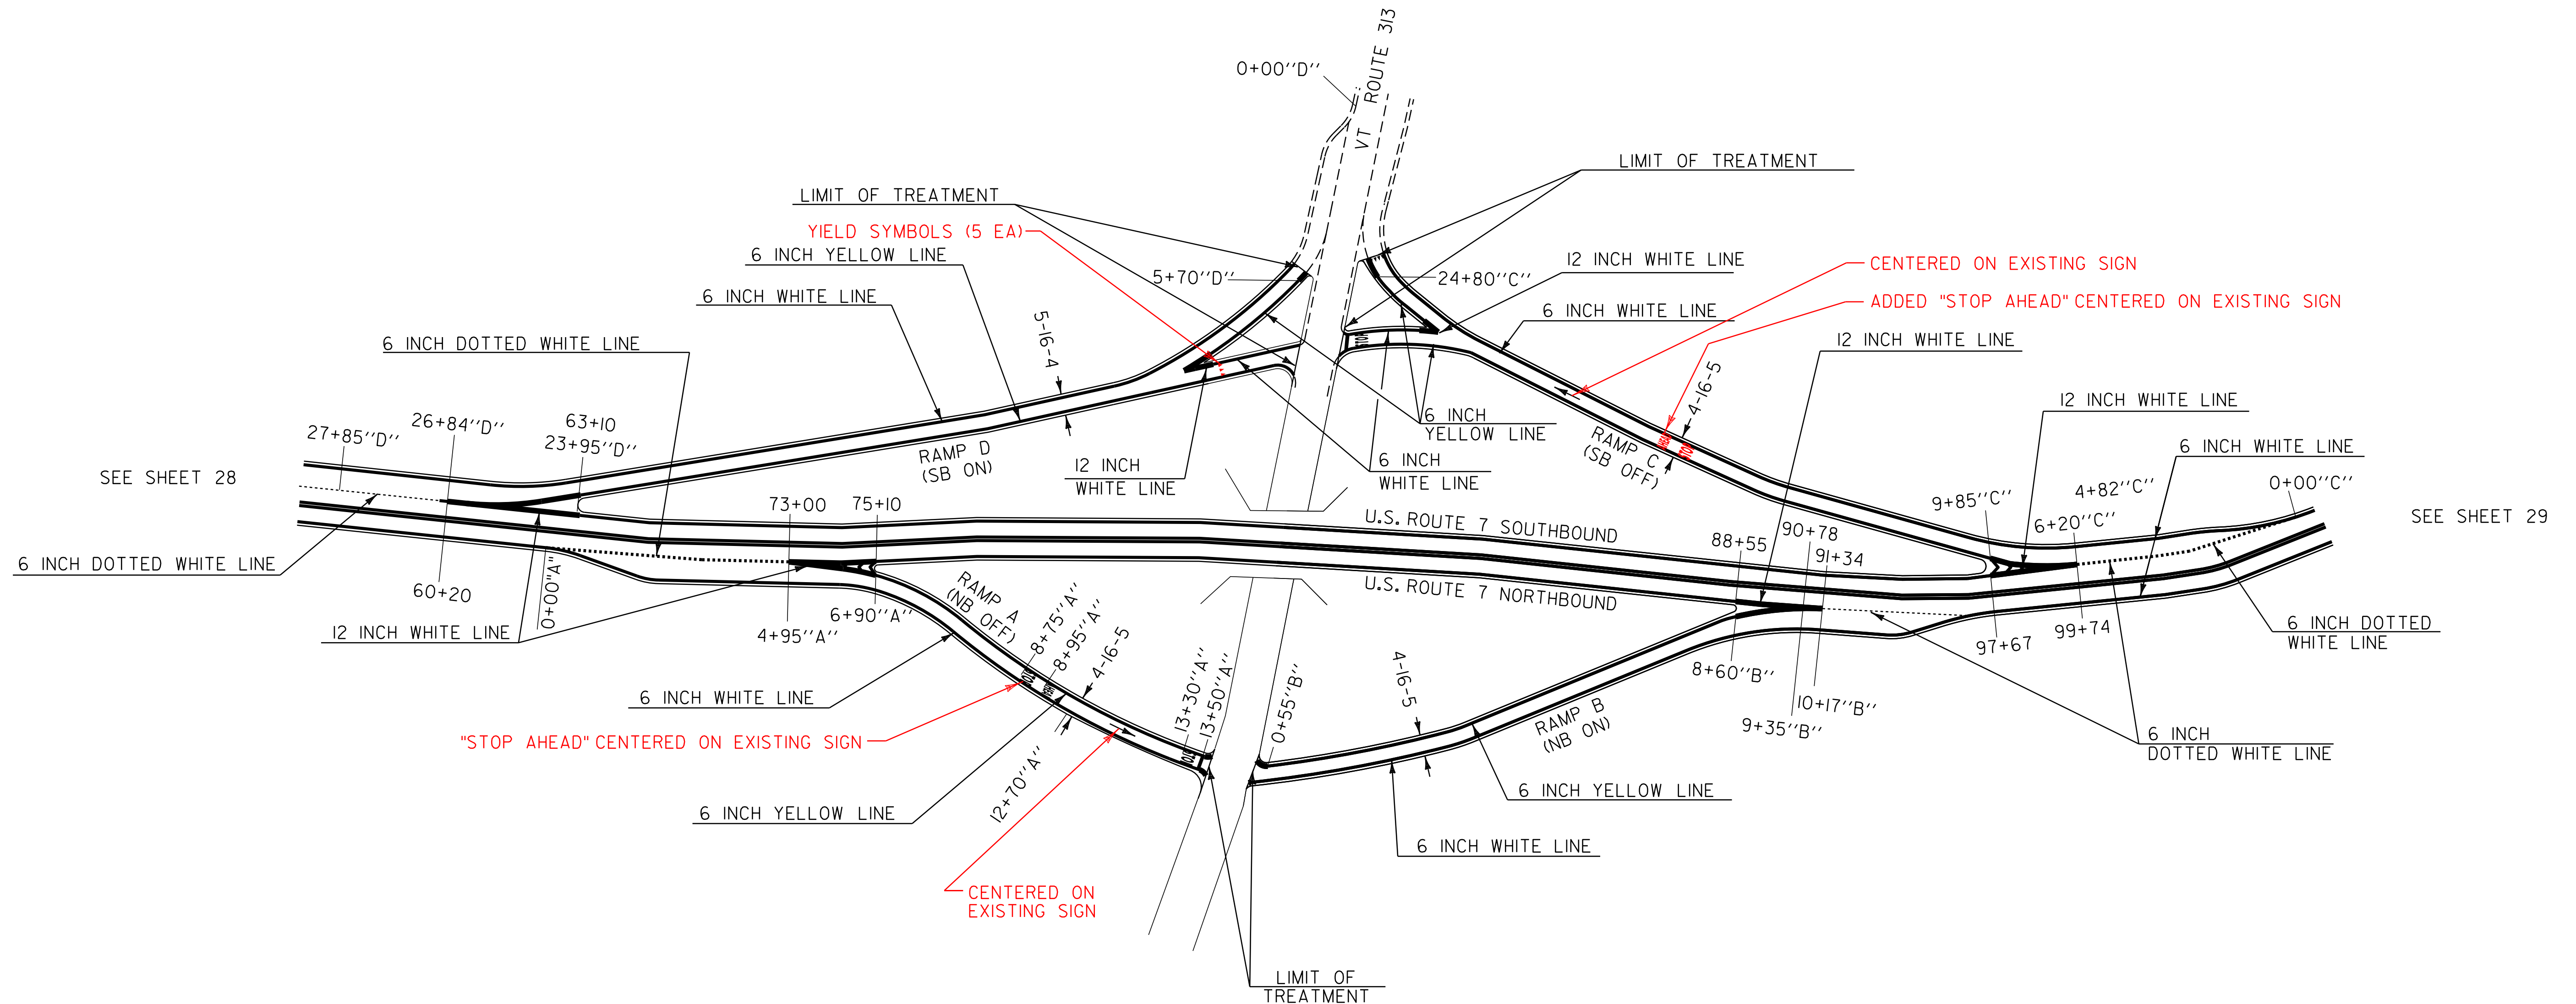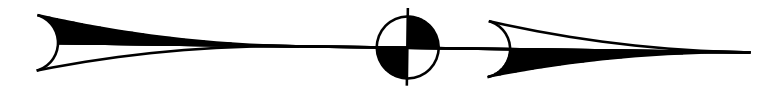

NOTE: FOR RAMP TREATMENT, APPLY ALTERNATE A OR B.
 FOR INTERCHANGE GORE DETAILS, SEE SHEETS 50 & 51.

ARLINGTON INTERCHANGE EXIT NO. 3

U.S. ROUTE 7 STA. 82+50 (MM 1.563)

NOT TO SCALE

**INTERCHANGE #3
 PAVEMENT
 MARKING
 LAYOUT**

PROJECT NAME: BENNINGTON-MANCHESTER

PROJECT NUMBER: NH SURF(29)

FILE NAME: 11b026.dgn
 PROJECT LEADER: M. FOWLER
 DESIGNED BY: JLR
 11b026-48.i

PLOT DATE: 22-AUG-2013 14:39
 DRAWN BY: JLR
 CHECKED BY: PVT. MGT.
 SHEET 48 OF 63