
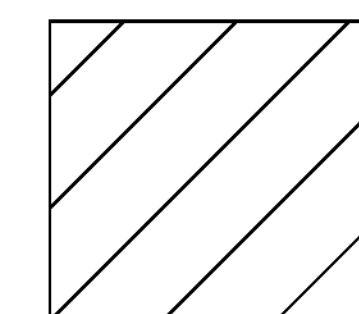


4 INCH WHITE LINE
MM 4.684 - MM 7.500 LT & RT
(WITH BREAKS OR RADIAT TOWN HIGHWAYS)

4 INCH YELLOW LINE
MM 4.684 - MM 6.050 SOLID LT & RT
MM 6.050 - MM 6.180 DASHED LT, SOLID RT
MM 6.180 - MM 7.500 SOLID LT & RT
(WITH CENTERLINE BREAKS AT TOWN HIGHWAYS)

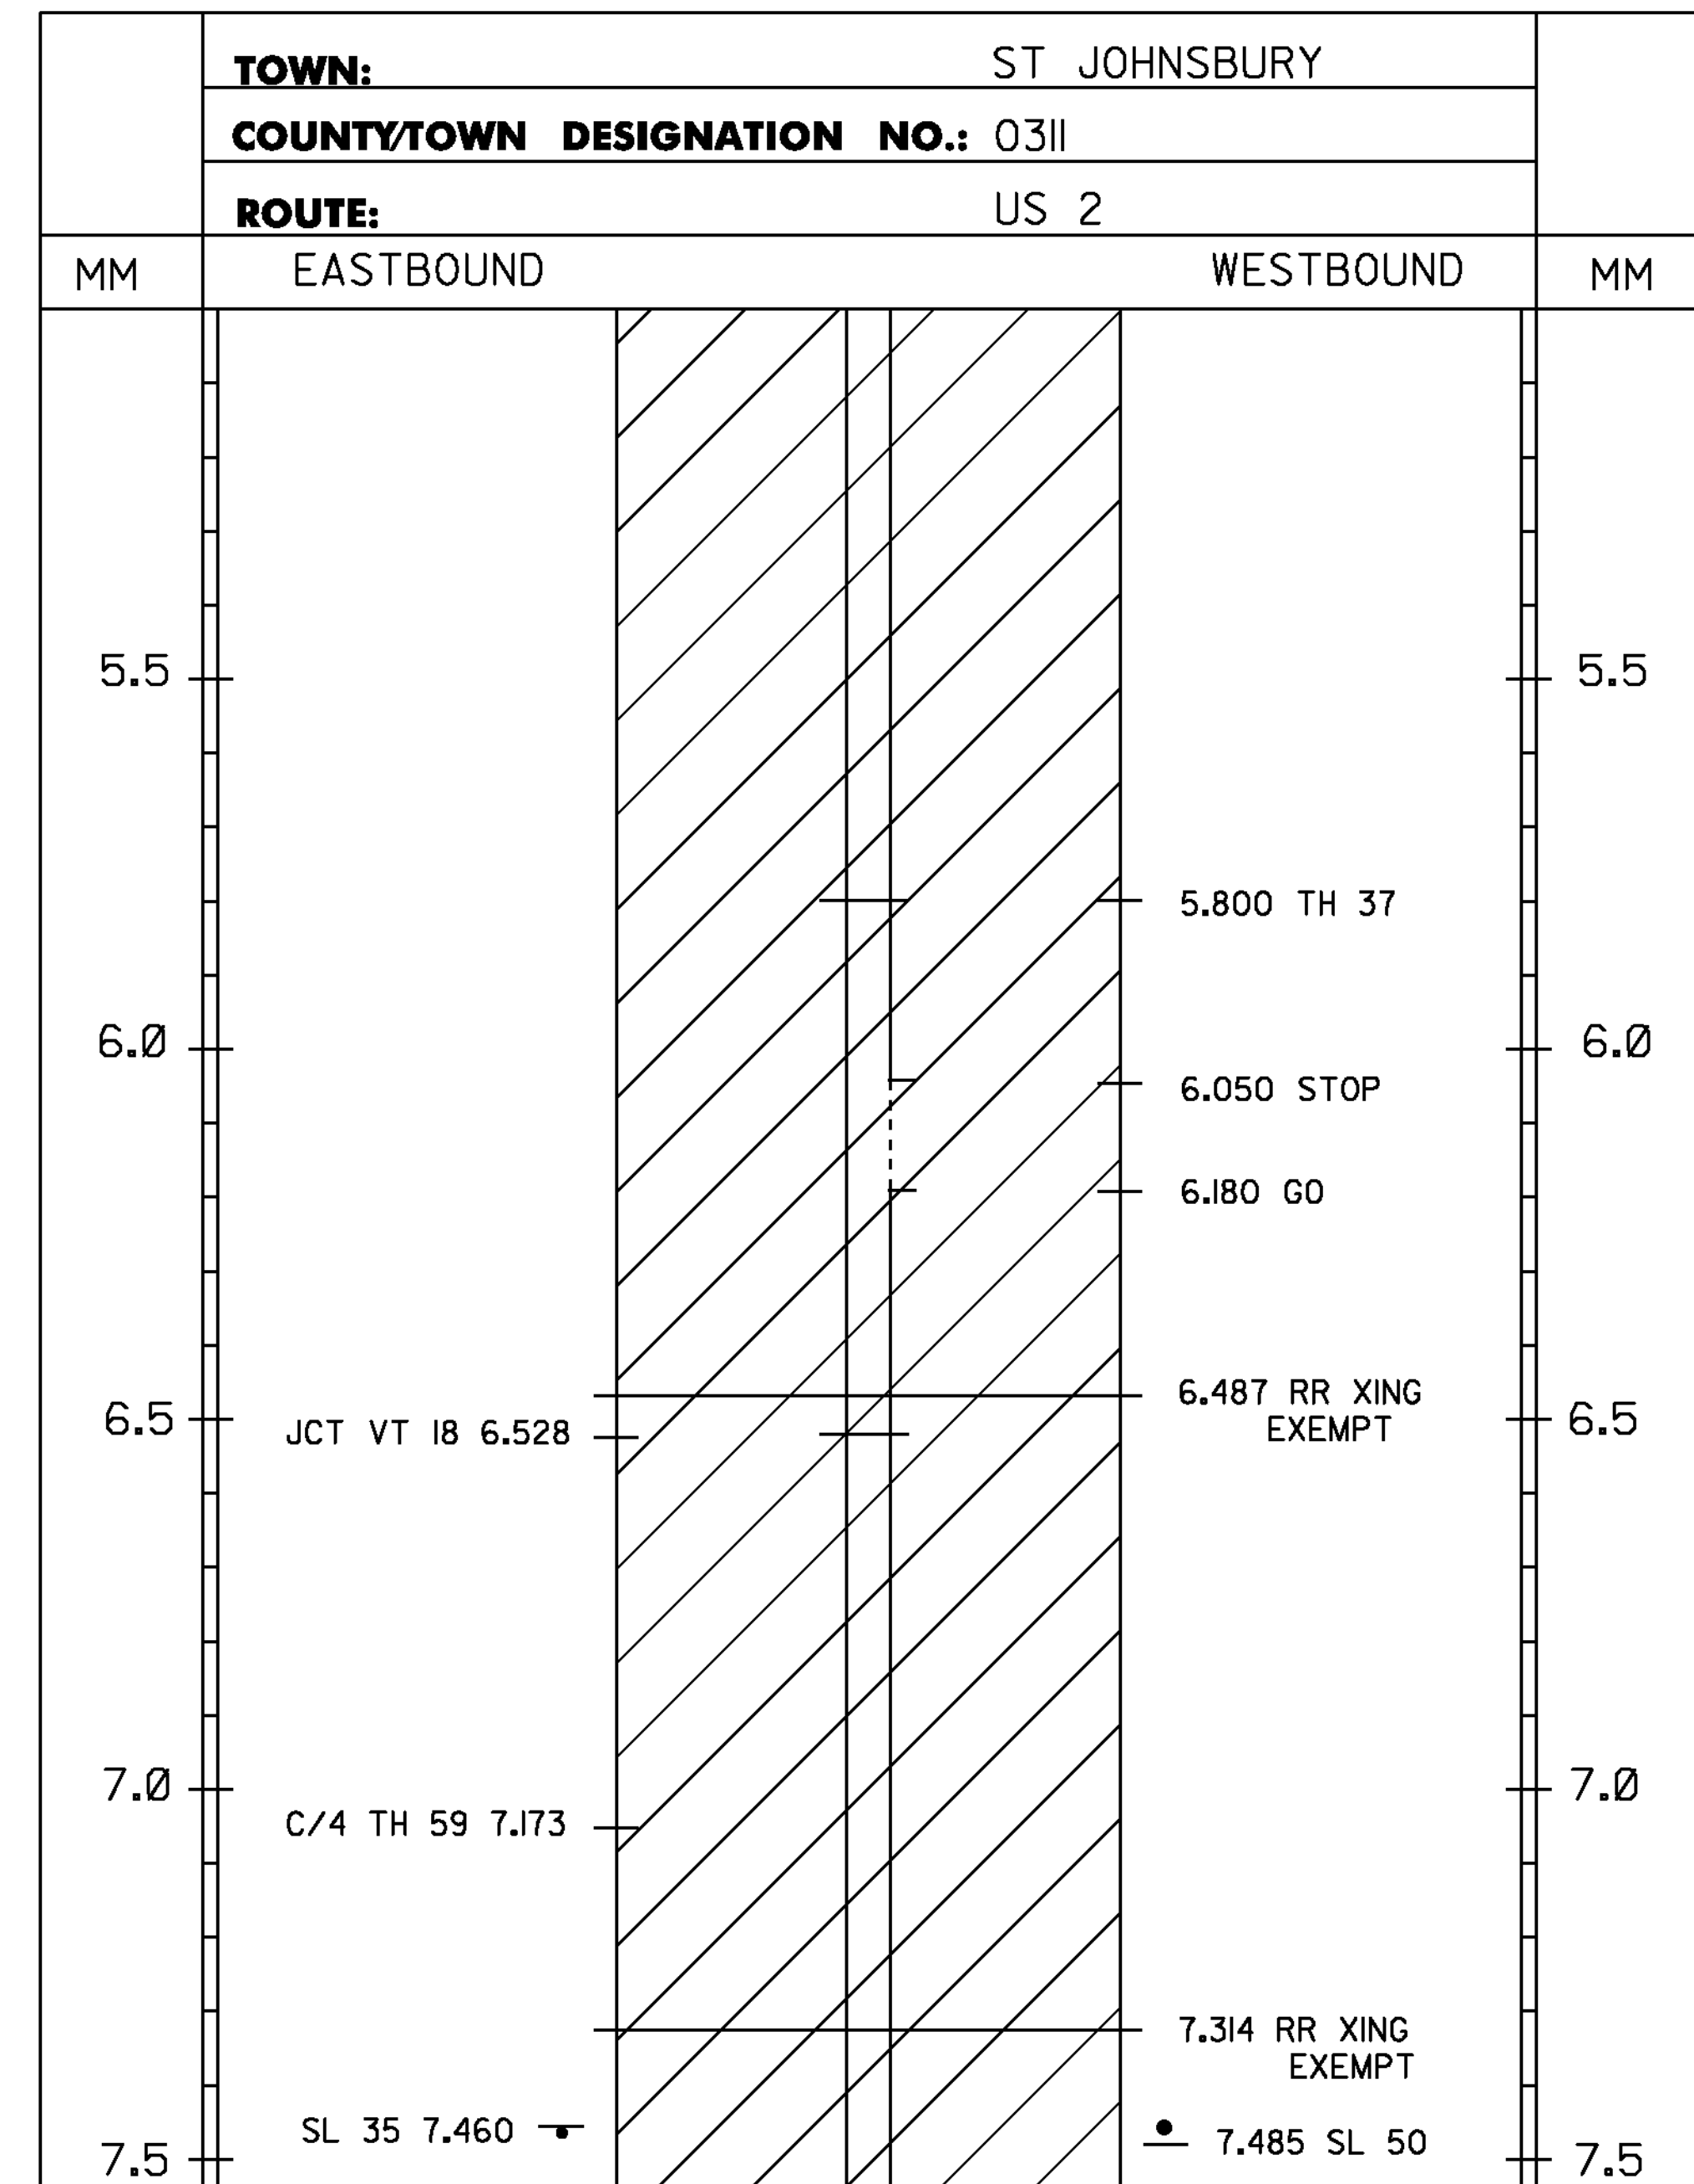

PROJECT AREA

LEGEND

TWBH-THROUGHWAY BEGINS HERE
TWEH-THROUGHWAY ENDS HERE
SHB-STATE HIGHWAY BEGINS
SHE-STATE HIGHWAY ENDS
SL-SPEED LIMIT
C/4 TH- CLASS 4 TOWN HIGHWAY
T/L-TOWN LINE

NOTES:
1. THIS SHEET TO BE USED FOR THE LAYOUT OF ALL CENTERLINE PAVEMENT MARKINGS.
THE RESIDENT ENGINEER MAY CONTACT KEITH SWEET, PAVEMENT MARKING SUPERVISOR
AT (802) 828-5573 FOR ASSISTANCE LAYING OUT THE CENTERLINE DURING CONSTRUCTION.

2. TWO (2) APPLICATIONS OF FINAL PAVEMENT MARKINGS WILL BE REQUIRED. SEE SPECIAL PROVISIONS
FOR COMPLETION DATE REQUIREMENTS.

NOT TO SCALE

**PROJECT
LAYOUT
SHEET #1**

PROJECT NAME:	ST. JOHNSBURY - GUILDHALL
PROJECT NUMBER:	NH SURF (32)
FILE NAME:	11b032\p11b032.dgn
PROJECT LEADER:	FOWLER
DESIGNED BY:	LOCKE
IPARM FILE NAME:	p11b032_07.1
PLOT DATE:	03-FEB-2012
DRAWN BY:	LOCKE
CHECKED BY:	PAVT MGMT
	SHEET 7 OF 22