


RUTTING DATA INFORMATION

US 2 St. Johnsbury-Guildhall NH SURF(32) Pre. Construction

Profiled 5-31-11

EB Lane Avg. Rut = 0.203". WB Lane Avg. Rut = 0.223"

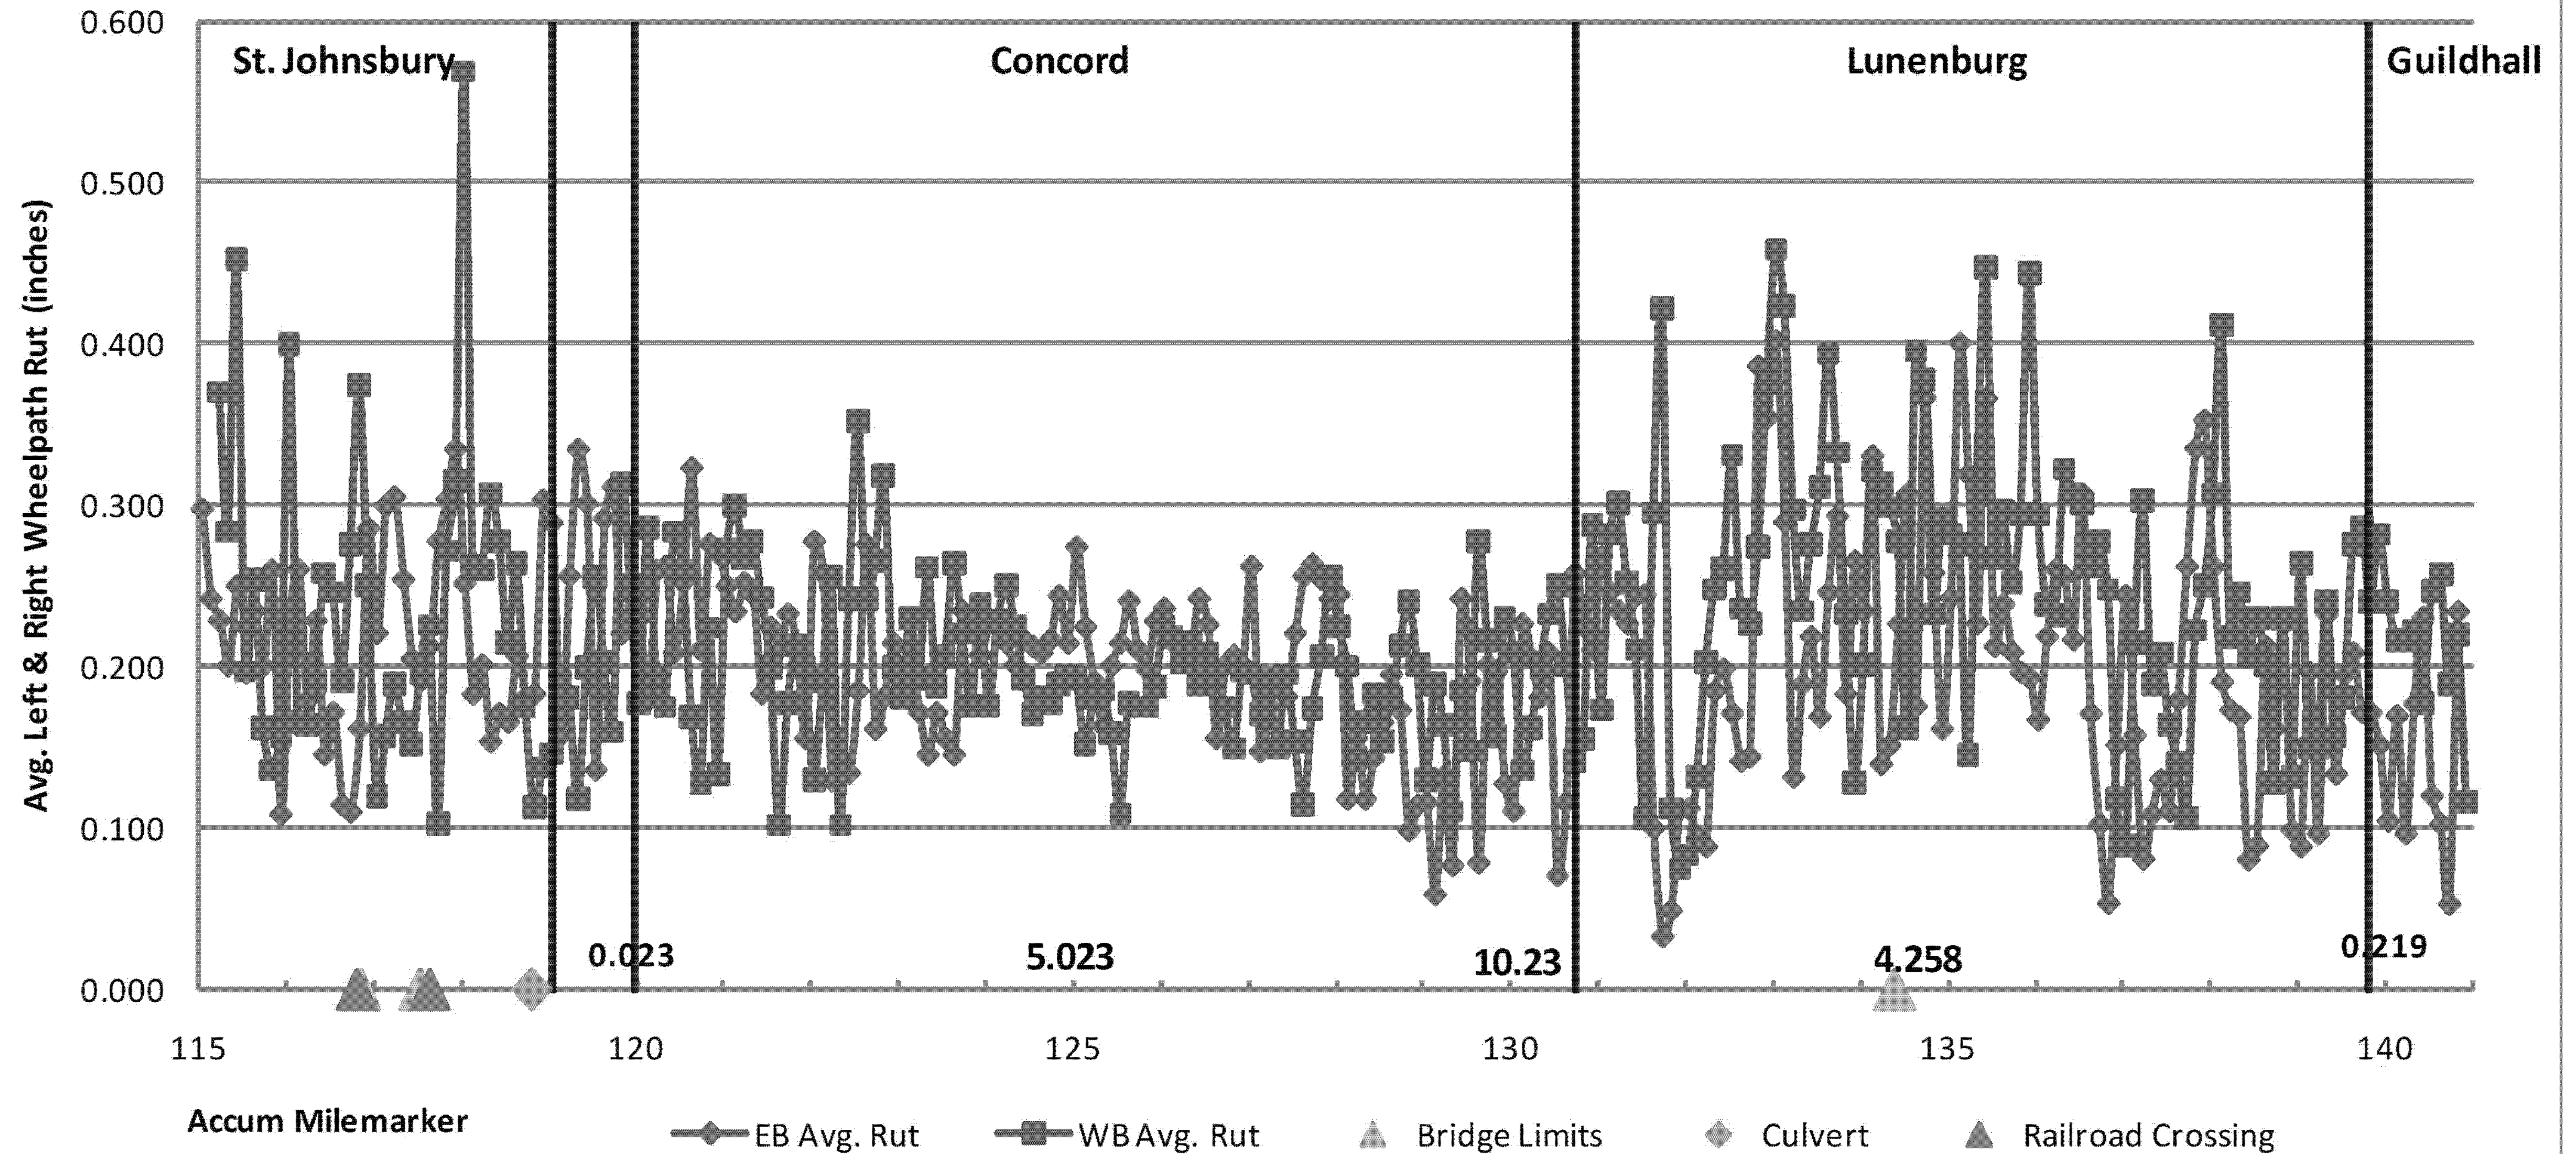

FOR INFORMATIONAL PURPOSES ONLY

**RUTTING
DATA
INFORMATION
SHEET**

PROJECT NAME:	ST. JOHNSBURY - GUILDHALL
PROJECT NUMBER:	NH SURF (32)
FILE NAME:	llb032\pllb032.dgn
PROJECT LEADER:	FWLER
DESIGNED BY:	LOCKE
IPARM FILE NAME:	pllb032_l6.1
PLOT DATE:	03-FEB-2012
DRAWN BY:	LOCKE
CHECKED BY:	PAVT MGMT
SHEET	16 OF 22