


**RAIL - HIGHWAY CROSSING TREATMENT DETAIL**

PAN AM RAILWAYS  
 AAR/DOT #364-714V RR MP 128.33 (US ROUTE 2 MM 6.487 ST. JOHNSBURY)  
 NOTE: EXISTING RAIL SEAL IS TO REMAIN

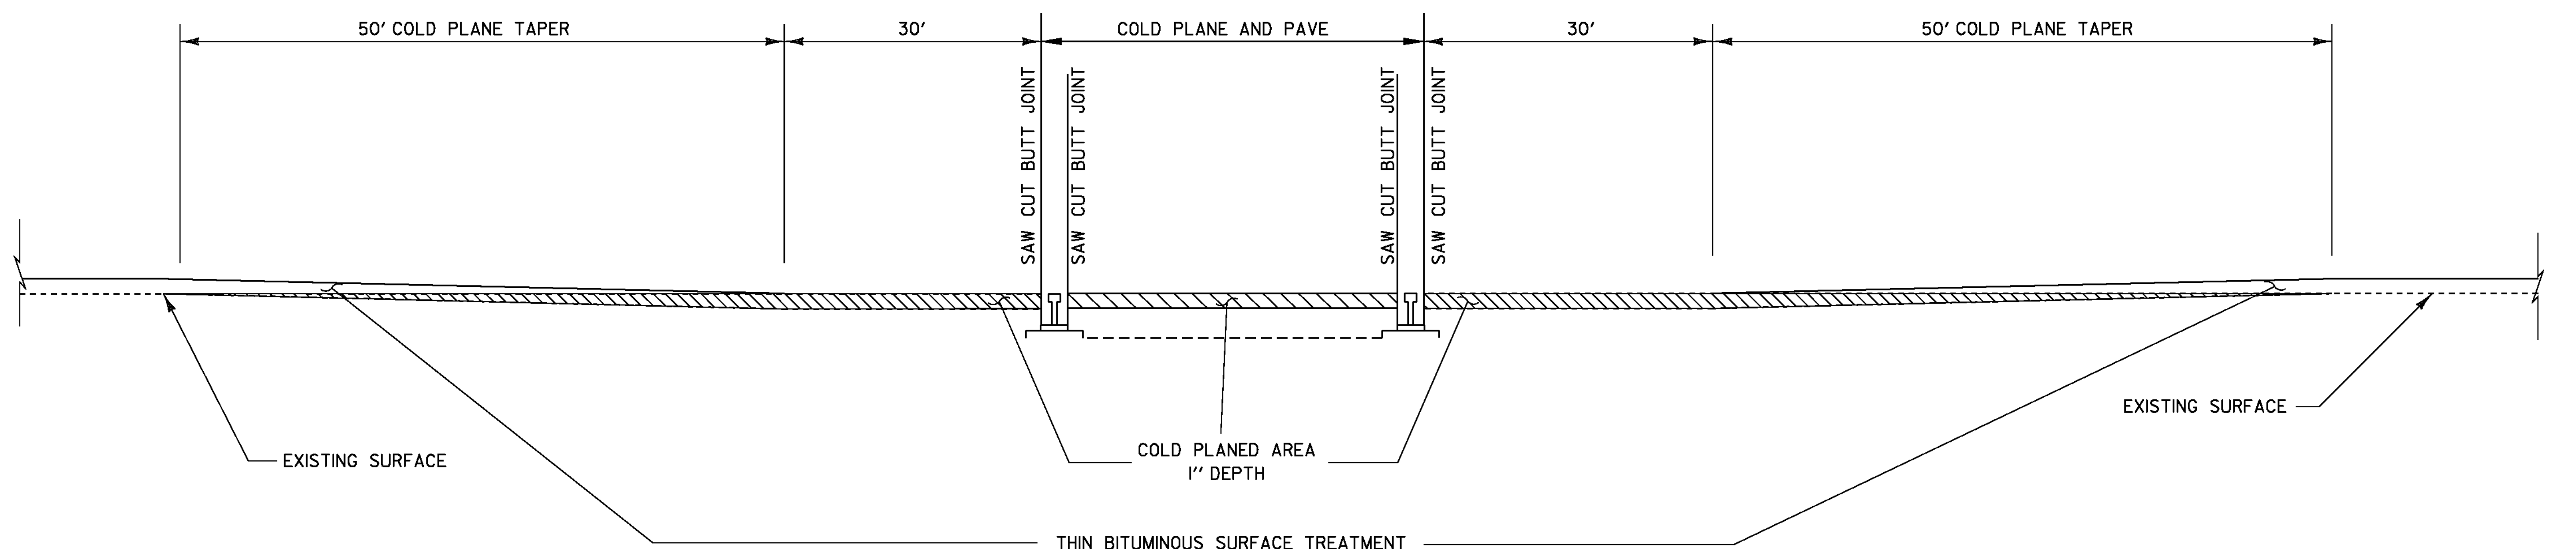

**RAIL - HIGHWAY CROSSING TREATMENT DETAIL**

PAN AM RAILWAYS  
 AAR/DOT #364-715C RR MP 127.50 (US ROUTE 2 MM 7.314 ST. JOHNSBURY)  
 NOTE: EXISTING RAIL SEAL IS TO REMAIN

**NOT TO SCALE**

<b>RAILROAD CROSSING DETAIL SHEET</b>	PROJECT NAME: ST. JOHNSBURY - GUILDHALL
	PROJECT NUMBER: NH SURF (32)
	FILE NAME: \\lb032\pllb032.dgn
	PLOT DATE: 03-FEB-2012
PROJECT LEADER: FOWLER	DRAWN BY: LOCKE
DESIGNED BY: LOCKE	CHECKED BY: PAVT MGMT
IPARM FILE NAME: pllb032_l8.1	SHEET 18 OF 22