
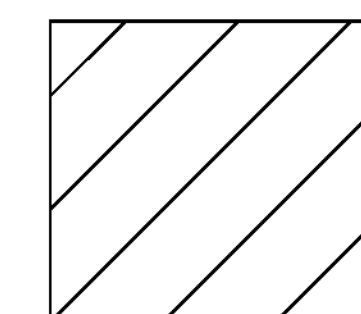


4 INCH WHITE LINE
MM 7.500 - MM 9.028 LT & RT
MM 0.000 - MM 1.149 LT & RT
(WITH BREAKS OR RADII AT TOWN HIGHWAYS)

4 INCH YELLOW LINE
MM 7.500 - MM 7.650 DASHED RT
MM 7.650 - MM 7.790 DASHED LT, SOLID RT
MM 7.790 - MM 9.028 SOLID LT & RT
MM 0.000 - MM 0.570 SOLID LT & RT
MM 0.570 - MM 0.700 SOLID LT, DASHED RT
MM 0.700 - MM 0.780 DASHED RT
MM 0.780 - MM 0.900 DASHED LT, SOLID RT
MM 0.900 - MM 1.149 SOLID LT & RT
(WITH CENTERLINE BREAKS AT TOWN HIGHWAYS)

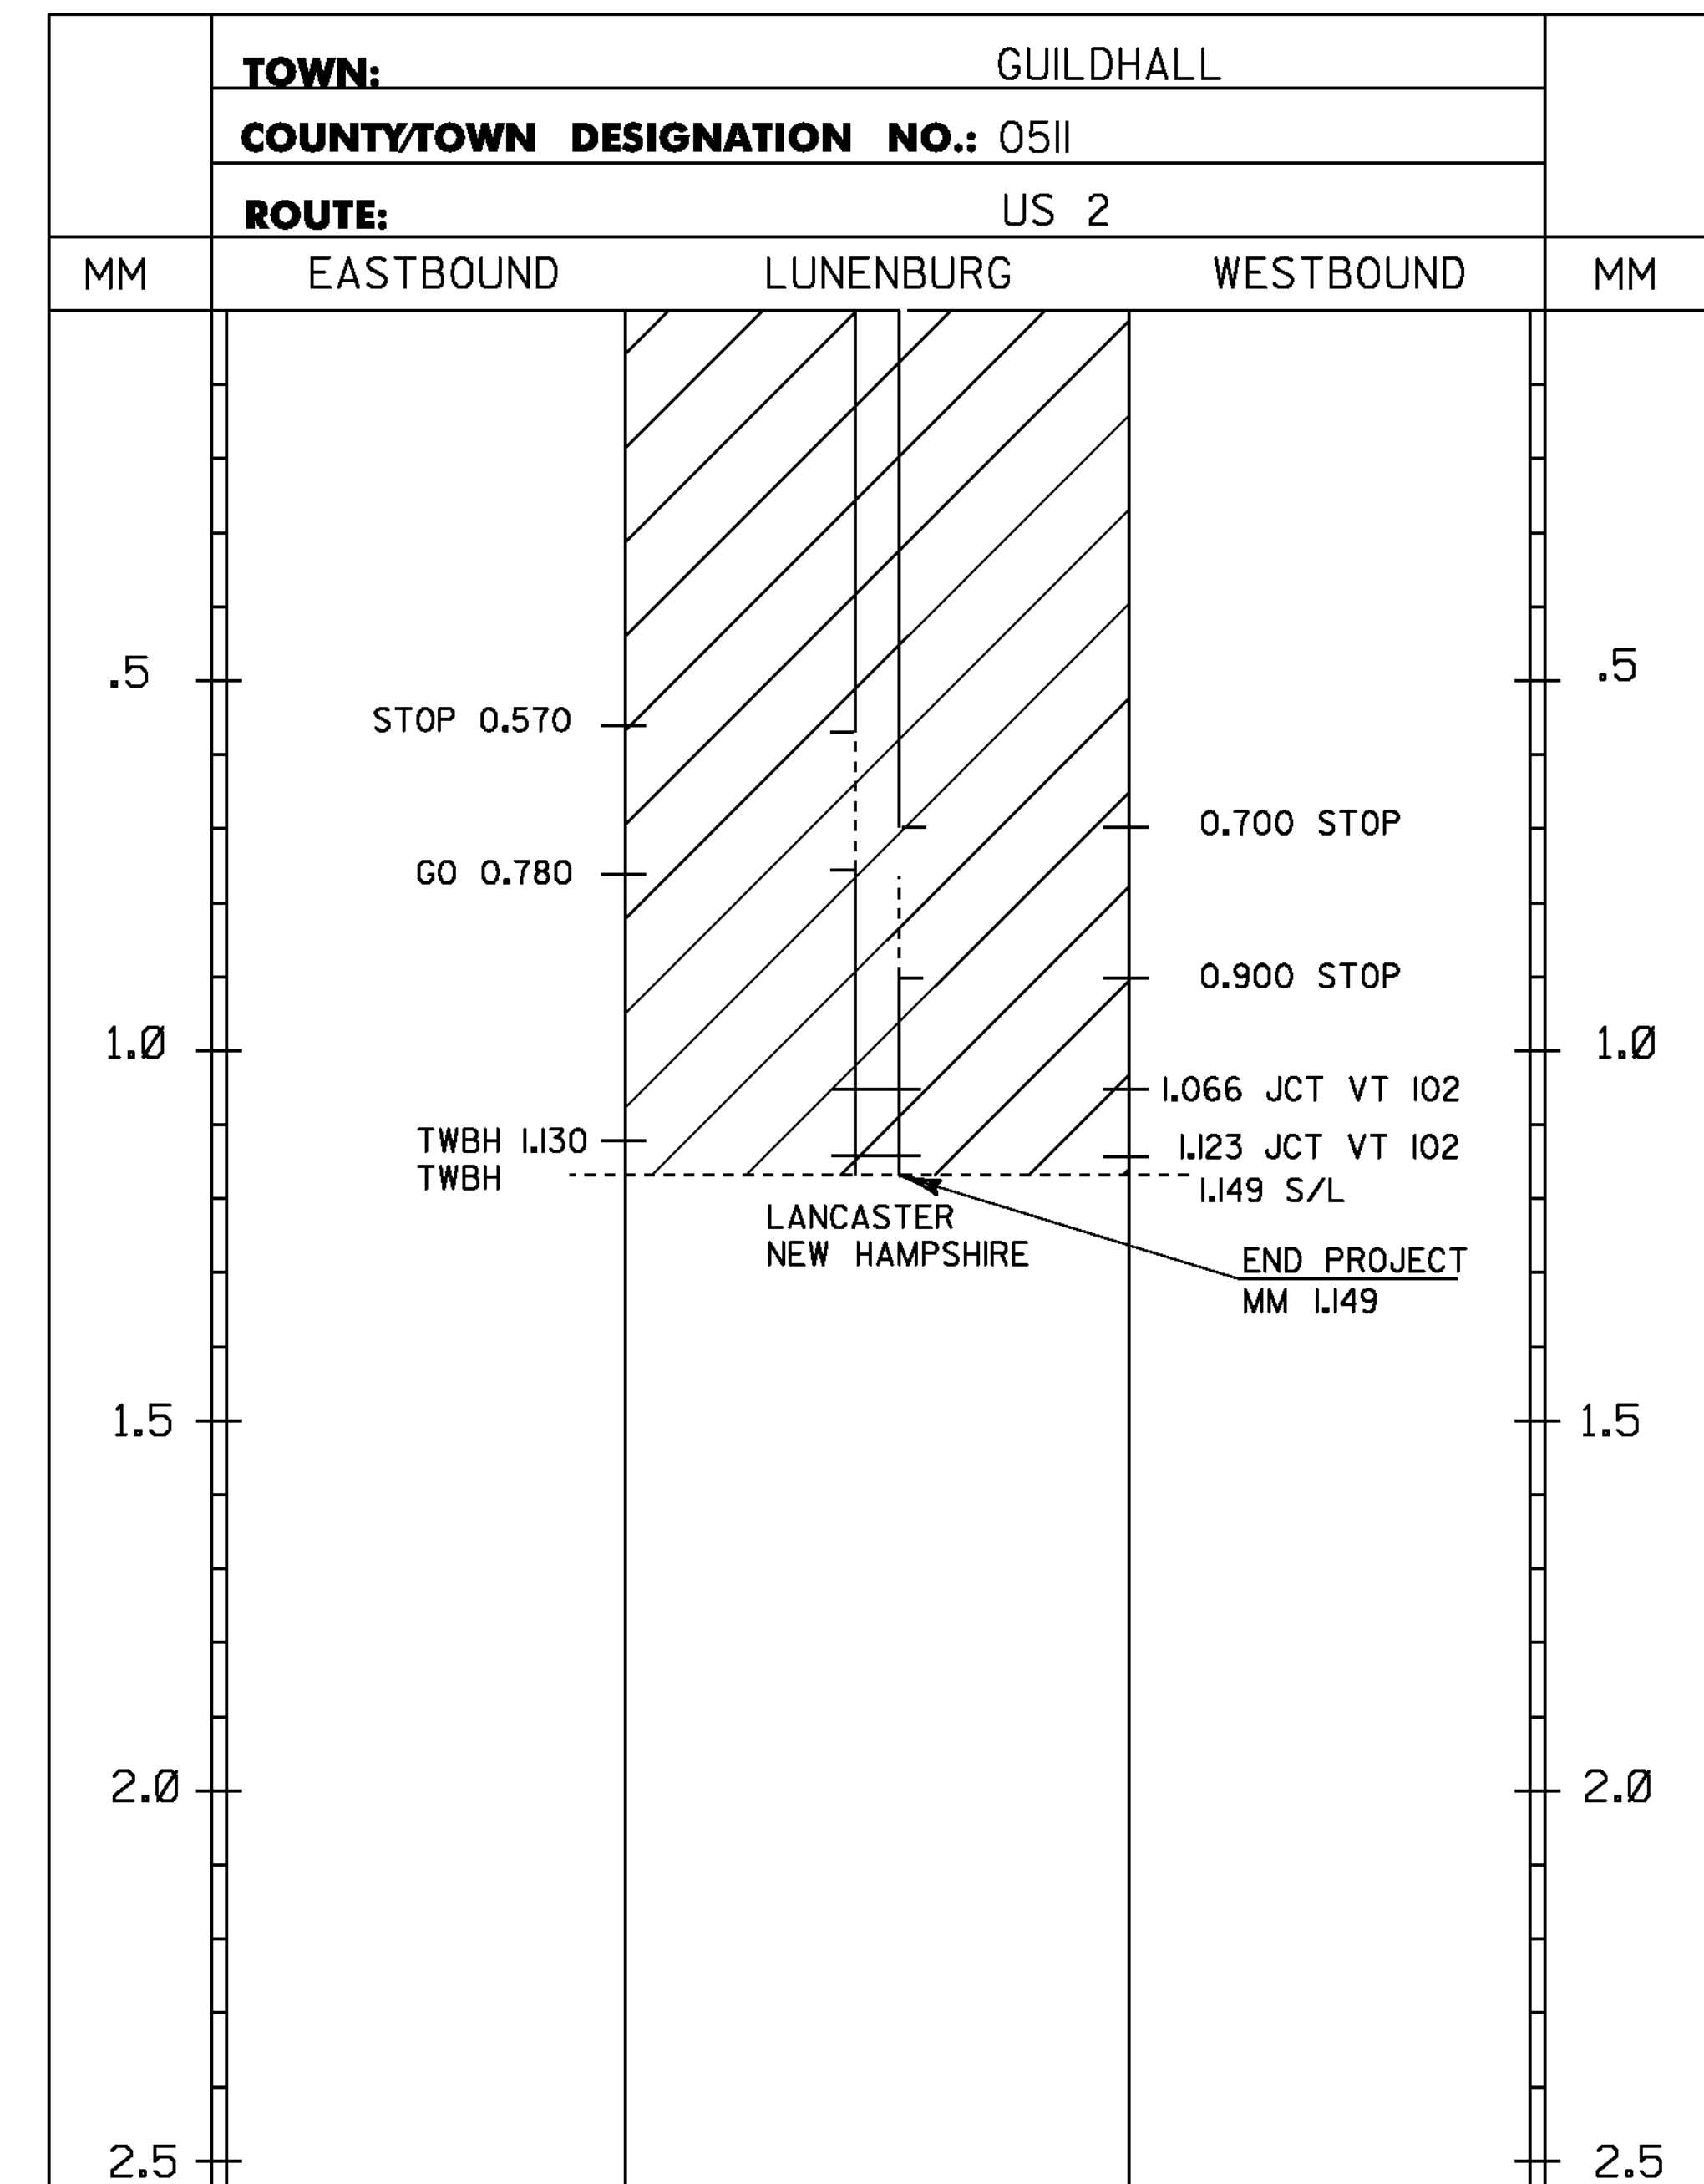

PROJECT AREA

LEGEND
TWBH-THROUGHWAY BEGINS HERE
TWEH-THROUGHWAY ENDS HERE
SHB-STATE HIGHWAY BEGINS
SHE-STATE HIGHWAY ENDS
SL-SPEED LIMIT
C/4 TH- CLASS 4 TOWN HIGHWAY
T/L-TOWN LINE

NOTES:
1. THIS SHEET TO BE USED FOR THE LAYOUT OF ALL CENTERLINE PAVEMENT MARKINGS. THE RESIDENT ENGINEER MAY CONTACT KEITH SWEET, PAVEMENT MARKING SUPERVISOR AT (802) 828-5573 FOR ASSISTANCE LAYING OUT THE CENTERLINE DURING CONSTRUCTION.
2. TWO (2) APPLICATIONS OF FINAL PAVEMENT MARKINGS WILL BE REQUIRED. SEE SPECIAL PROVISIONS FOR COMPLETION DATE REQUIREMENTS.

NOT TO SCALE

PROJECT LAYOUT SHEET #7

PROJECT NAME:	ST. JOHNSBURY - GUILDHALL
PROJECT NUMBER:	NH SURF (32)
FILE NAME:	I0b118\pl0b118.dgn
PROJECT LEADER:	FOWLER
DESIGNED BY:	LOCKE
IPARM FILE NAME:	plb032_13.1
PLOT DATE:	03-FEB-2012
DRAWN BY:	LOCKE
CHECKED BY:	PAVT MGMT
	SHEET 13 OF 22