

4 INCH WHITE LINE  
MM 6.462 - MM 6.587 LT & RT  
(WITH RADIAT INTERSECTIONS)  
MM 6.538 RT (EDGE LINES VT 18)


4 INCH YELLOW LINE  
MM 6.462 - MM 6.587 LT & RT  
(WITH BREAKS AT INTERSECTIONS)  
MM 6.538 RT (CENTERLINE VT 18)

8 INCH WHITE LINE  
MM 6.524 - MM 6.536 RT

8 INCH YELLOW LINE  
MM 6.538 RT

24 INCH STOP BAR  
MM 6.540 - MM 6.546 RT (VT 18)

LETTER OR SYMBOL  
MM 6.534 RT (YIELD SYMBOLS - 5 EA)  
MM 6.541 RT (STOP - VT 18)  
MM 6.544 RT (STOP - VT 18)

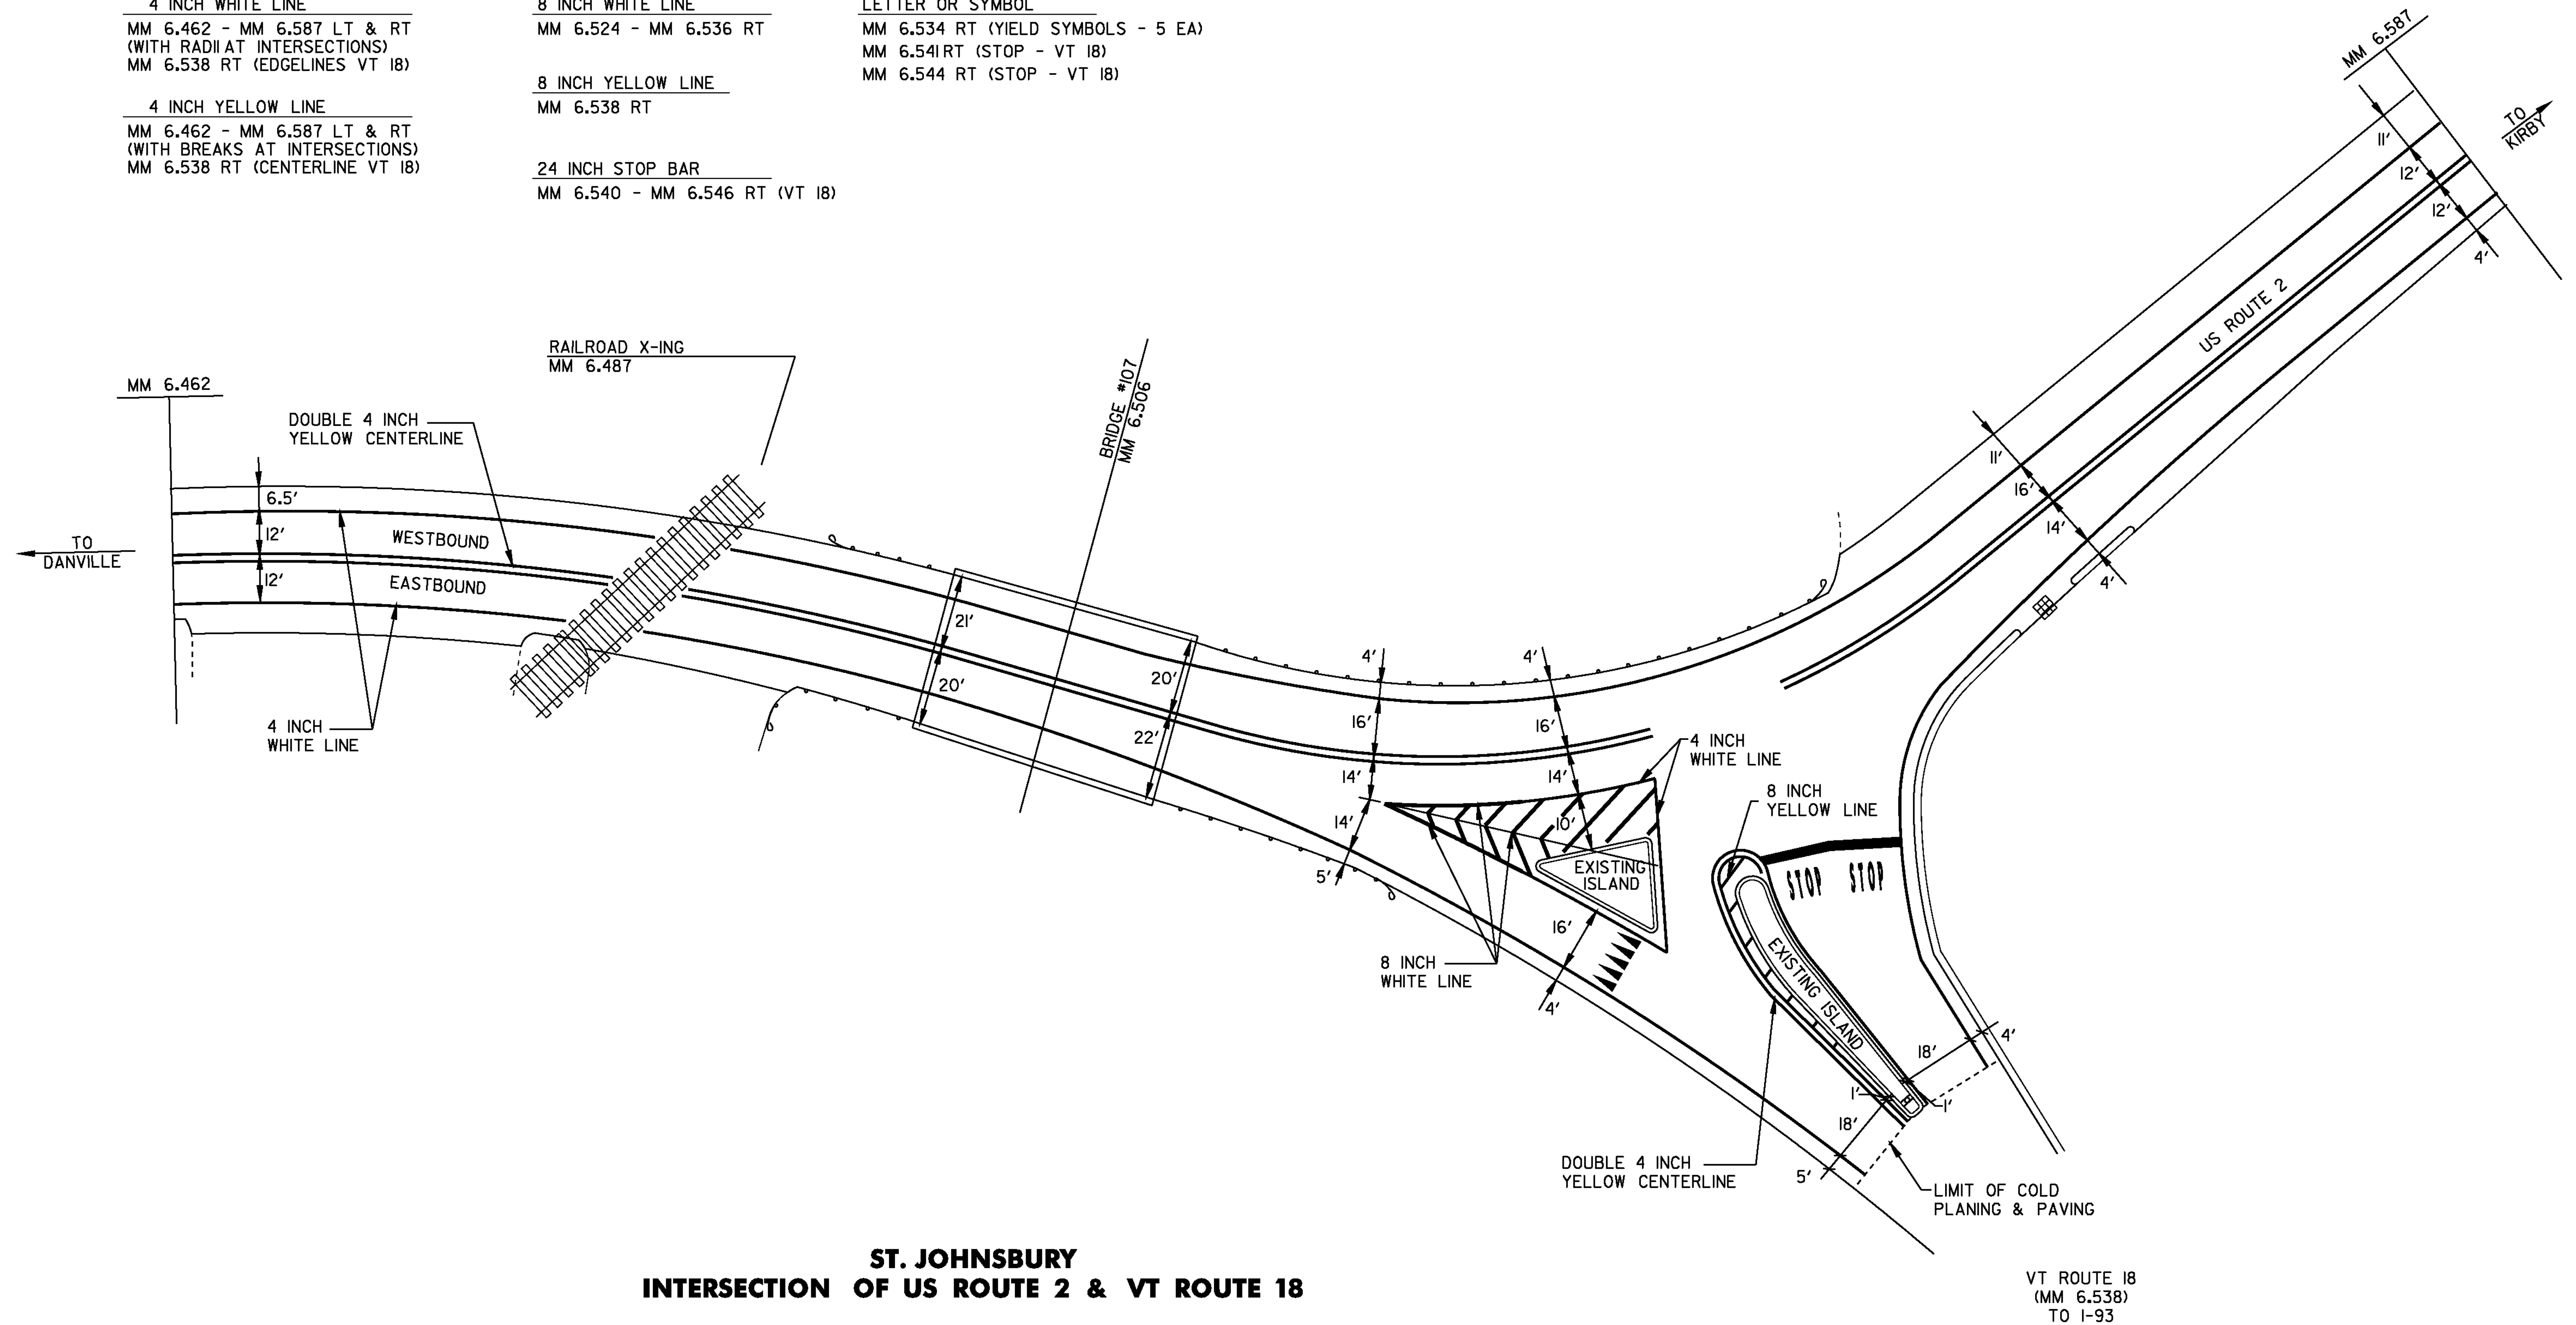

NOT TO SCALE

PROJECT  
LAYOUT  
SHEET #8

PROJECT NAME: ST. JOHNSBURY - GUILDHALL  
PROJECT NUMBER: NH SURF (32)

FILE NAME: I0b118\pi0b118.dgn  
PROJECT LEADER: FOWLER  
DESIGNED BY: LOCKE  
IPARM FILE NAME: pllb032\_14.1

PLOT DATE: 03-FEB-2012  
DRAWN BY: LOCKE  
CHECKED BY: PAVT MGMT  
SHEET 14 OF 22