

SOIL INFORMATION:  
 TACONIC-MACOMBER COMPLEX  
 K-FACTOR = .37/.32, 8%-25% SLOPES  
 HYDROLOGICAL SOIL GROUP: D  
 VERY ROCKY

SOIL INFORMATION:  
 KINGSBURY SILTY CLAY LOAM  
 K-FACTOR = .49, 0%-3% SLOPES  
 HYDROLOGICAL SOIL GROUP: D

MATCHLINE STA 280+25.00

STA 283+00.00  
 END PROJECT  
 STP 015-2(9)  
 BEGIN APPROACH


STA 283+75.00  
 BEGIN COLD PLANE

STA 284+25.00  
 END COLD PLANE  
 END APPROACH

PT  
 STA 284+43.78

POE  
 STA 285+05.73

PC  
 STA 283+64.96

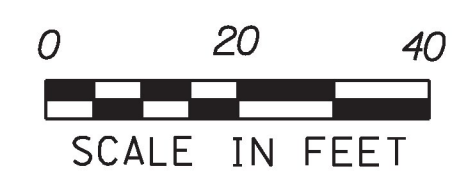

PROJECT NAME: POULTNEY	PLOT DATE: 23-AUG-2018
PROJECT NUMBER: STP 015-2(9)	DRAWN BY: S. ZWICK
FILE NAME: dl1b048ero.dgn	CHECKED BY: C. LEACH
DESIGNED BY: S. ZWICK	SHEET 30 OF 48
EPSC EXISTING CONDITIONS PLAN SHEET 2	