

TEMPORARY 4 INCH WHITE LINE

275+50 STA 276+75 - STA 280+25 LT (SOLID)
 STA 276+75 - STA 280+25 RT (SOLID)
 275+50

TEMPORARY 4-INCH YELLOW LINE




275+50 STA 276+75 - STA 280+25 LT (SOLID)
 STA 276+75 - STA 280+25 RT (SOLID)
 275+50

DURABLE 4 INCH WHITE LINE, WATERBORNE, SEE OPTION ITEMS

275+50 STA 276+75 - STA 280+25 LT (SOLID)
 STA 276+75 - STA 280+25 RT (SOLID)
 275+50

DURABLE 4-INCH YELLOW LINE, WATERBORNE, SEE OPTION ITEMS

275+50 STA 276+75 - STA 280+25 LT (SOLID)
 STA 276+75 - STA 280+25 RT (SOLID)
 275+50

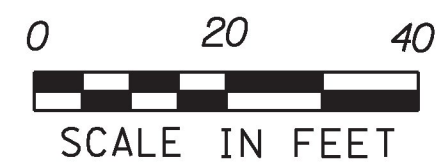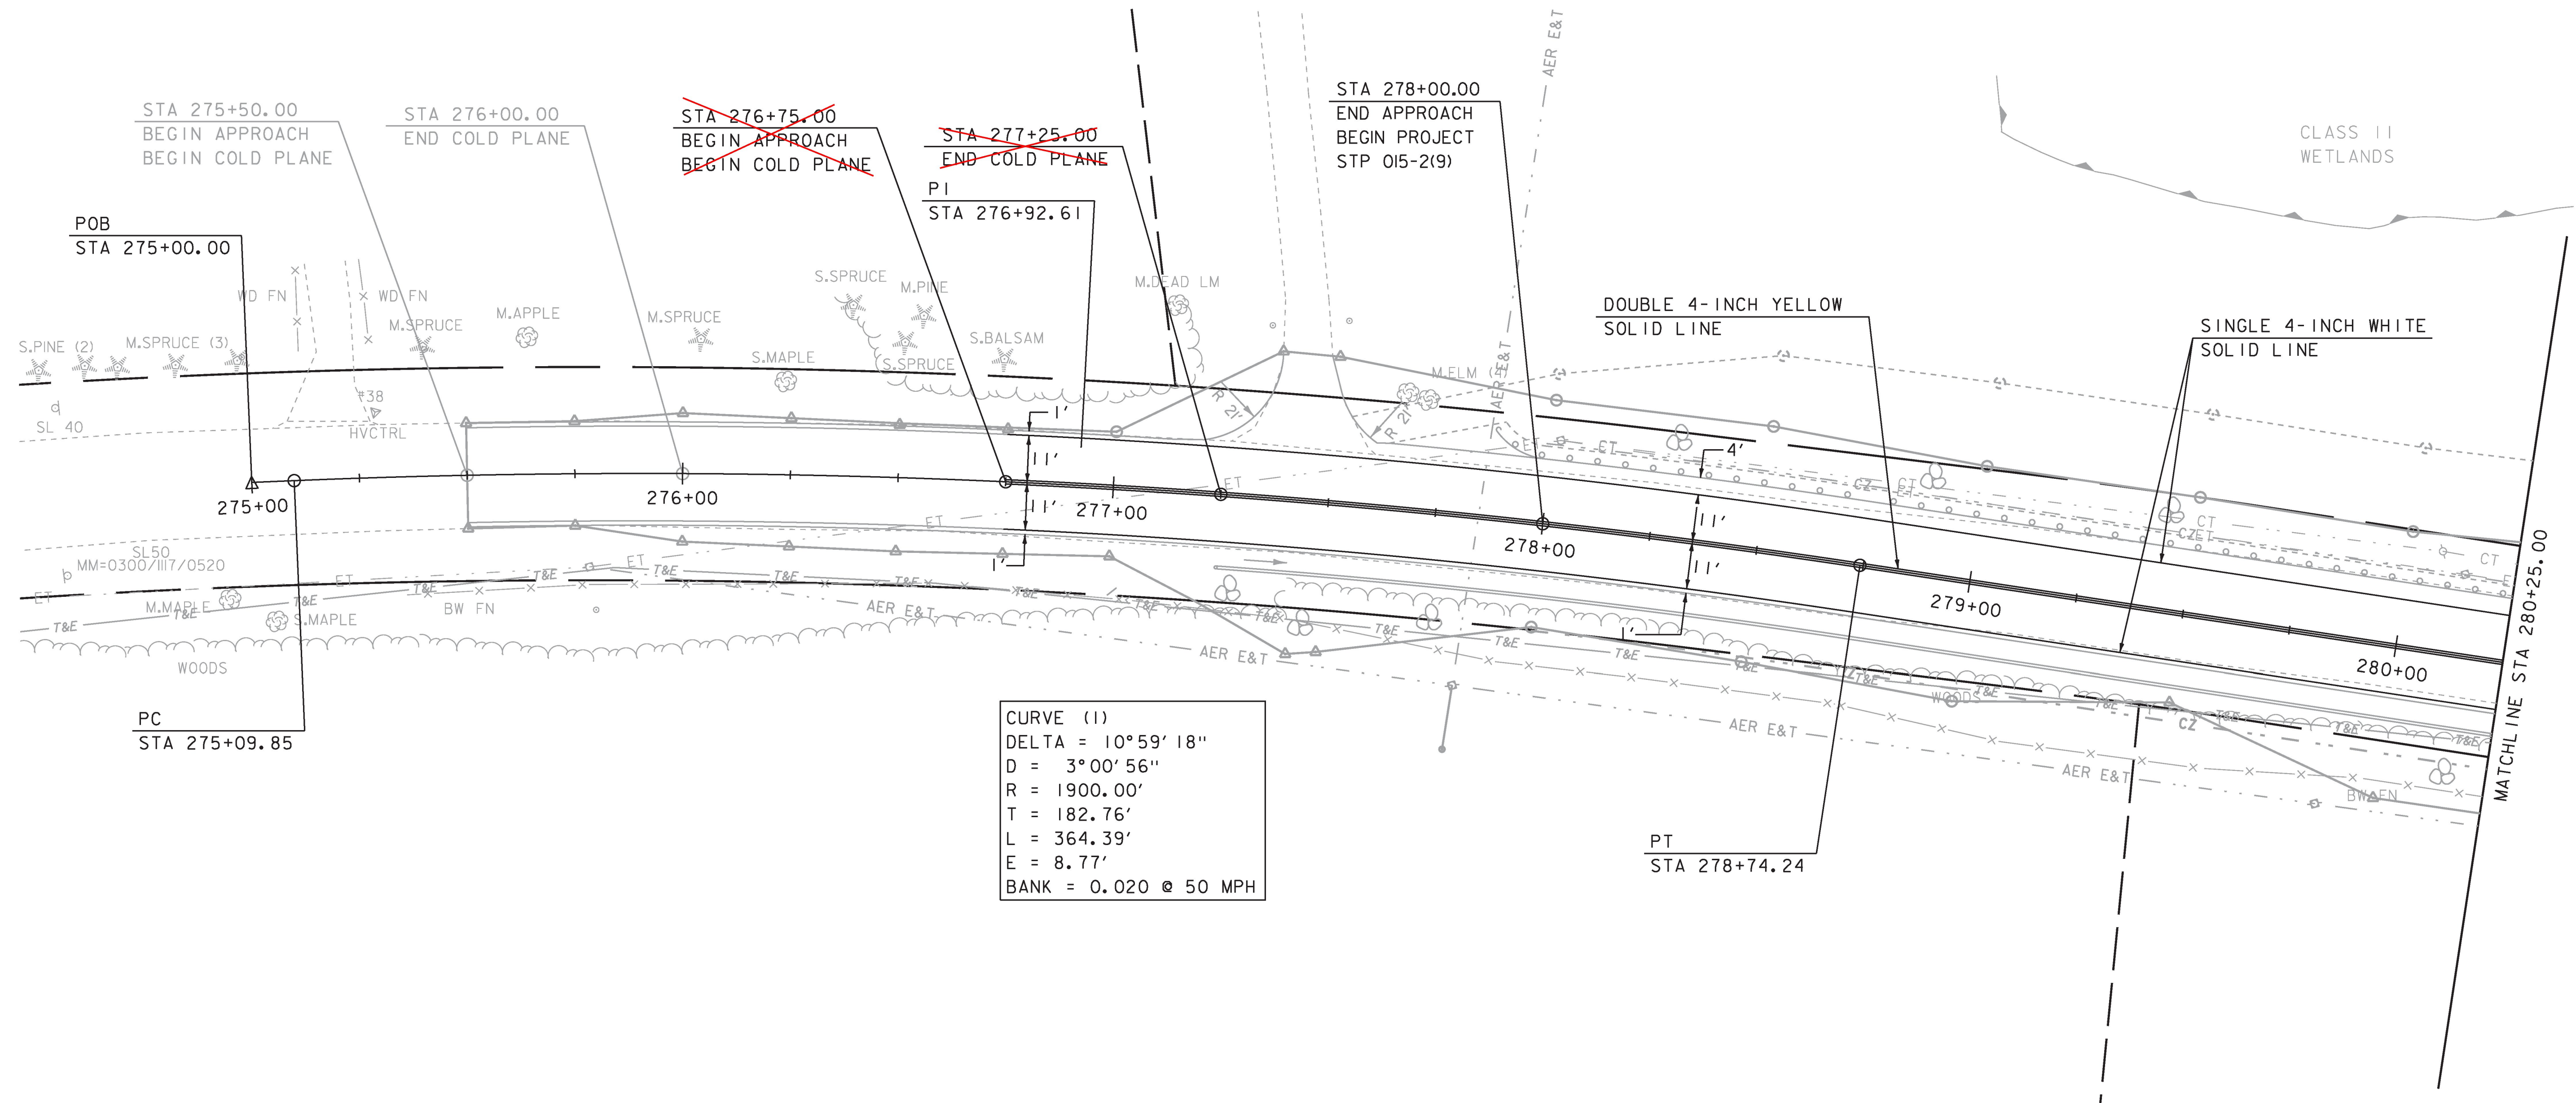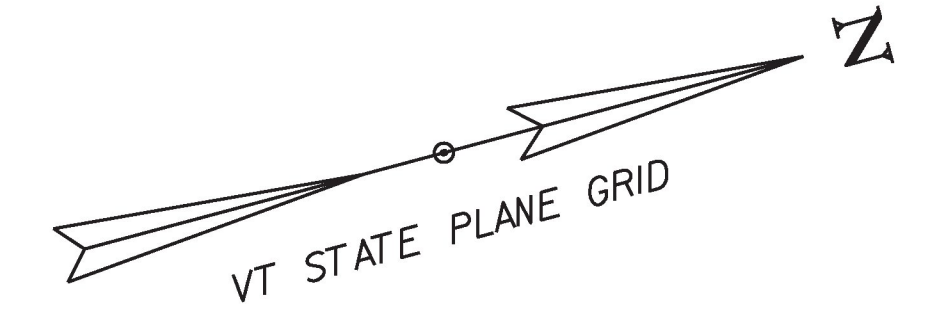

PROJECT NAME:	POULTNEY
PROJECT NUMBER:	STP 015-2(9)
FILE NAME:	dlib048+sbdr.dgn
PROJECT LEADER:	K. UPMAL
DESIGNED BY:	S. ZWICK
SIGNS & PAVEMENT MARKINGS SHEET 1	
PLOT DATE:	23-AUG-2018
DRAWN BY:	S. ZWICK
CHECKED BY:	C. LEACH
	SHEET 35 OF 48