




276+00

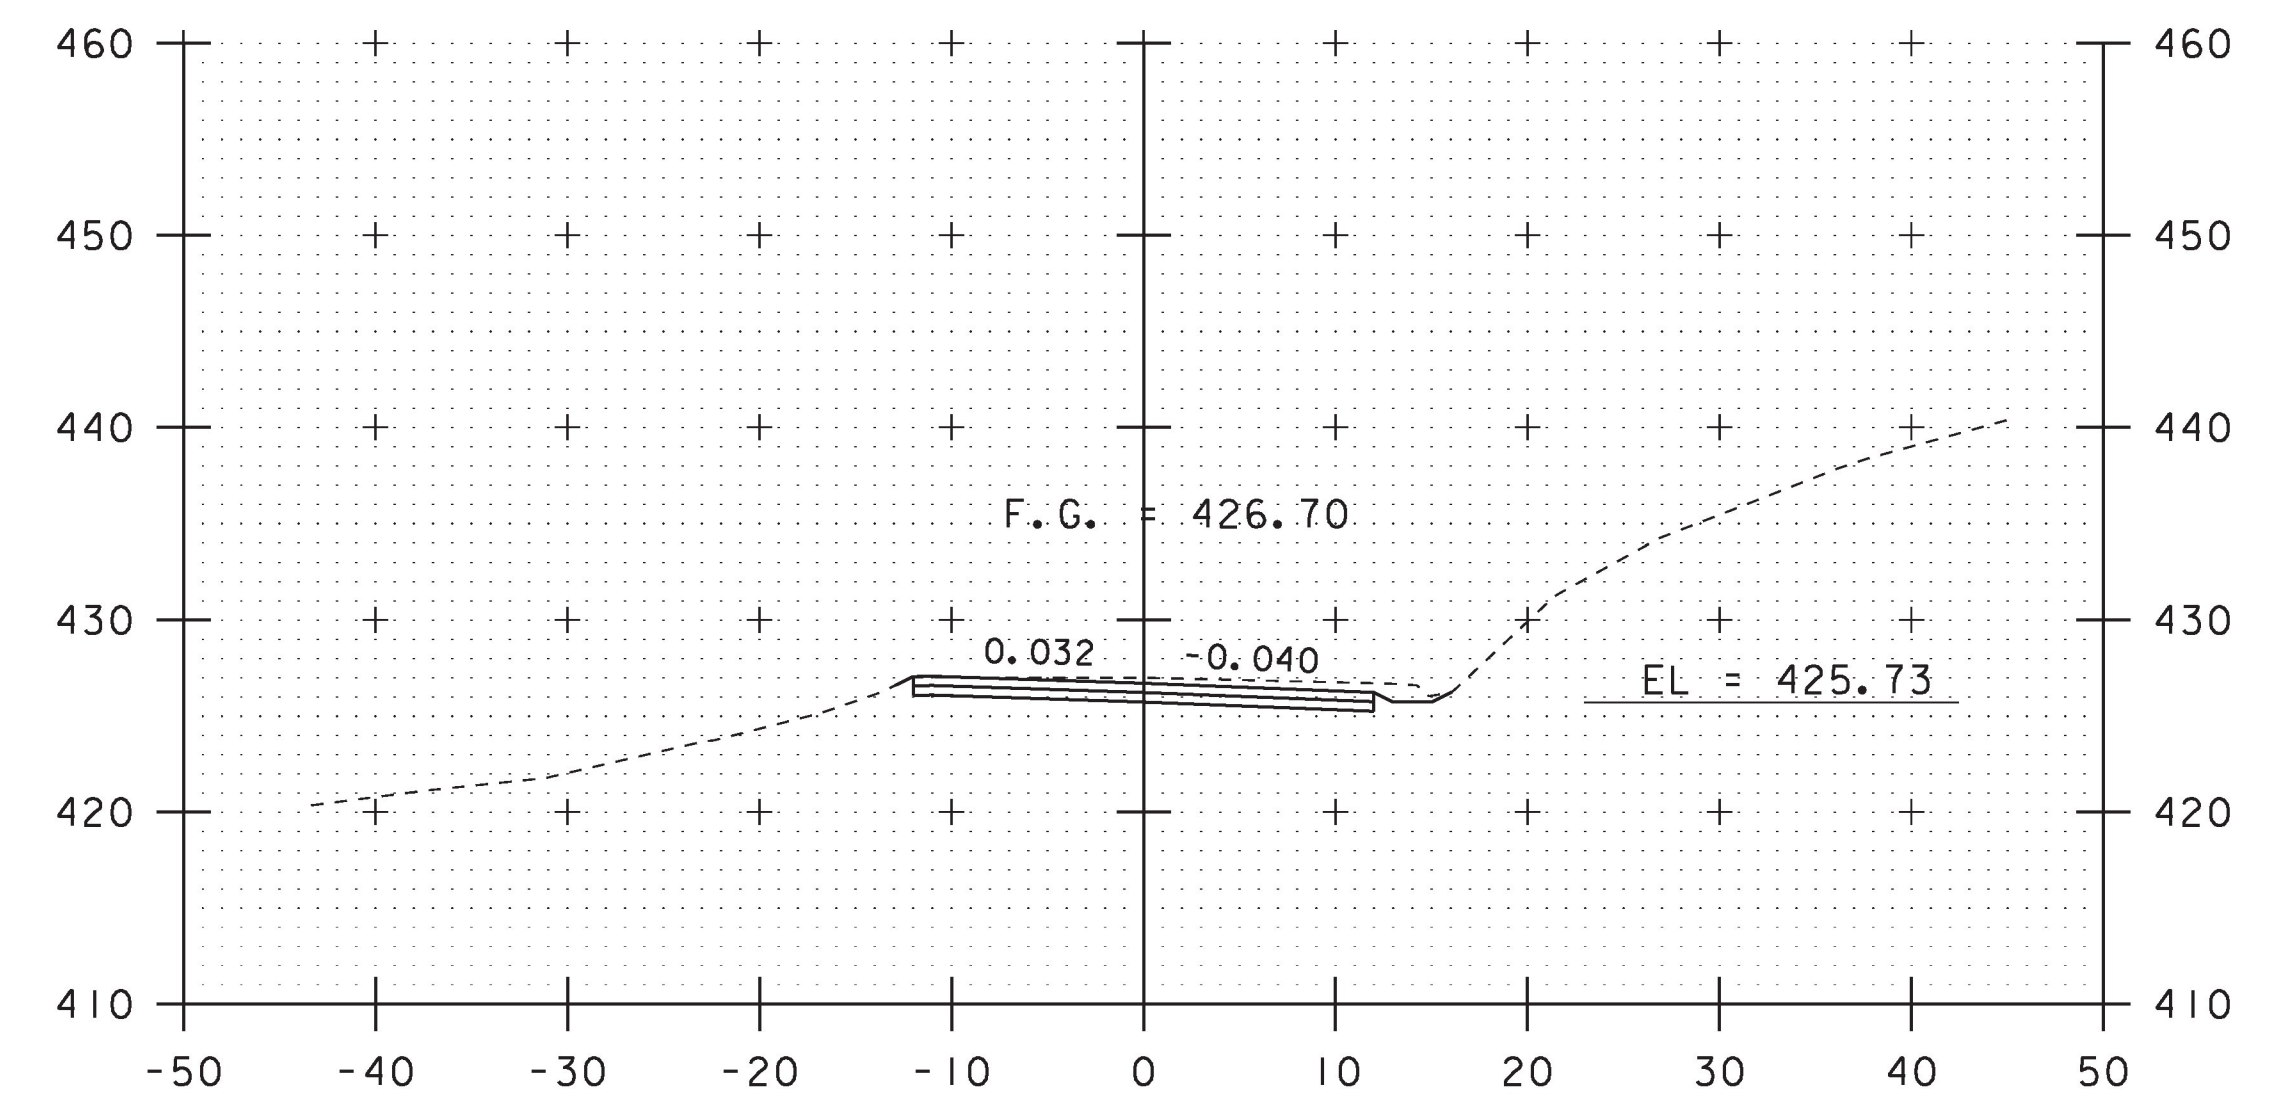

277+00

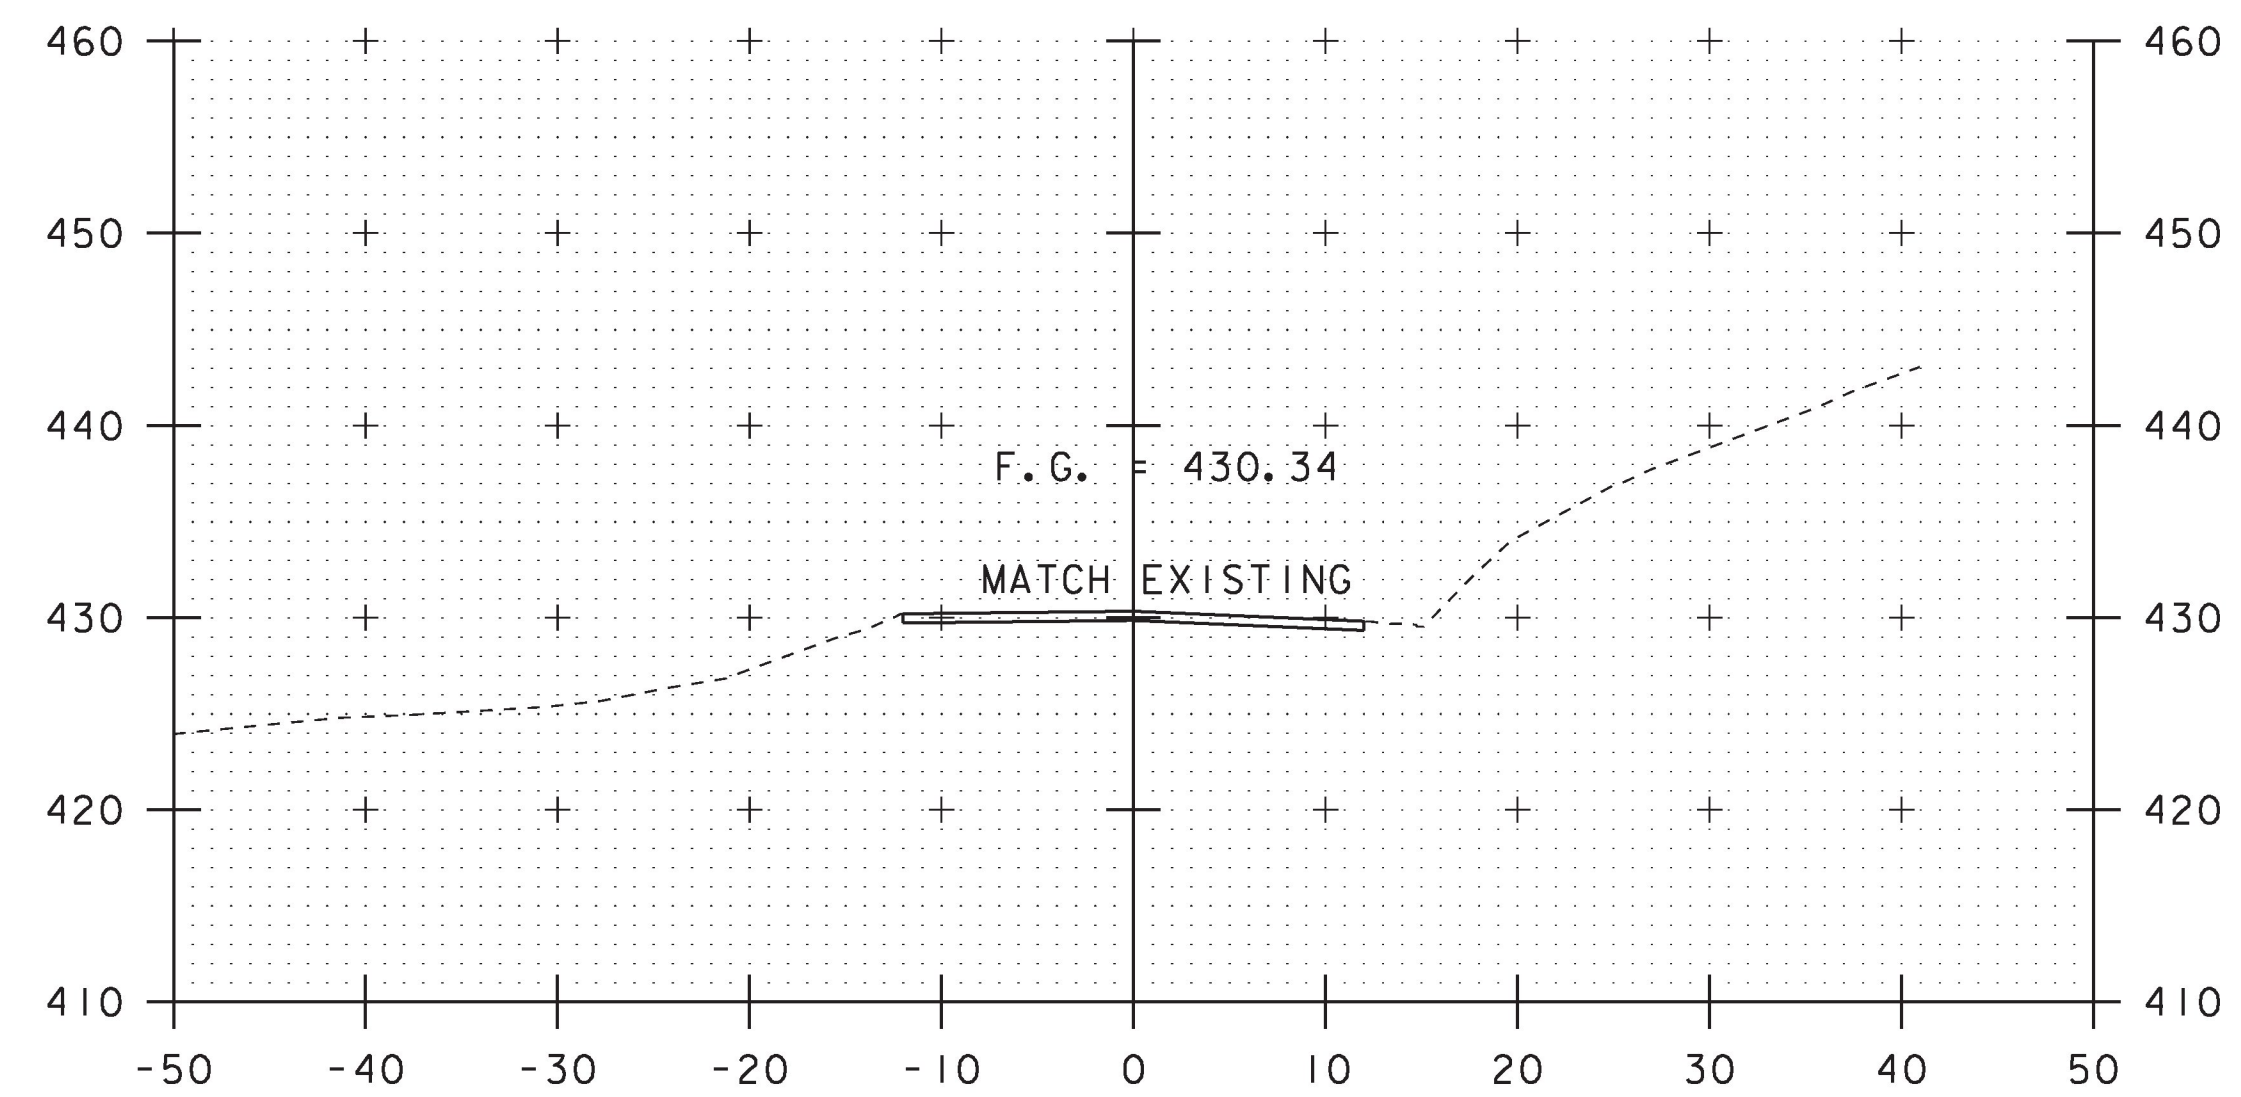

275+50
BEGIN APPROACH
BEGIN COLD PLANE

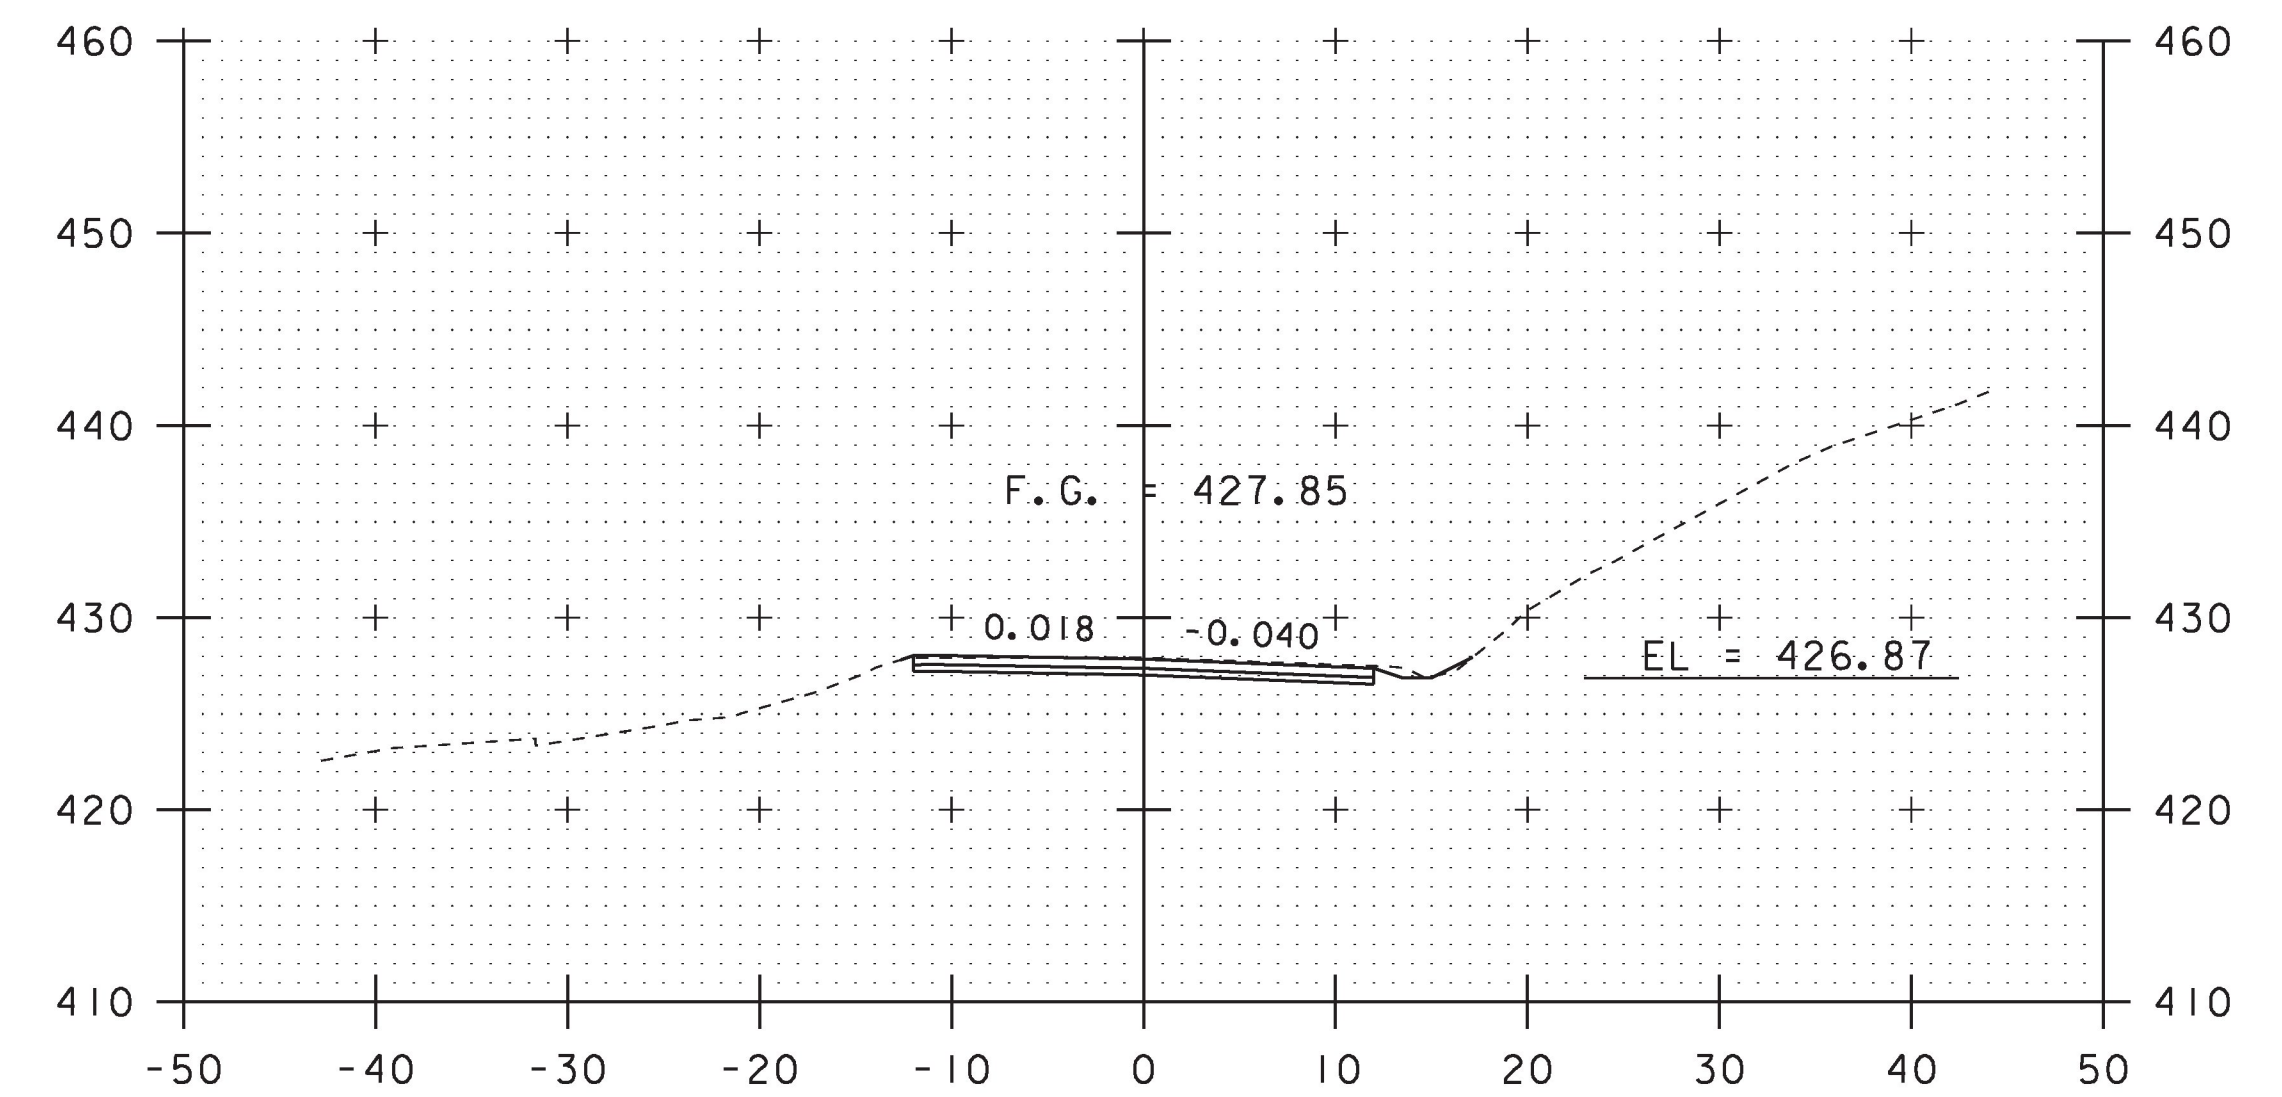

276+50

STA. 275+50 TO STA. 277+00

PROJECT NAME:	POULTNEY	PLOT DATE:	23-AUG-2018
PROJECT NUMBER:	STP 015-2(9)	DRAWN BY:	S. ZWICK
FILE NAME:	d11b048wrk	CHECKED BY:	C. LEACH
PROJECT LEADER:	K. UPMAL	CROSS SECTION SHEET I	SHEET 37 OF 48
DESIGNED BY:	S. ZWICK		