




277+43 DRIVE LT  
SECTION A-A

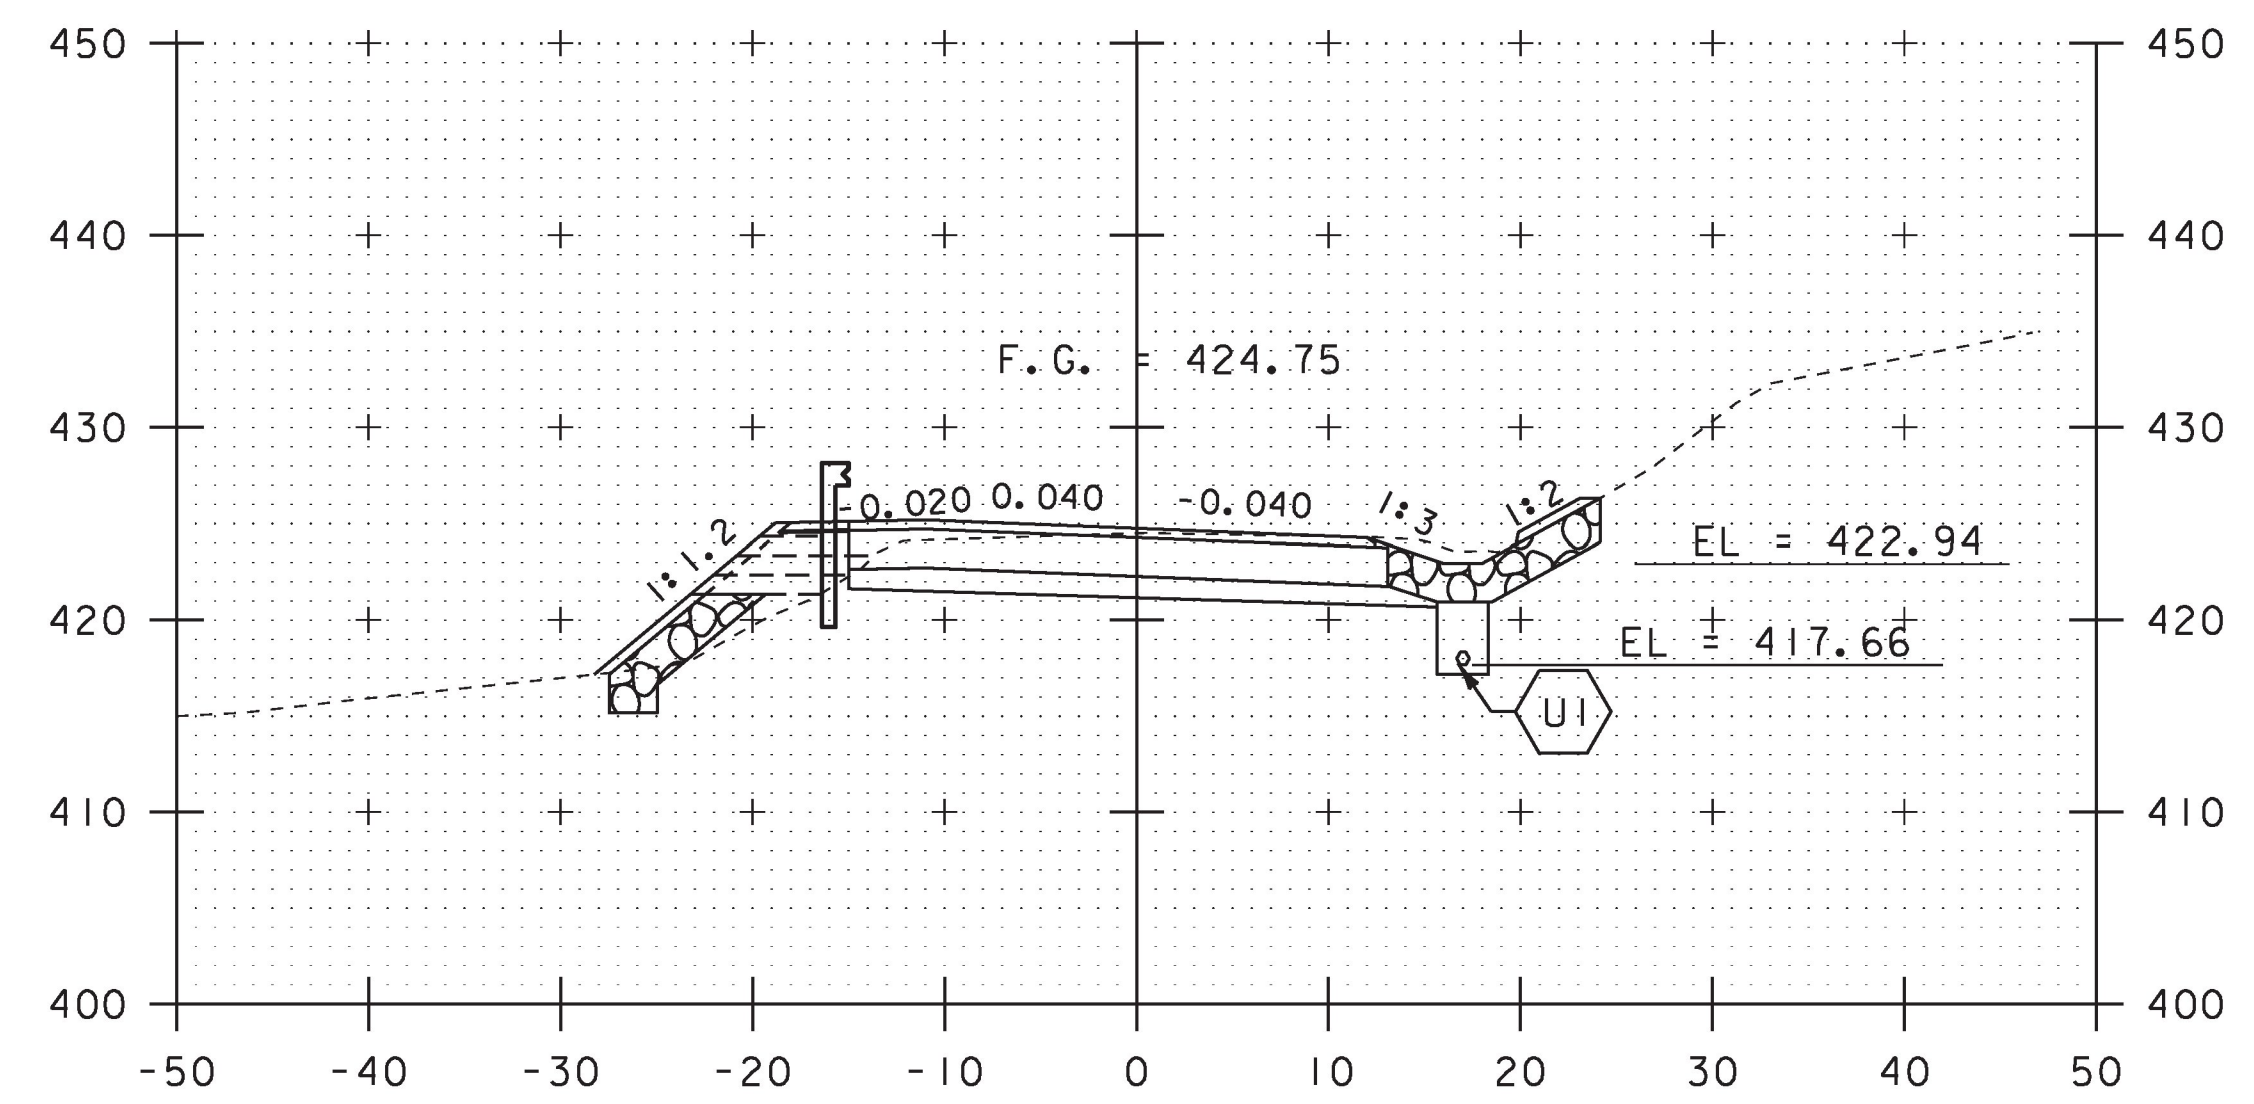

278+00  
END APPROACH  
BEGIN PROJECT STP 015-2(9)

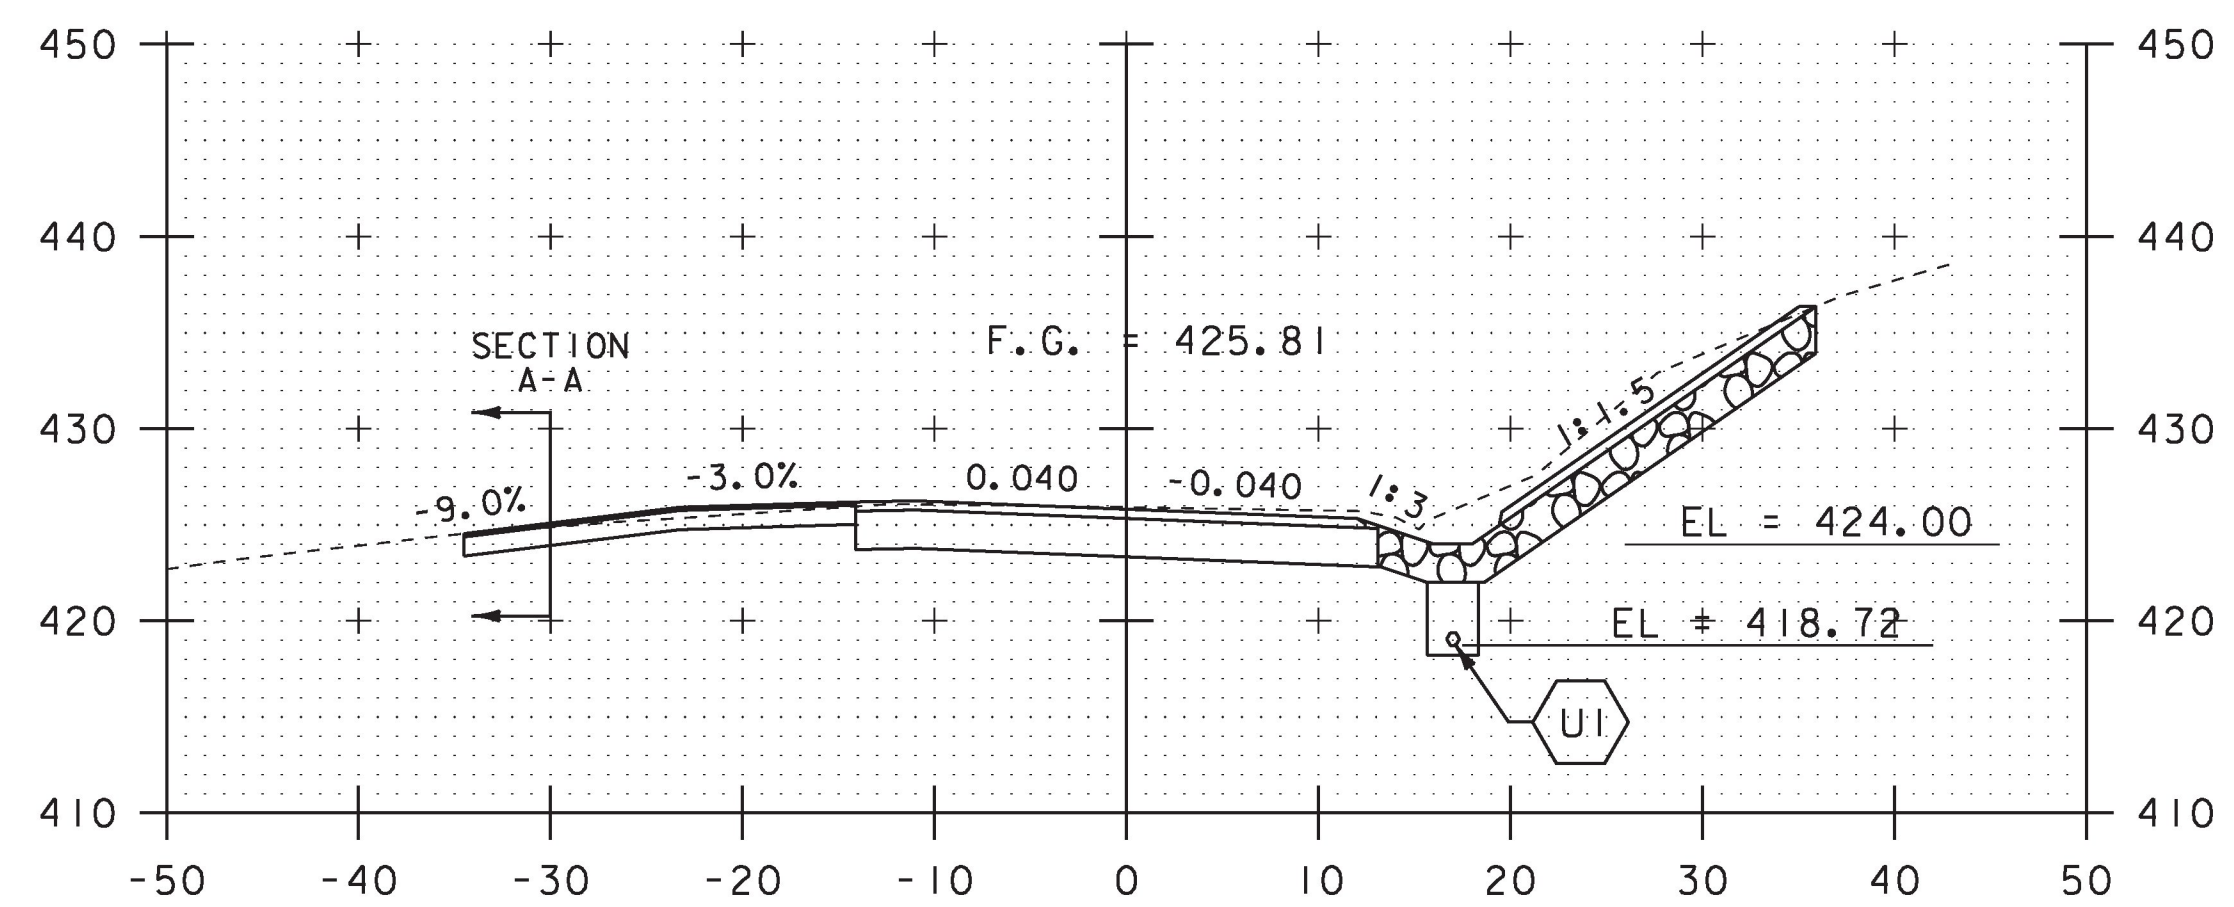

277+43  
DRIVE LT

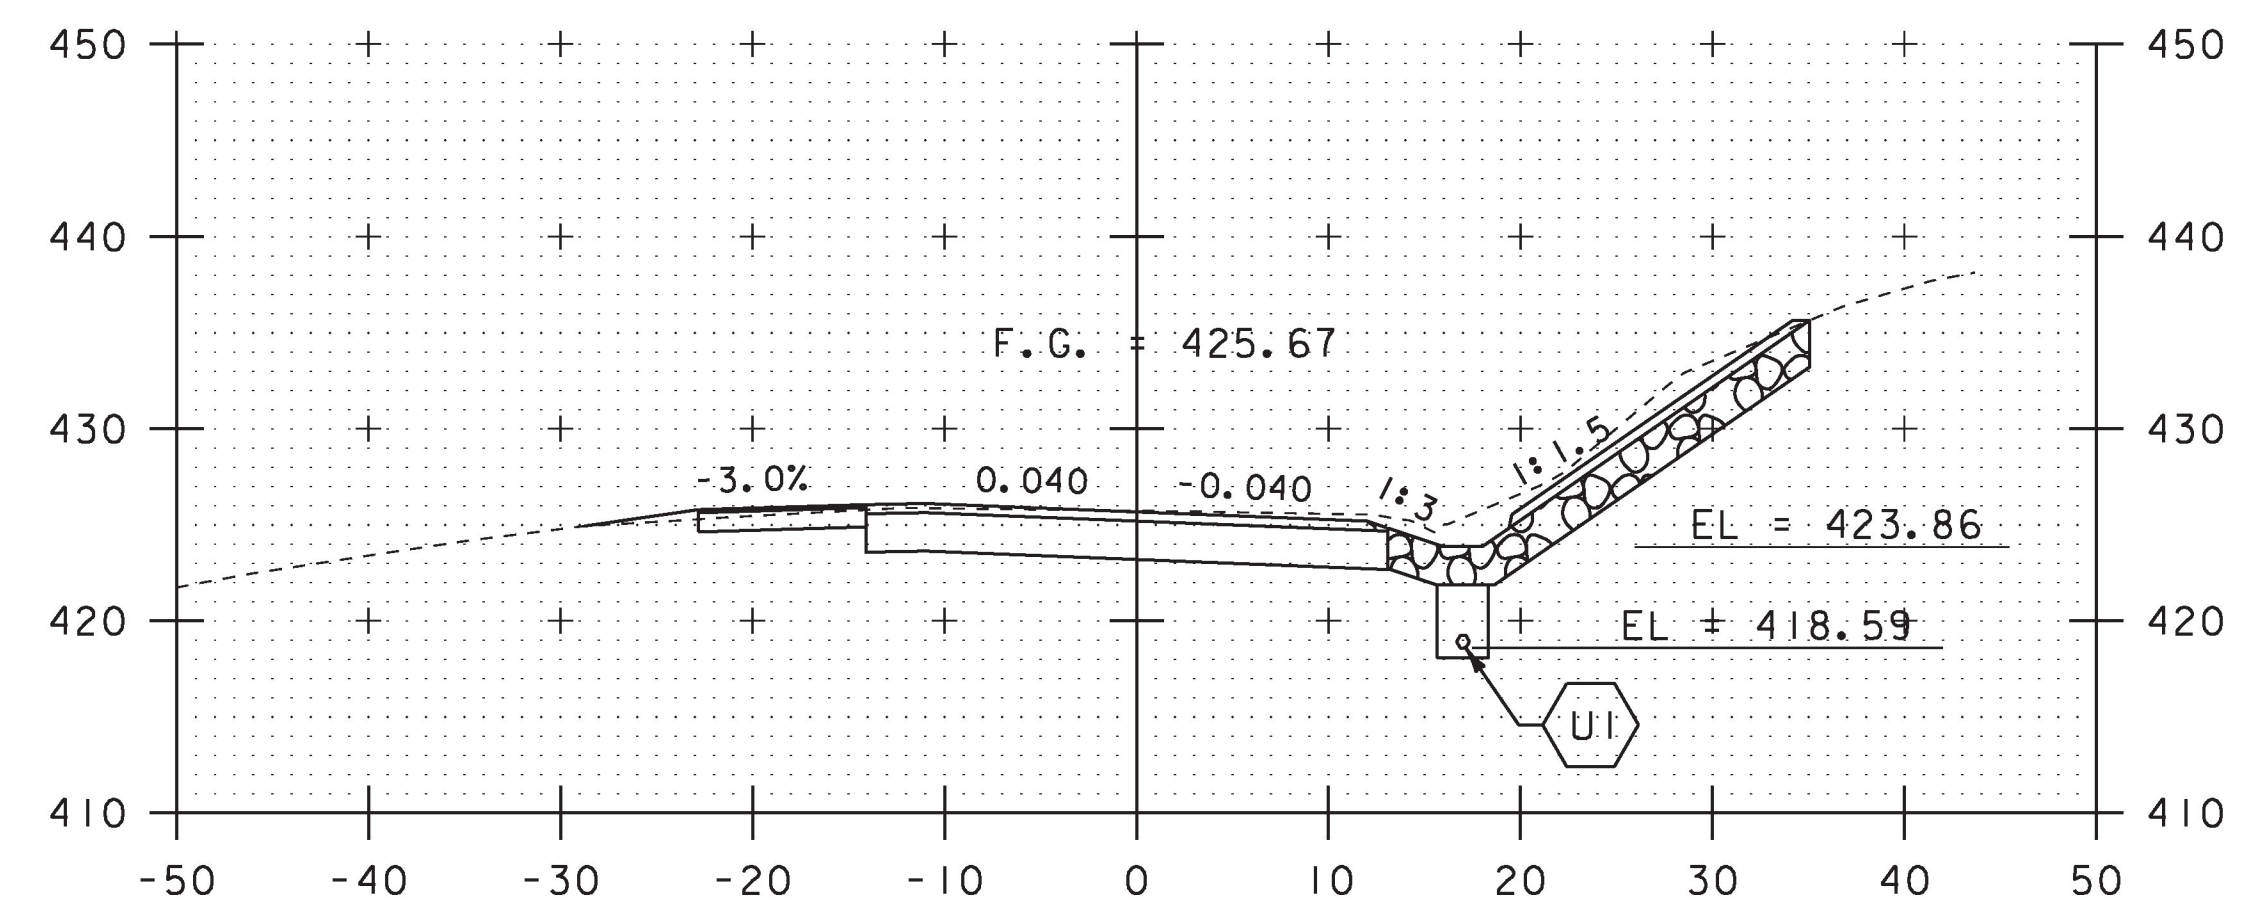

277+50

PROJECT NAME: POULTNEY	
PROJECT NUMBER: STP 015-2(9)	
FILE NAME: dl1b048wrk	PLOT DATE: 23-AUG-2018
PROJECT LEADER: K. UPMAL	DRAWN BY: S. ZWICK
DESIGNED BY: S. ZWICK	CHECKED BY: C. LEACH
CROSS SECTION SHEET 2	SHEET 38 OF 48

STA. 277+43 TO STA. 278+00