



284+00

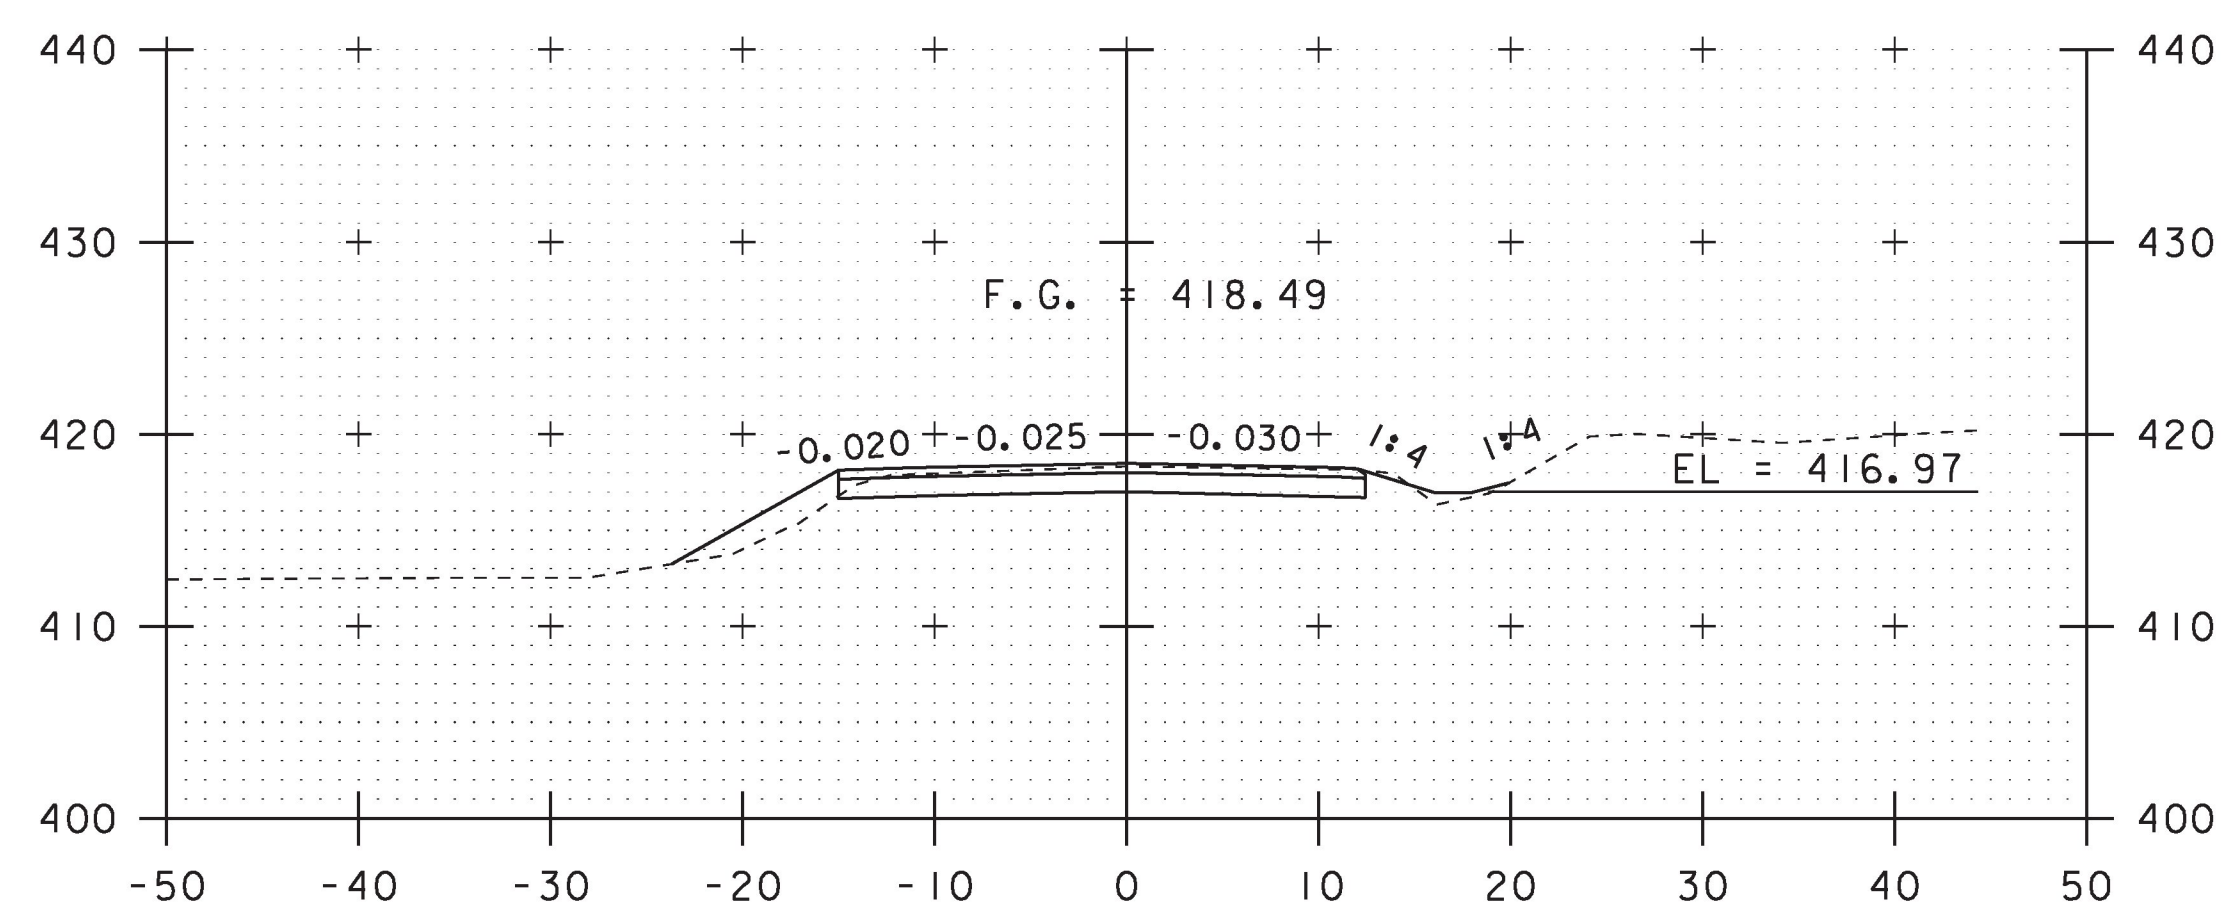

283+50

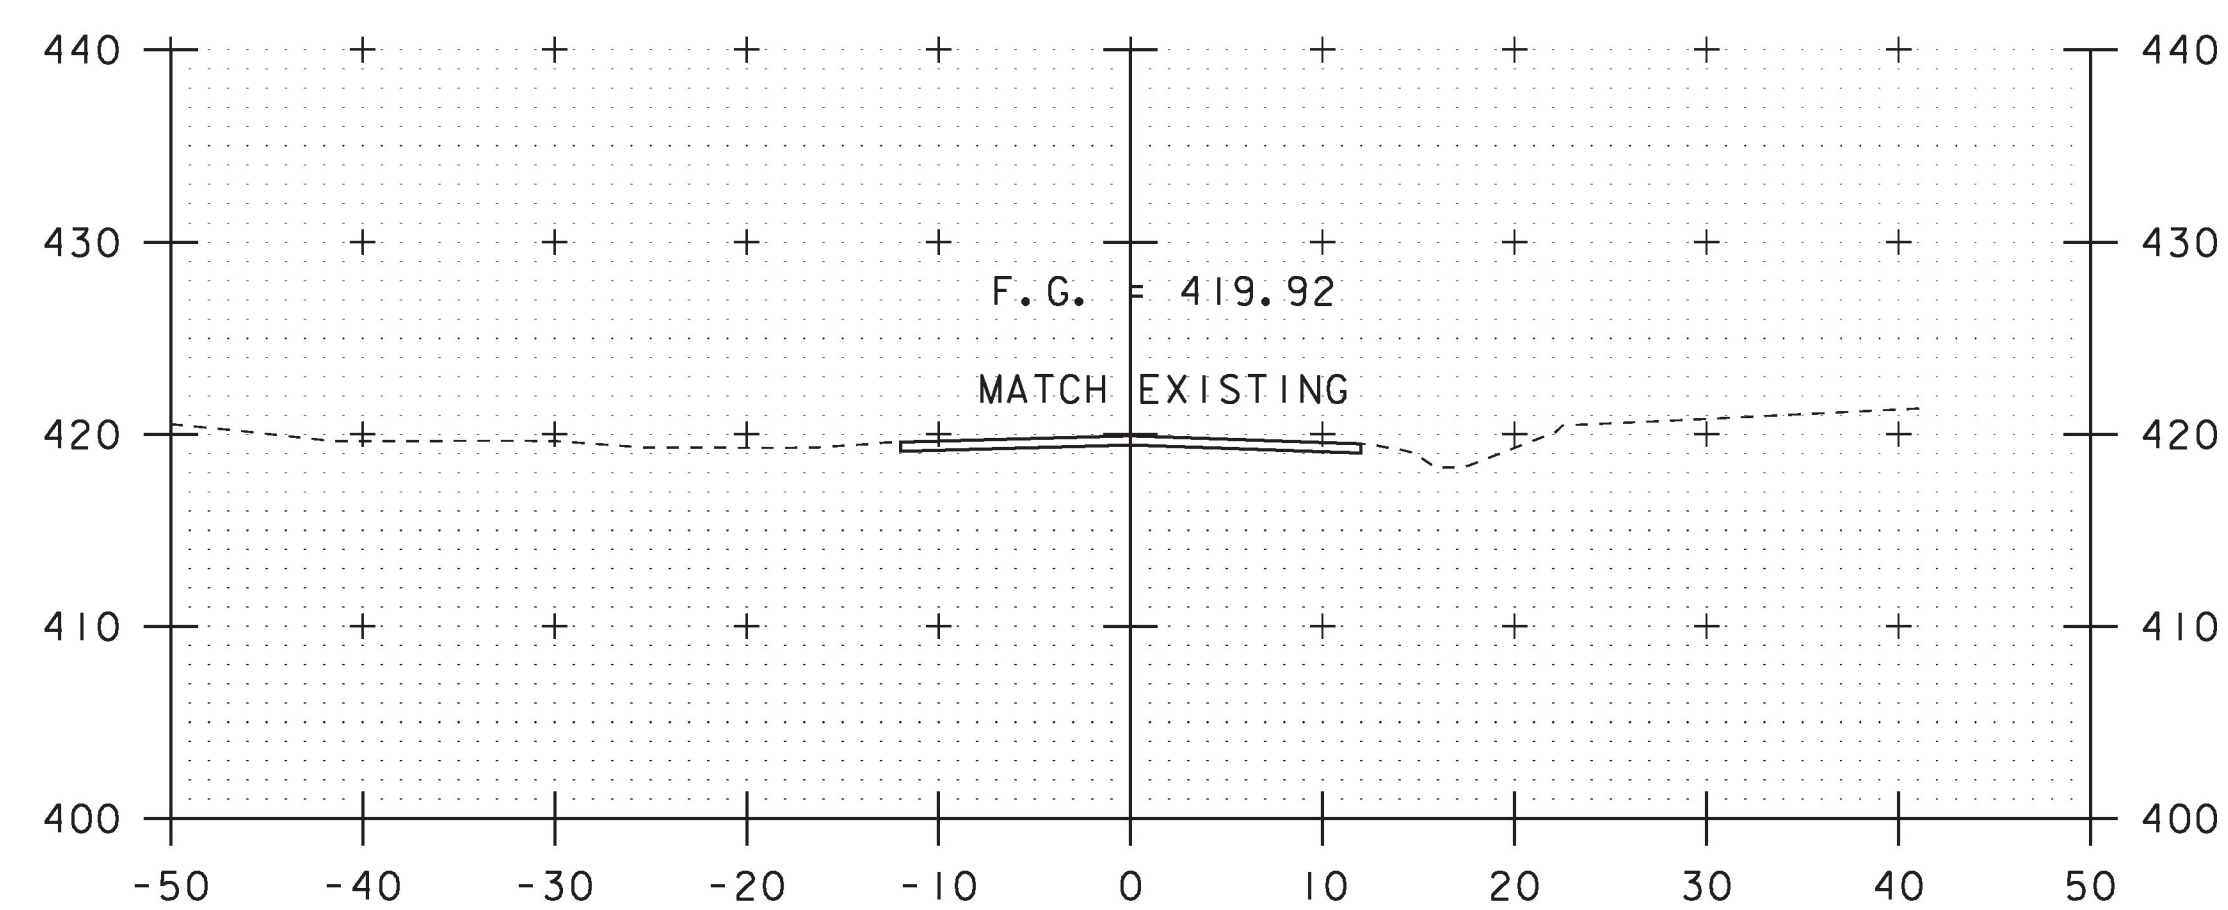

284+25  
END APPROACH  
END COLD PLANE

STA. 283+50 TO STA. 284+25

PROJECT NAME: POULTNEY	PLOT DATE: 23-AUG-2018
PROJECT NUMBER: STP 015-2(9)	DRAWN BY: S. ZWICK
FILE NAME: d11b048wrk	CHECKED BY: C. LEACH
PROJECT LEADER: K. UPMAL	SHEET 42 OF 48
DESIGNED BY: S. ZWICK	
CROSS SECTION SHEET 6	