


VT 30 CURVE DATA	
DELTA =	79°27'42.61" RT
D =	5°25'51.17"
R =	1055.00'
T =	876.84'
L =	1463.15'
E =	316.81'

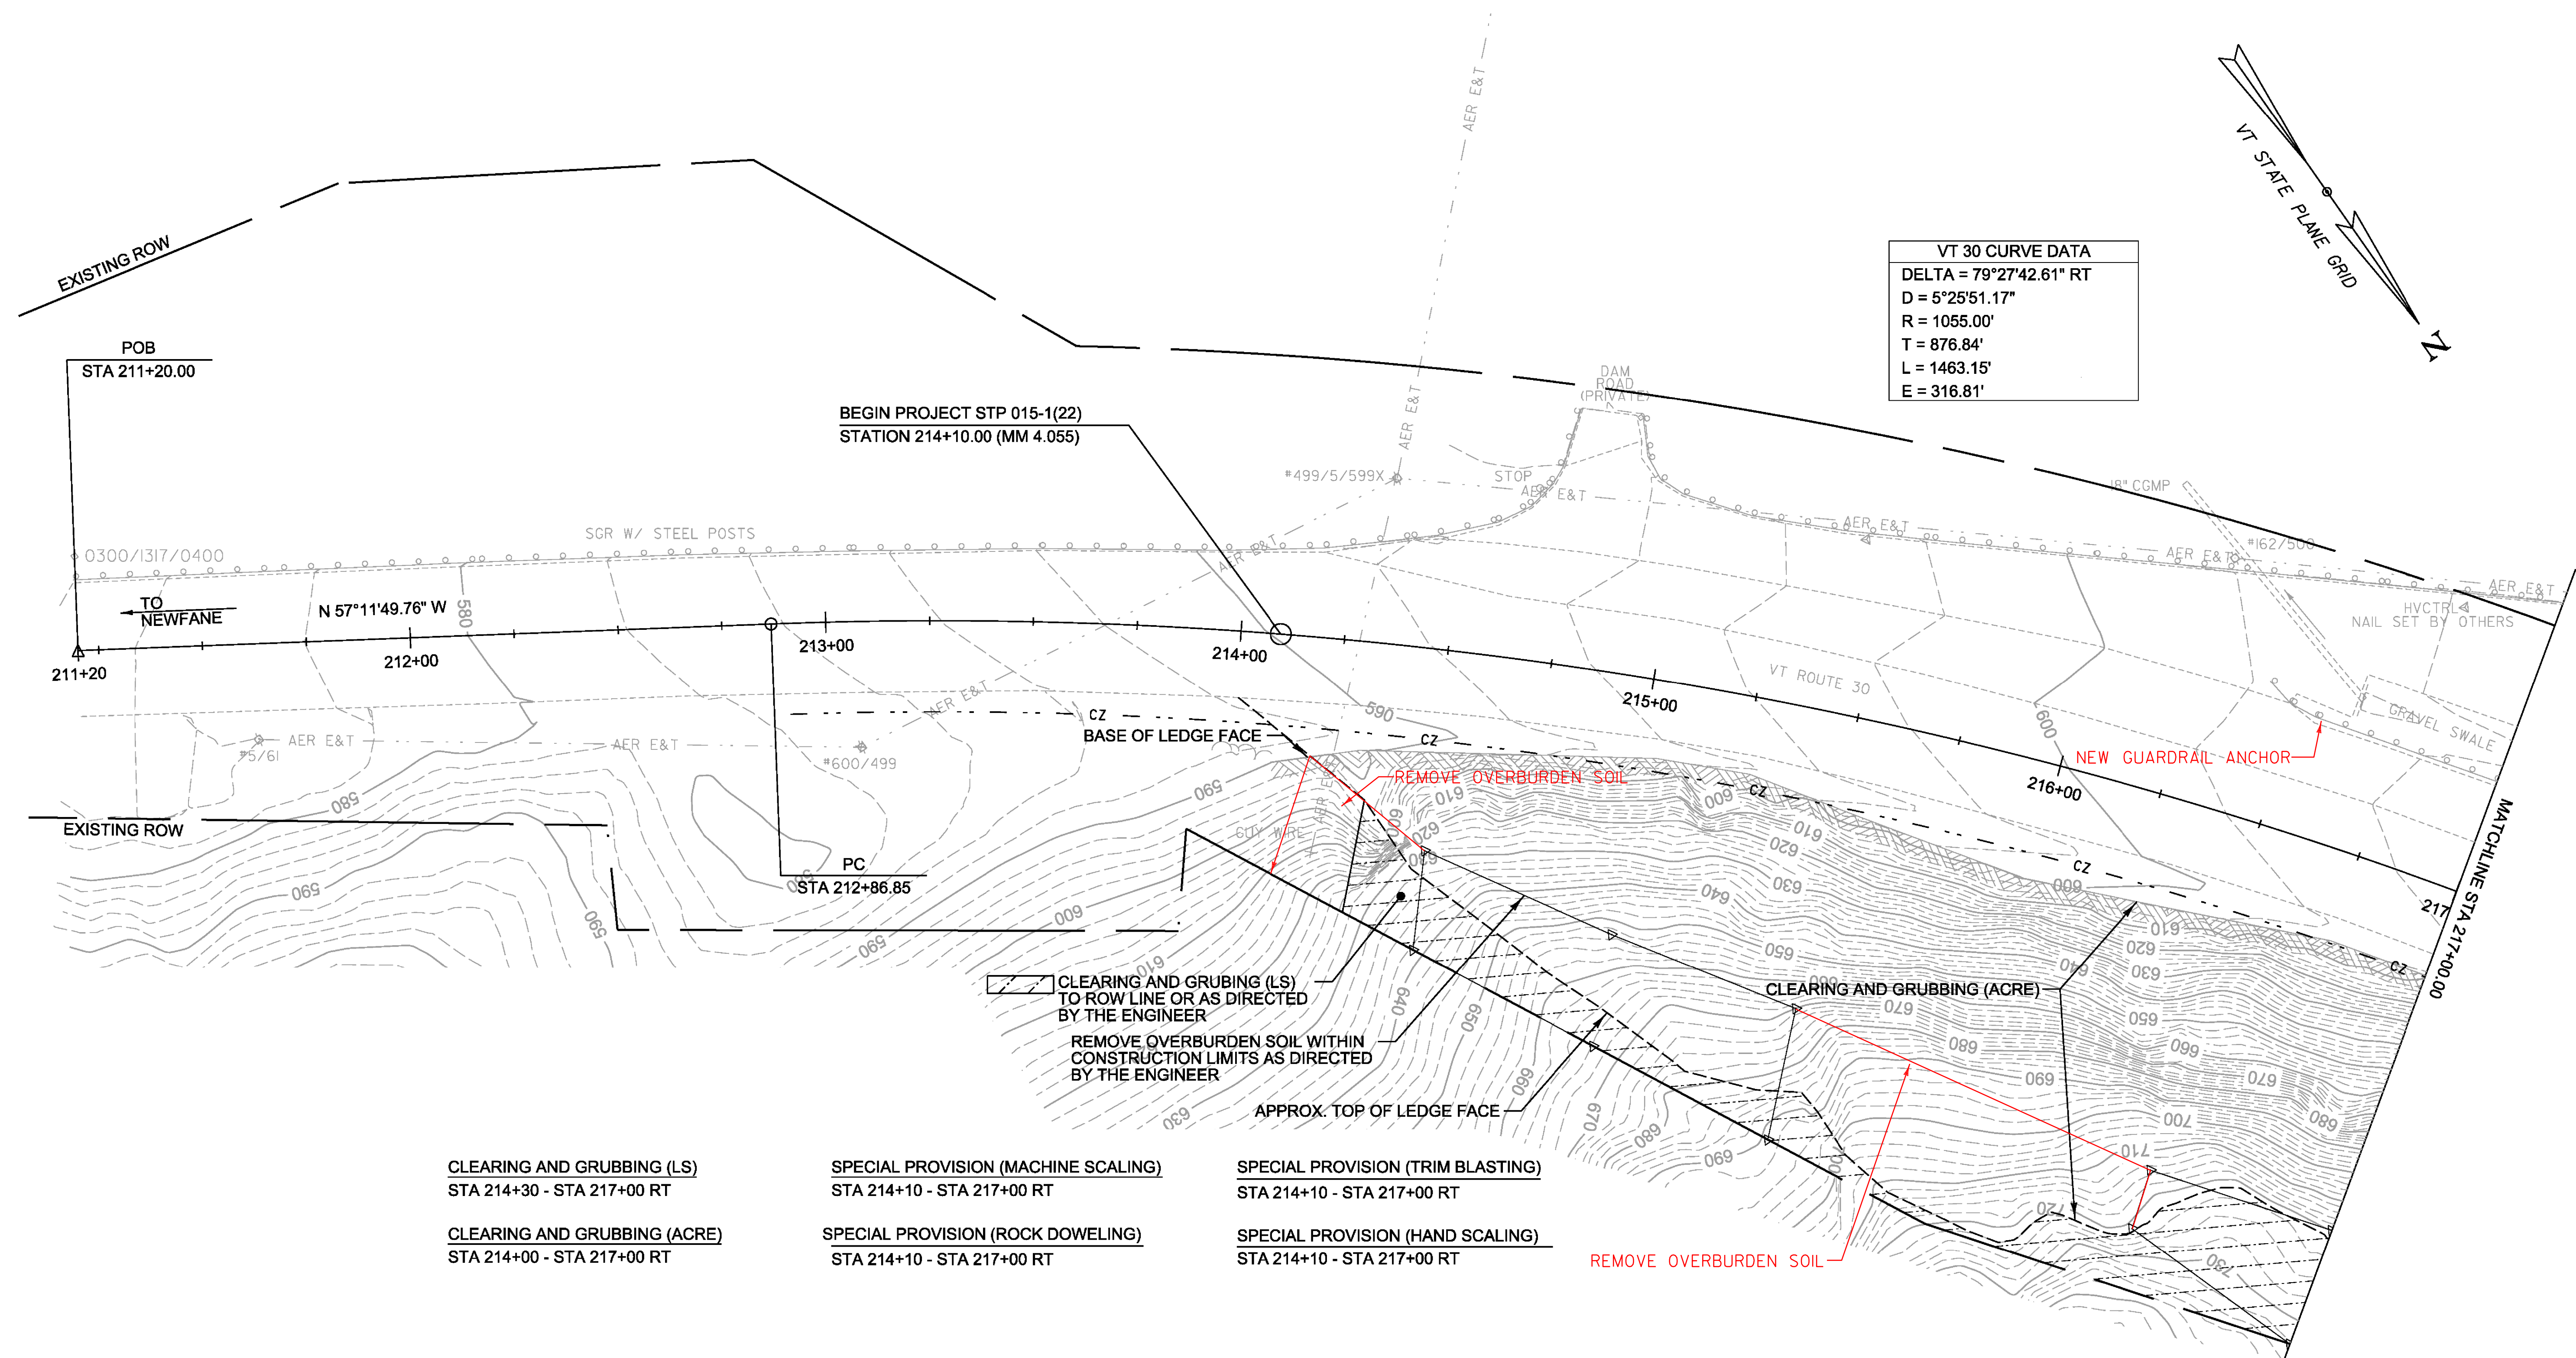

CLEARING AND GRUBBING (LS)
 TO ROW LINE OR AS DIRECTED
 BY THE ENGINEER
 REMOVE OVERBURDEN SOIL WITHIN
 CONSTRUCTION LIMITS AS DIRECTED
 BY THE ENGINEER

CLEARING AND GRUBBING (ACRE)

CLEARING AND GRUBBING (LS)
 STA 214+30 - STA 217+00 RT

SPECIAL PROVISION (MACHINE SCALING)
 STA 214+10 - STA 217+00 RT


SPECIAL PROVISION (TRIM BLASTING)
 STA 214+10 - STA 217+00 RT

CLEARING AND GRUBBING (ACRE)
 STA 214+00 - STA 217+00 RT

SPECIAL PROVISION (ROCK DOWELING)
 STA 214+10 - STA 217+00 RT

SPECIAL PROVISION (HAND SCALING)
 STA 214+10 - STA 217+00 RT

REMOVE OVERBURDEN SOIL

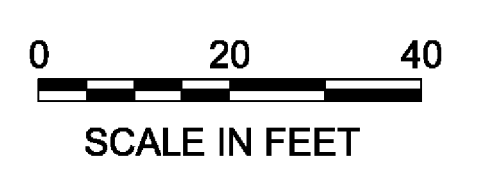

PROJECT NAME:	TOWNSHEND
PROJECT NUMBER:	STP 015-1(22)
FILE NAME:	d1b050nui.dgn
PROJECT LEADER:	K. UPMAL
DESIGNED BY:	C. LEACH
PLAN SHEET 1	
PLOT DATE:	1/9/2015
DRAWN BY:	C. LEACH
CHECKED BY:	B. KIPP
SHEET	9 OF 34