
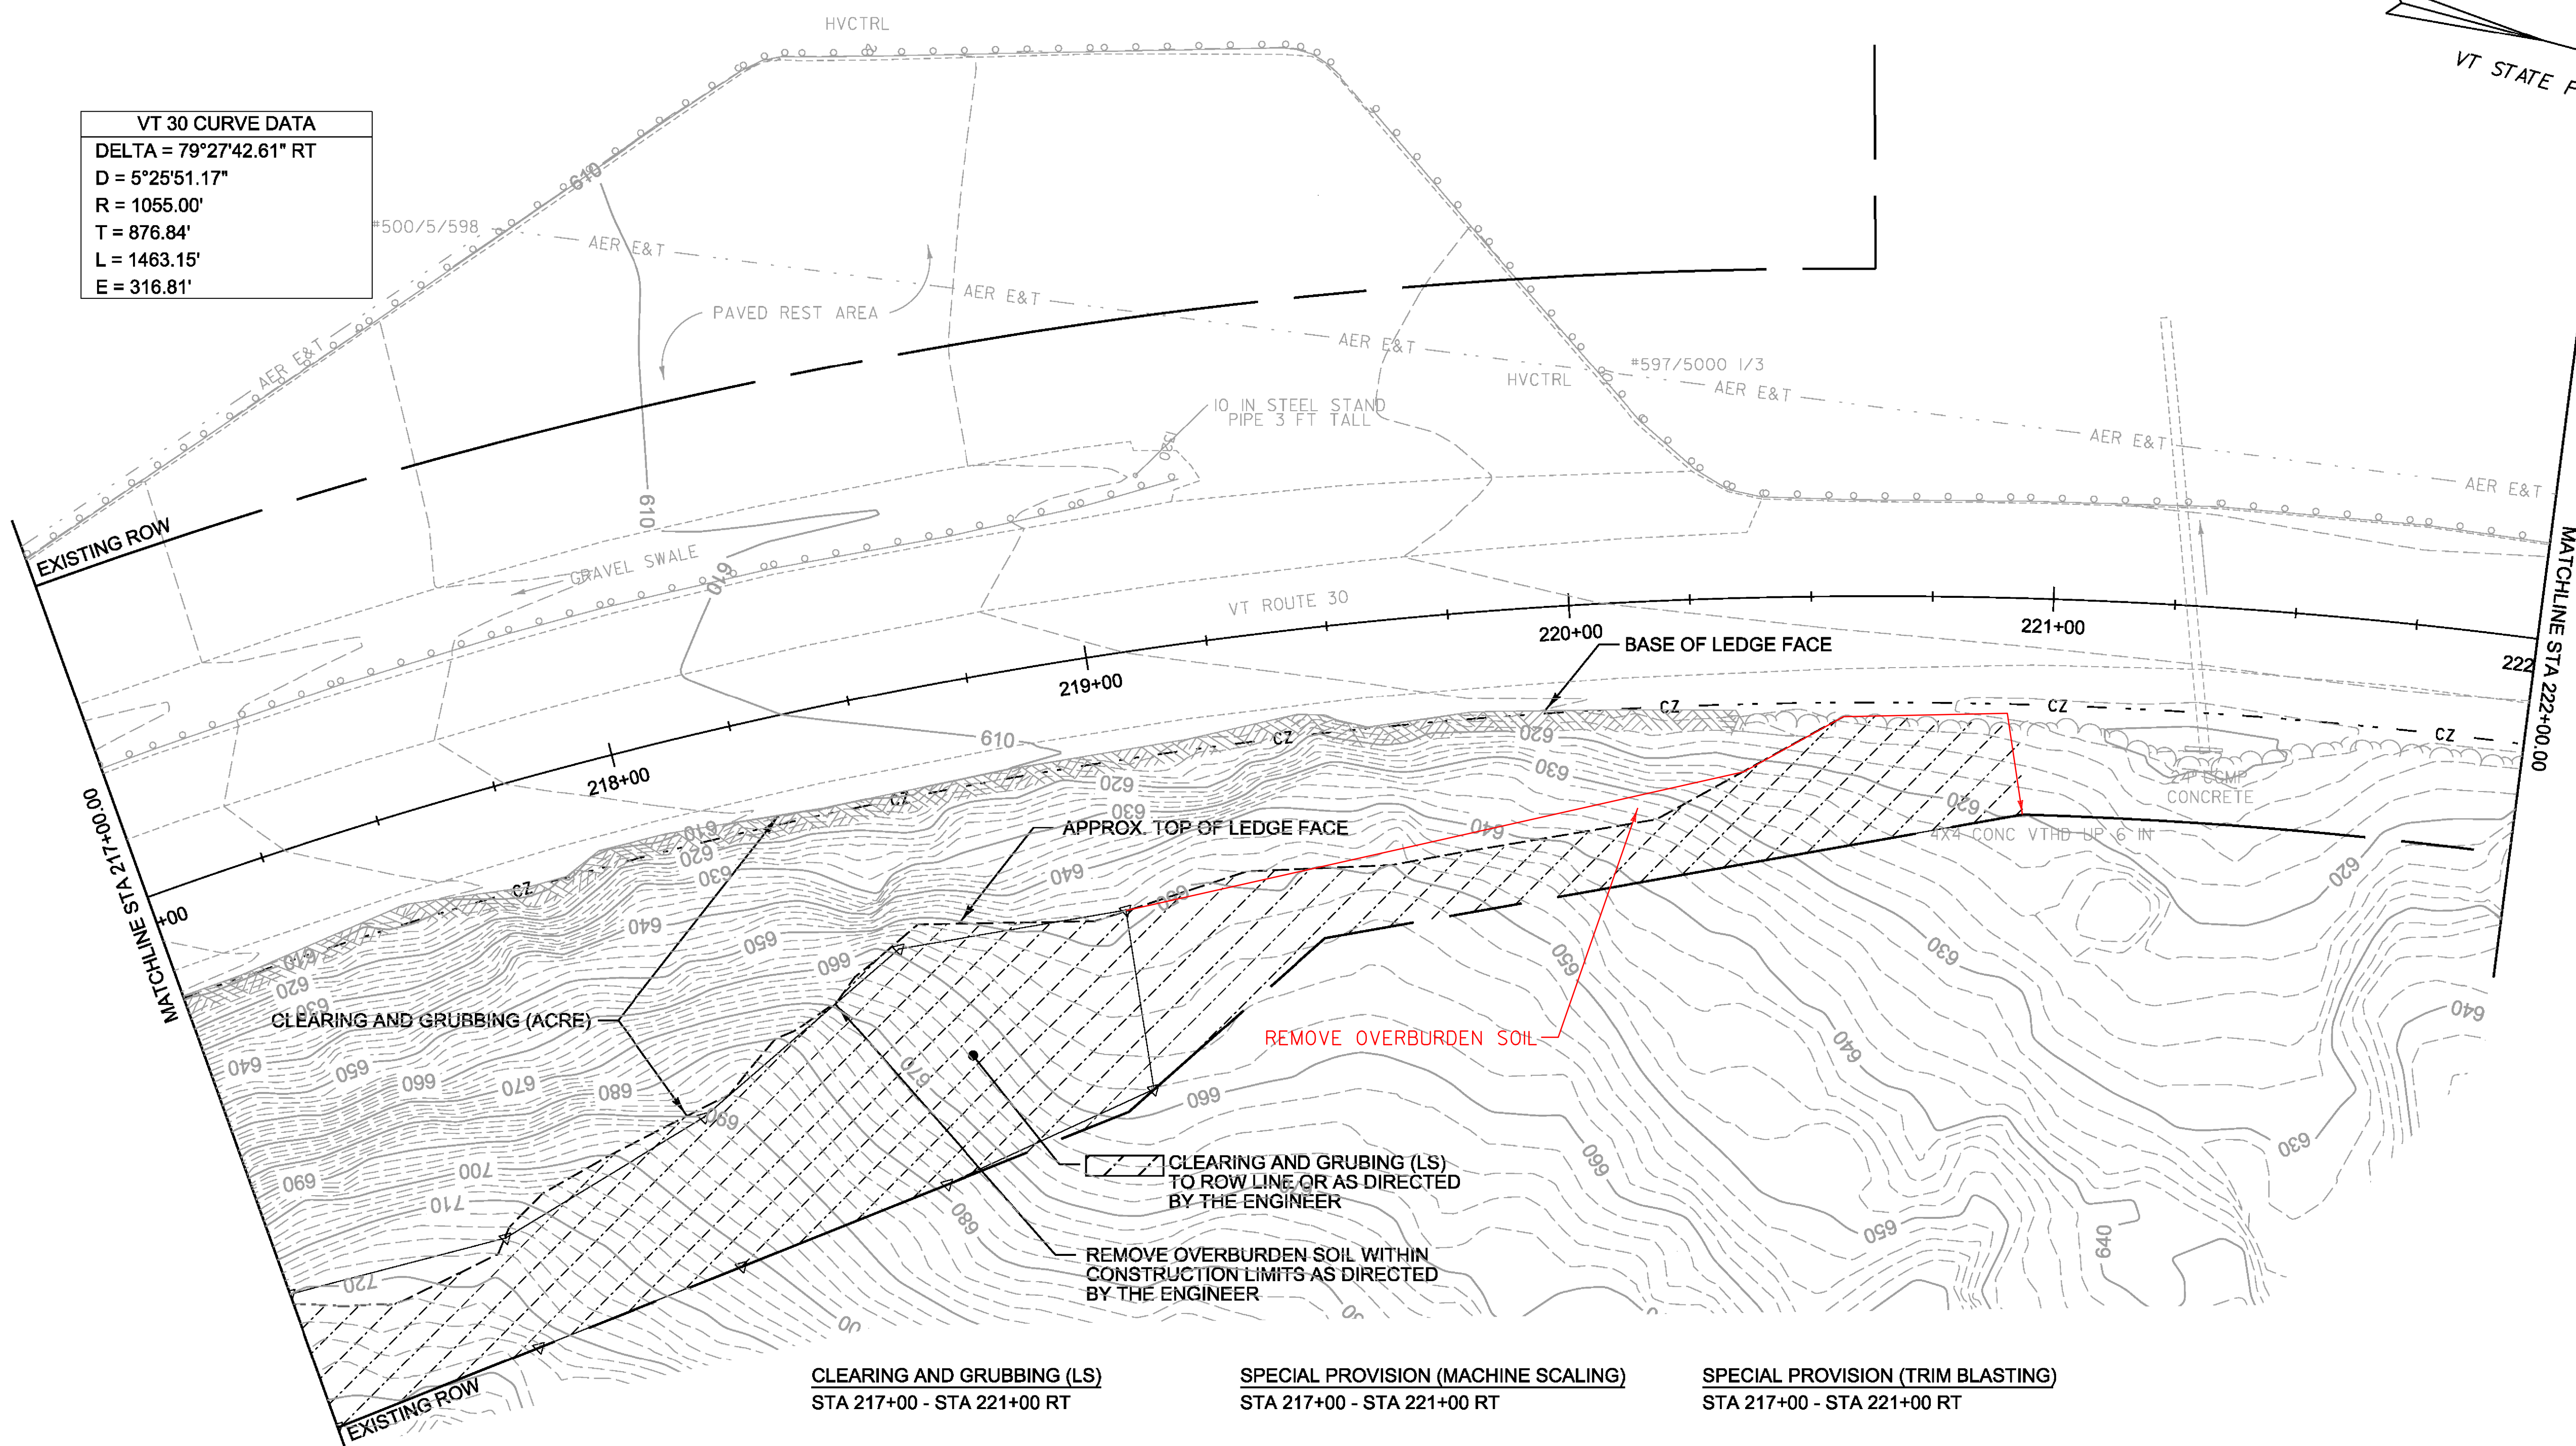


VT 30 CURVE DATA	
DELTA =	79°27'42.61" RT
D =	5°25'51.17"
R =	1055.00'
T =	876.84'
L =	1463.15'
E =	316.81'

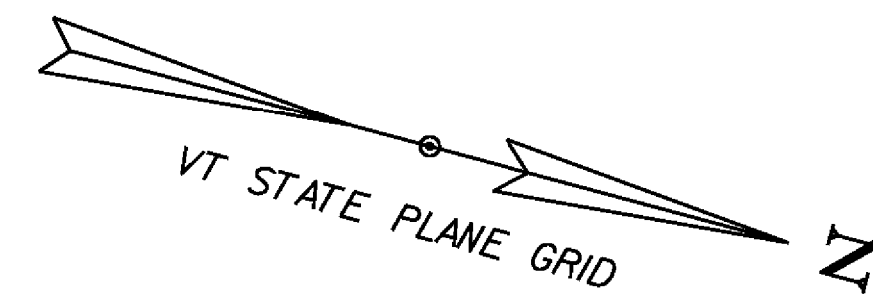

CLEARING AND GRUBBING (LS)
STA 217+00 - STA 221+00 RT

SPECIAL PROVISION (MACHINE SCALING)
STA 217+00 - STA 221+00 RT

SPECIAL PROVISION (TRIM BLASTING)
STA 217+00 - STA 221+00 RT

CLEARING AND GRUBBING (ACRE)
STA 217+00 - STA 220+00 RT

SPECIAL PROVISION (ROCK DOWELING)
STA 217+00 - STA 221+00 RT

SPECIAL PROVISION (HAND SCALING)
STA 217+00 - STA 221+00 RT



PROJECT NAME:	TOWNSHEND	PLOT DATE:	1/9/2015
PROJECT NUMBER:	STP 015-1(22)	DRAWN BY:	C. LEACH
FILE NAME:	d1lb050nui.dgn	CHECKED BY:	B. KIPP
PROJECT LEADER:	K. UPMAL	SHEET	10 OF 34
DESIGNED BY:	C. LEACH	PLAN SHEET	2