


VT 30 CURVE DATA	
DELTA =	79°27'42.61" RT
D =	5°25'51.17"
R =	1055.00'
T =	876.84'
L =	1463.15'
E =	316.81'

END PROJECT STP 015-1(22)
STATION 225+35.00 (MM 4.268)

POE
STA 227+50.00

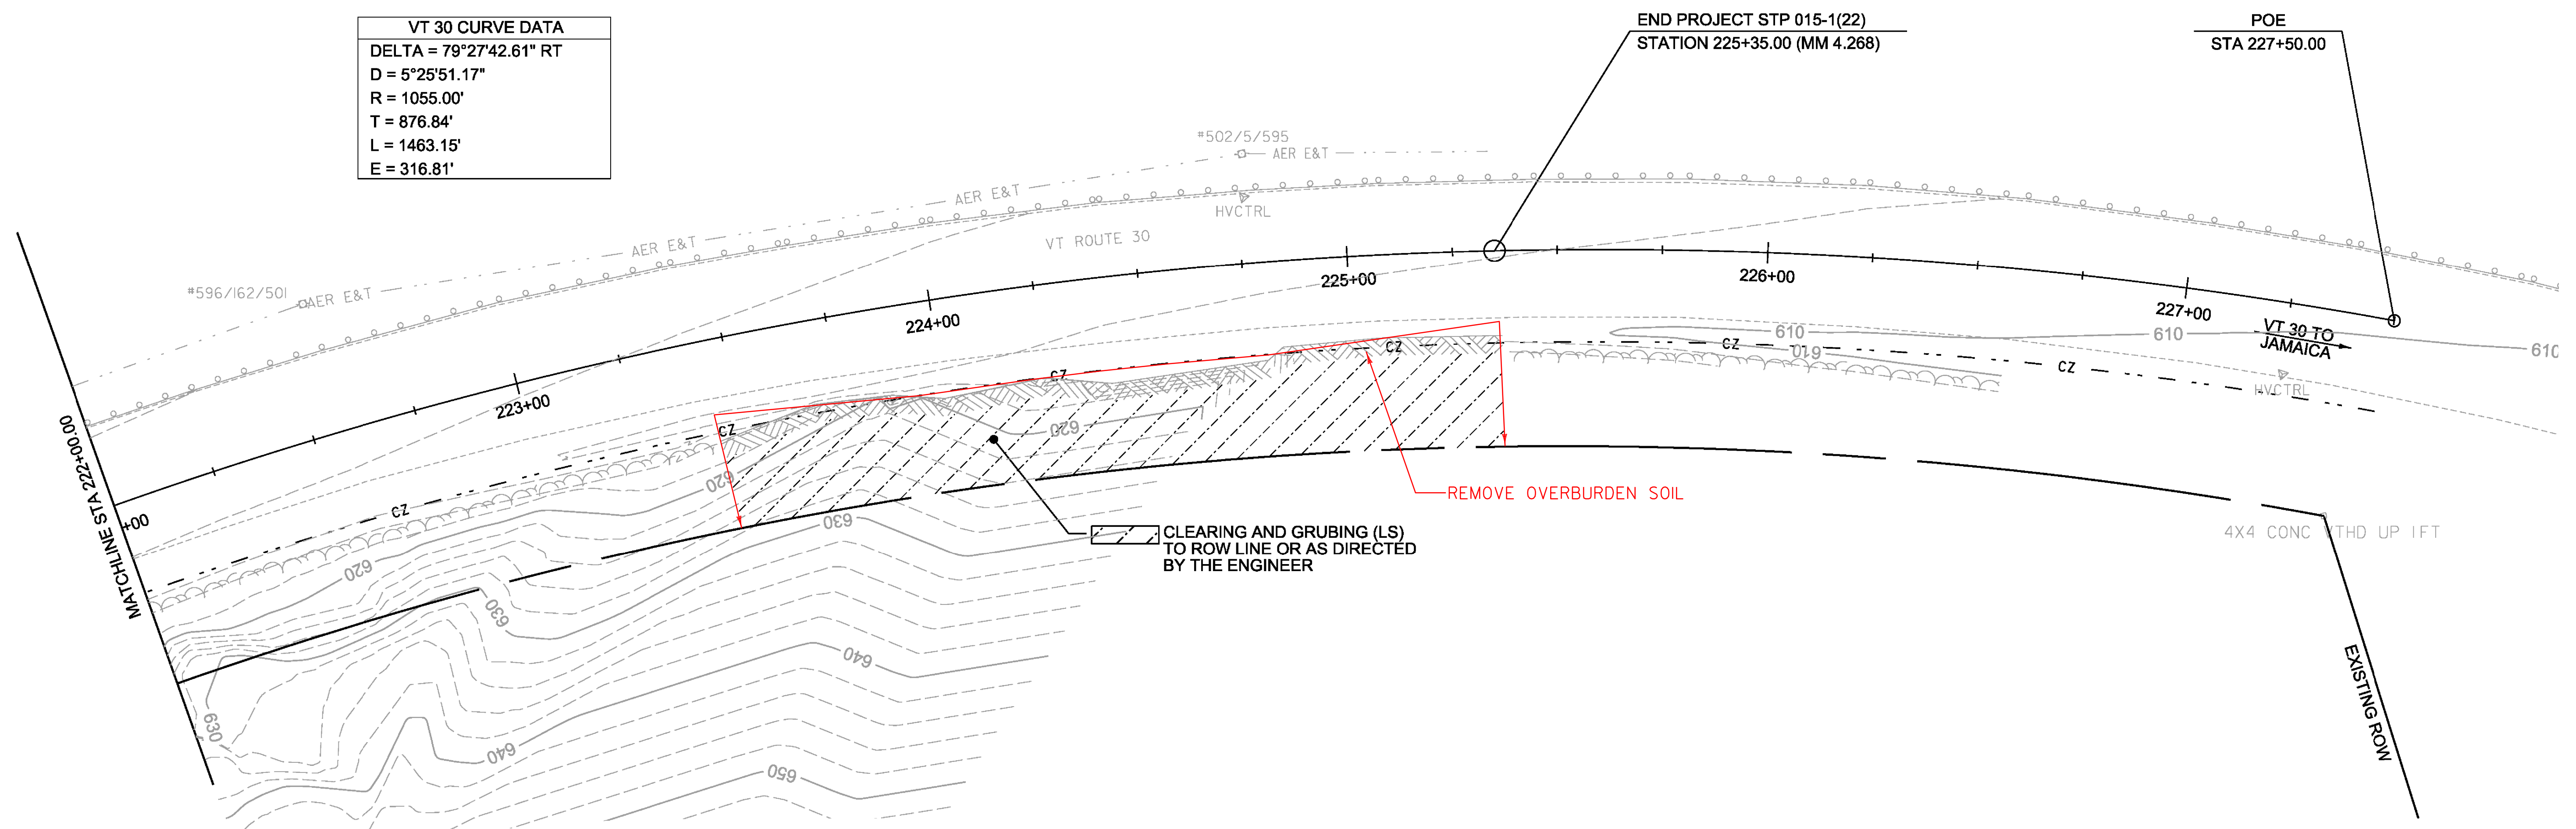

CLEARING AND GRUBBING
STA 223+44 - STA 225+35 RT

SPECIAL PROVISION (HAND SCALING)
STA 223+44 - STA 225+35 RT

SPECIAL PROVISION (MACHINE SCALING)
STA 223+44 - STA 225+35 RT



PROJECT NAME:	TOWNSHEND
PROJECT NUMBER:	STP 015-1(22)
FILE NAME:	dlib050bdr.dgn
PROJECT LEADER:	K. UPMAL
DESIGNED BY:	C. LEACH
PLAN SHEET	3
PLOT DATE:	1/9/2015
DRAWN BY:	C. LEACH
CHECKED BY:	B. KIPP
SHEET	II OF 34