


VT 30 CURVE DATA
 DELTA = 79°27'42.61" RT
 D = 5°25'51.17"
 R = 1055.00'
 T = 876.84'
 L = 1463.15'
 E = 316.81'

SOIL INFORMATION:
 RAWSONVILLE-HOGBACK FINE SANDY LOAMS
 K-FACTOR = .49/.49, 25%-50% SLOPES
 HYDROLOGICAL SOIL GROUP: C

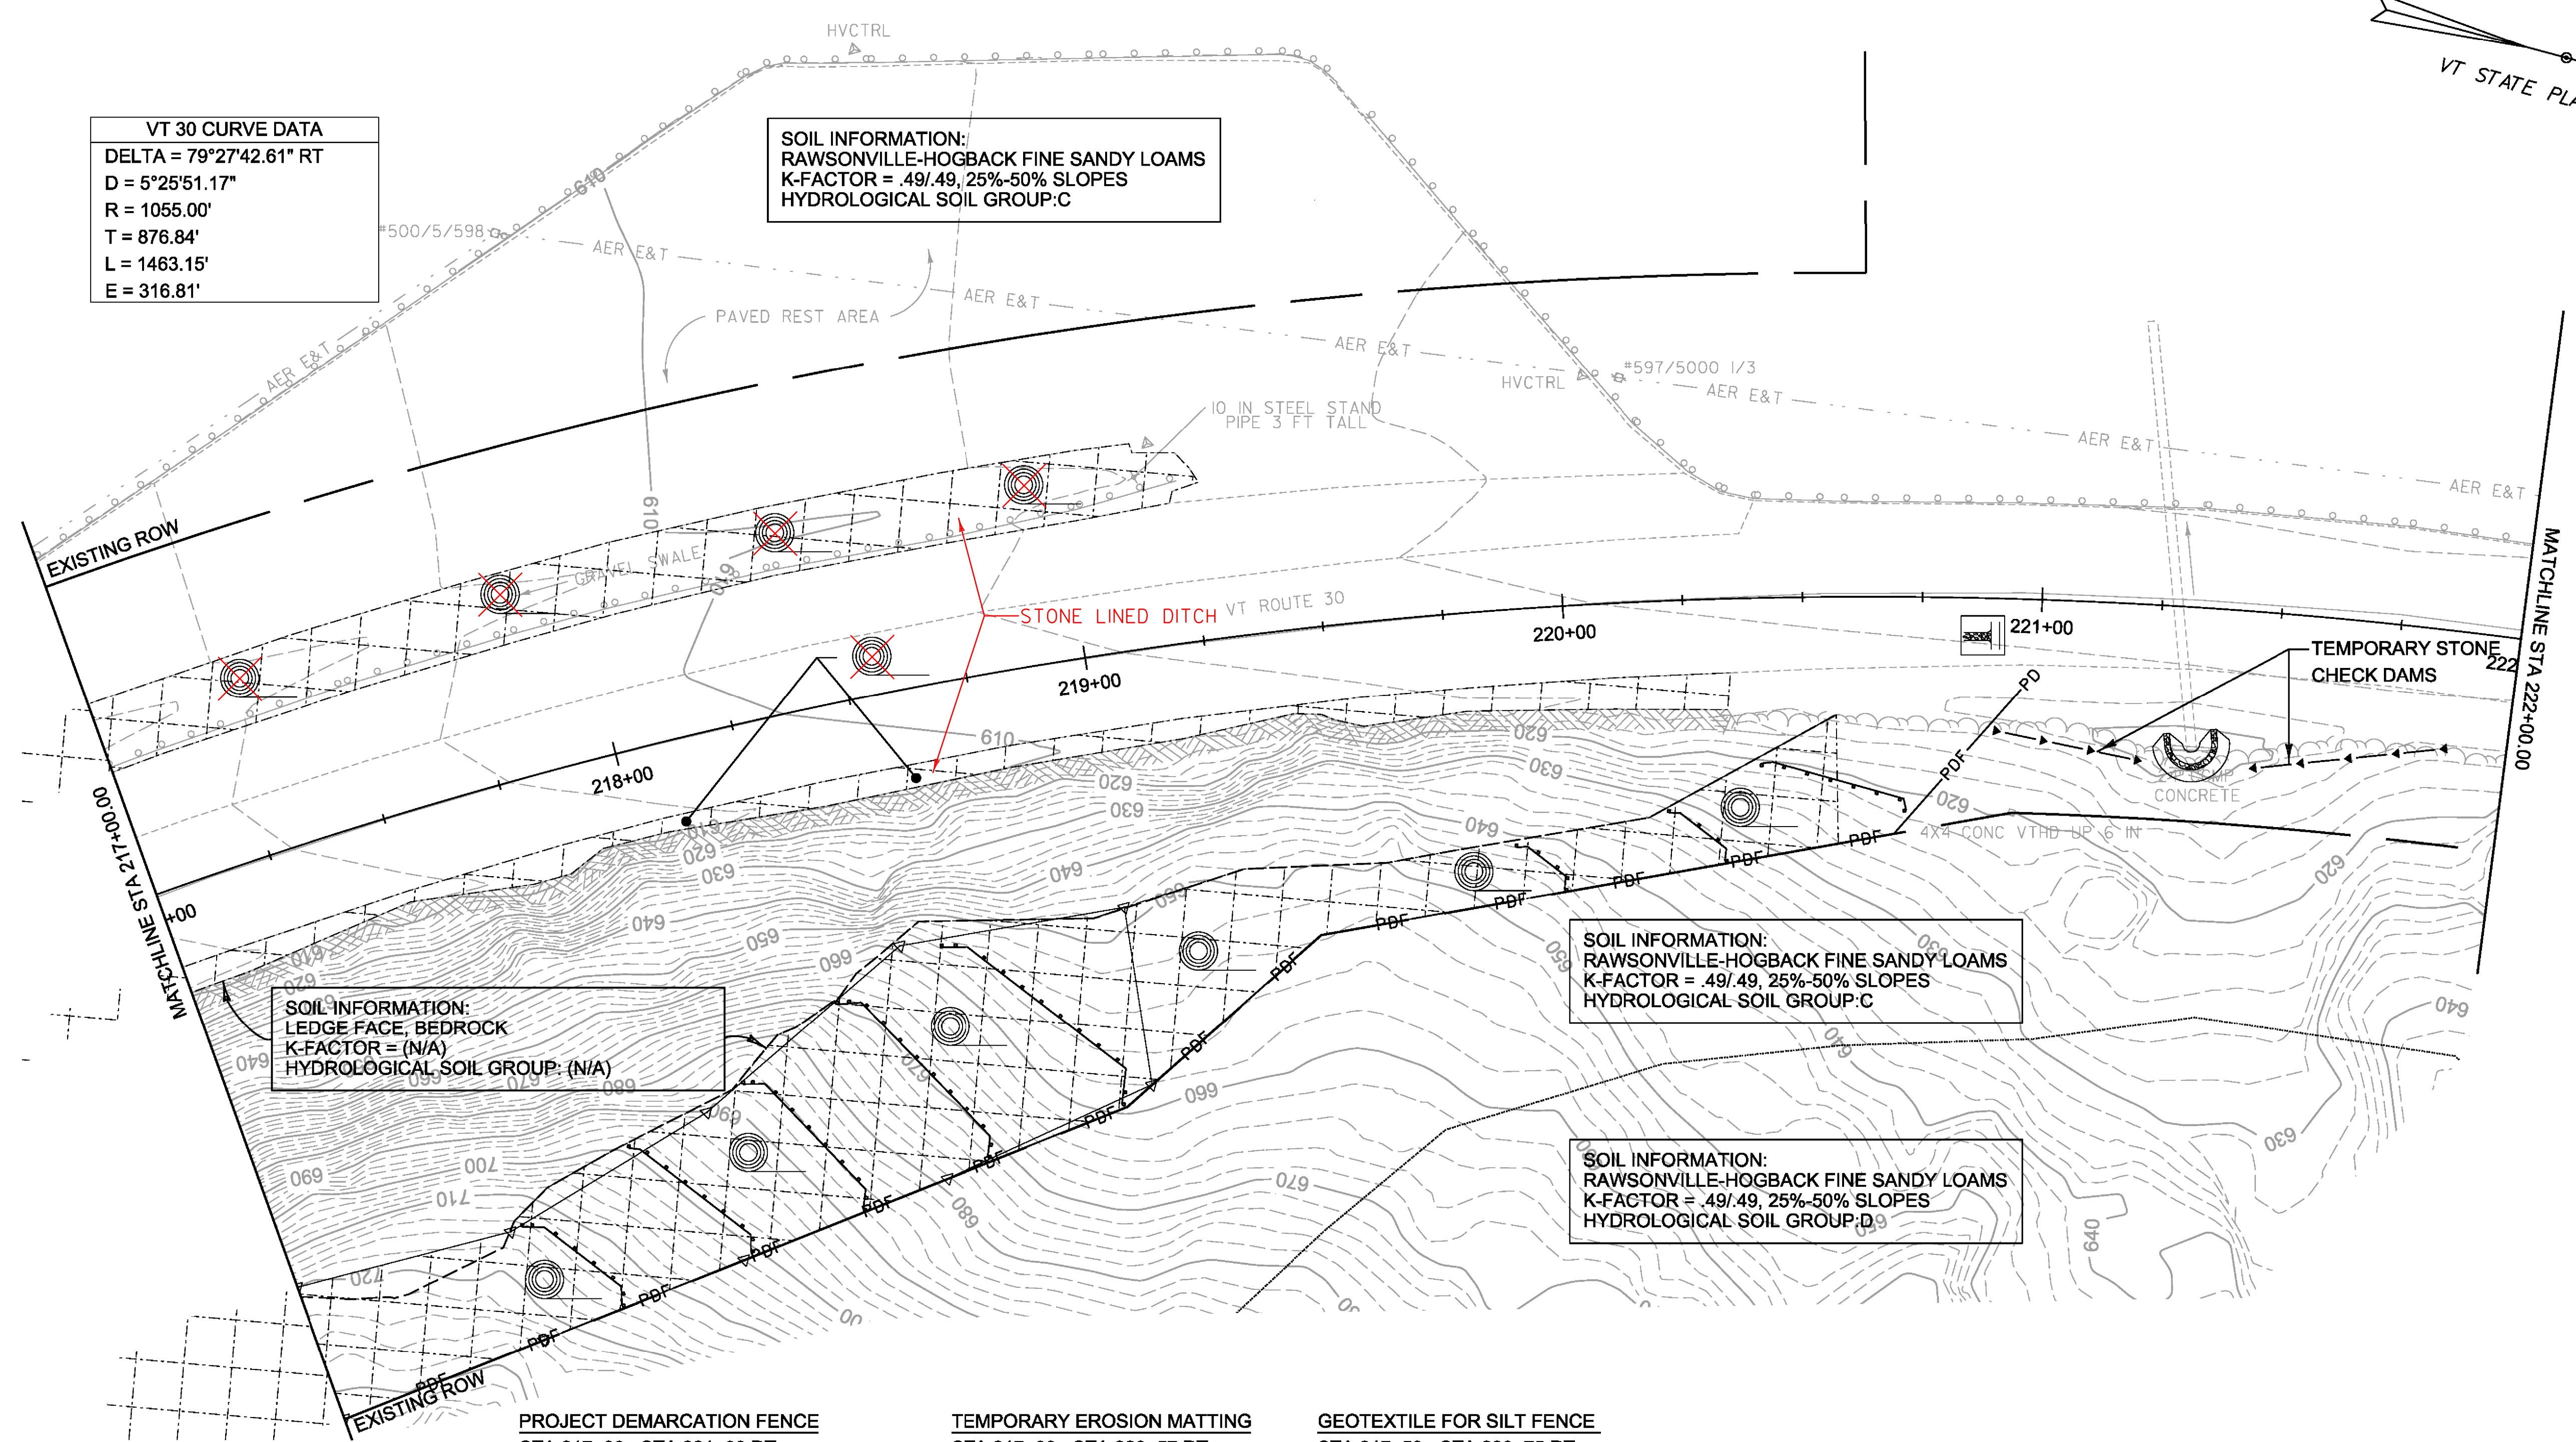


SOIL INFORMATION:
 LEDGE FACE, BEDROCK
 K-FACTOR = (N/A)
 HYDROLOGICAL SOIL GROUP: (N/A)

SOIL INFORMATION:
 RAWSONVILLE-HOGBACK FINE SANDY LOAMS
 K-FACTOR = .49/.49, 25%-50% SLOPES
 HYDROLOGICAL SOIL GROUP: C

SOIL INFORMATION:
 RAWSONVILLE-HOGBACK FINE SANDY LOAMS
 K-FACTOR = .49/.49, 25%-50% SLOPES
 HYDROLOGICAL SOIL GROUP: D

- | | | |
|--|--|--|
| PROJECT DEMARCATION FENCE
STA 217+00 - STA 221+00 RT | TEMPORARY EROSION MATTING
STA 217+00 - STA 220+57 RT
STA 217+00 - STA 219+27 LT | GEOTEXTILE FOR SILT FENCE
STA 217+53 - STA 220+75 RT |
| TEMPORARY STONE CHECK DAM, TYPE I
STA 221+33 - STA 221+88 RT | VEHICLE TRACKING PAD
STA 220+87 RT | INLET PROTECTION DEVICE
STA 221+33 RT |

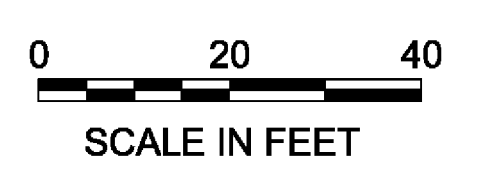

PROJECT NAME: TOWNSHEND	PLOT DATE: 2/12/2015
PROJECT NUMBER: STP 015-1(22)	DRAWN BY: C. LEACH
FILE NAME: dl1b050erobdr.dgn	CHECKED BY: B. KIPP
PROJECT LEADER: K. UPMAL	SHEET 17 OF 34
DESIGNED BY: C. LEACH	
EPSC PLAN SHEET 2	