


218+00

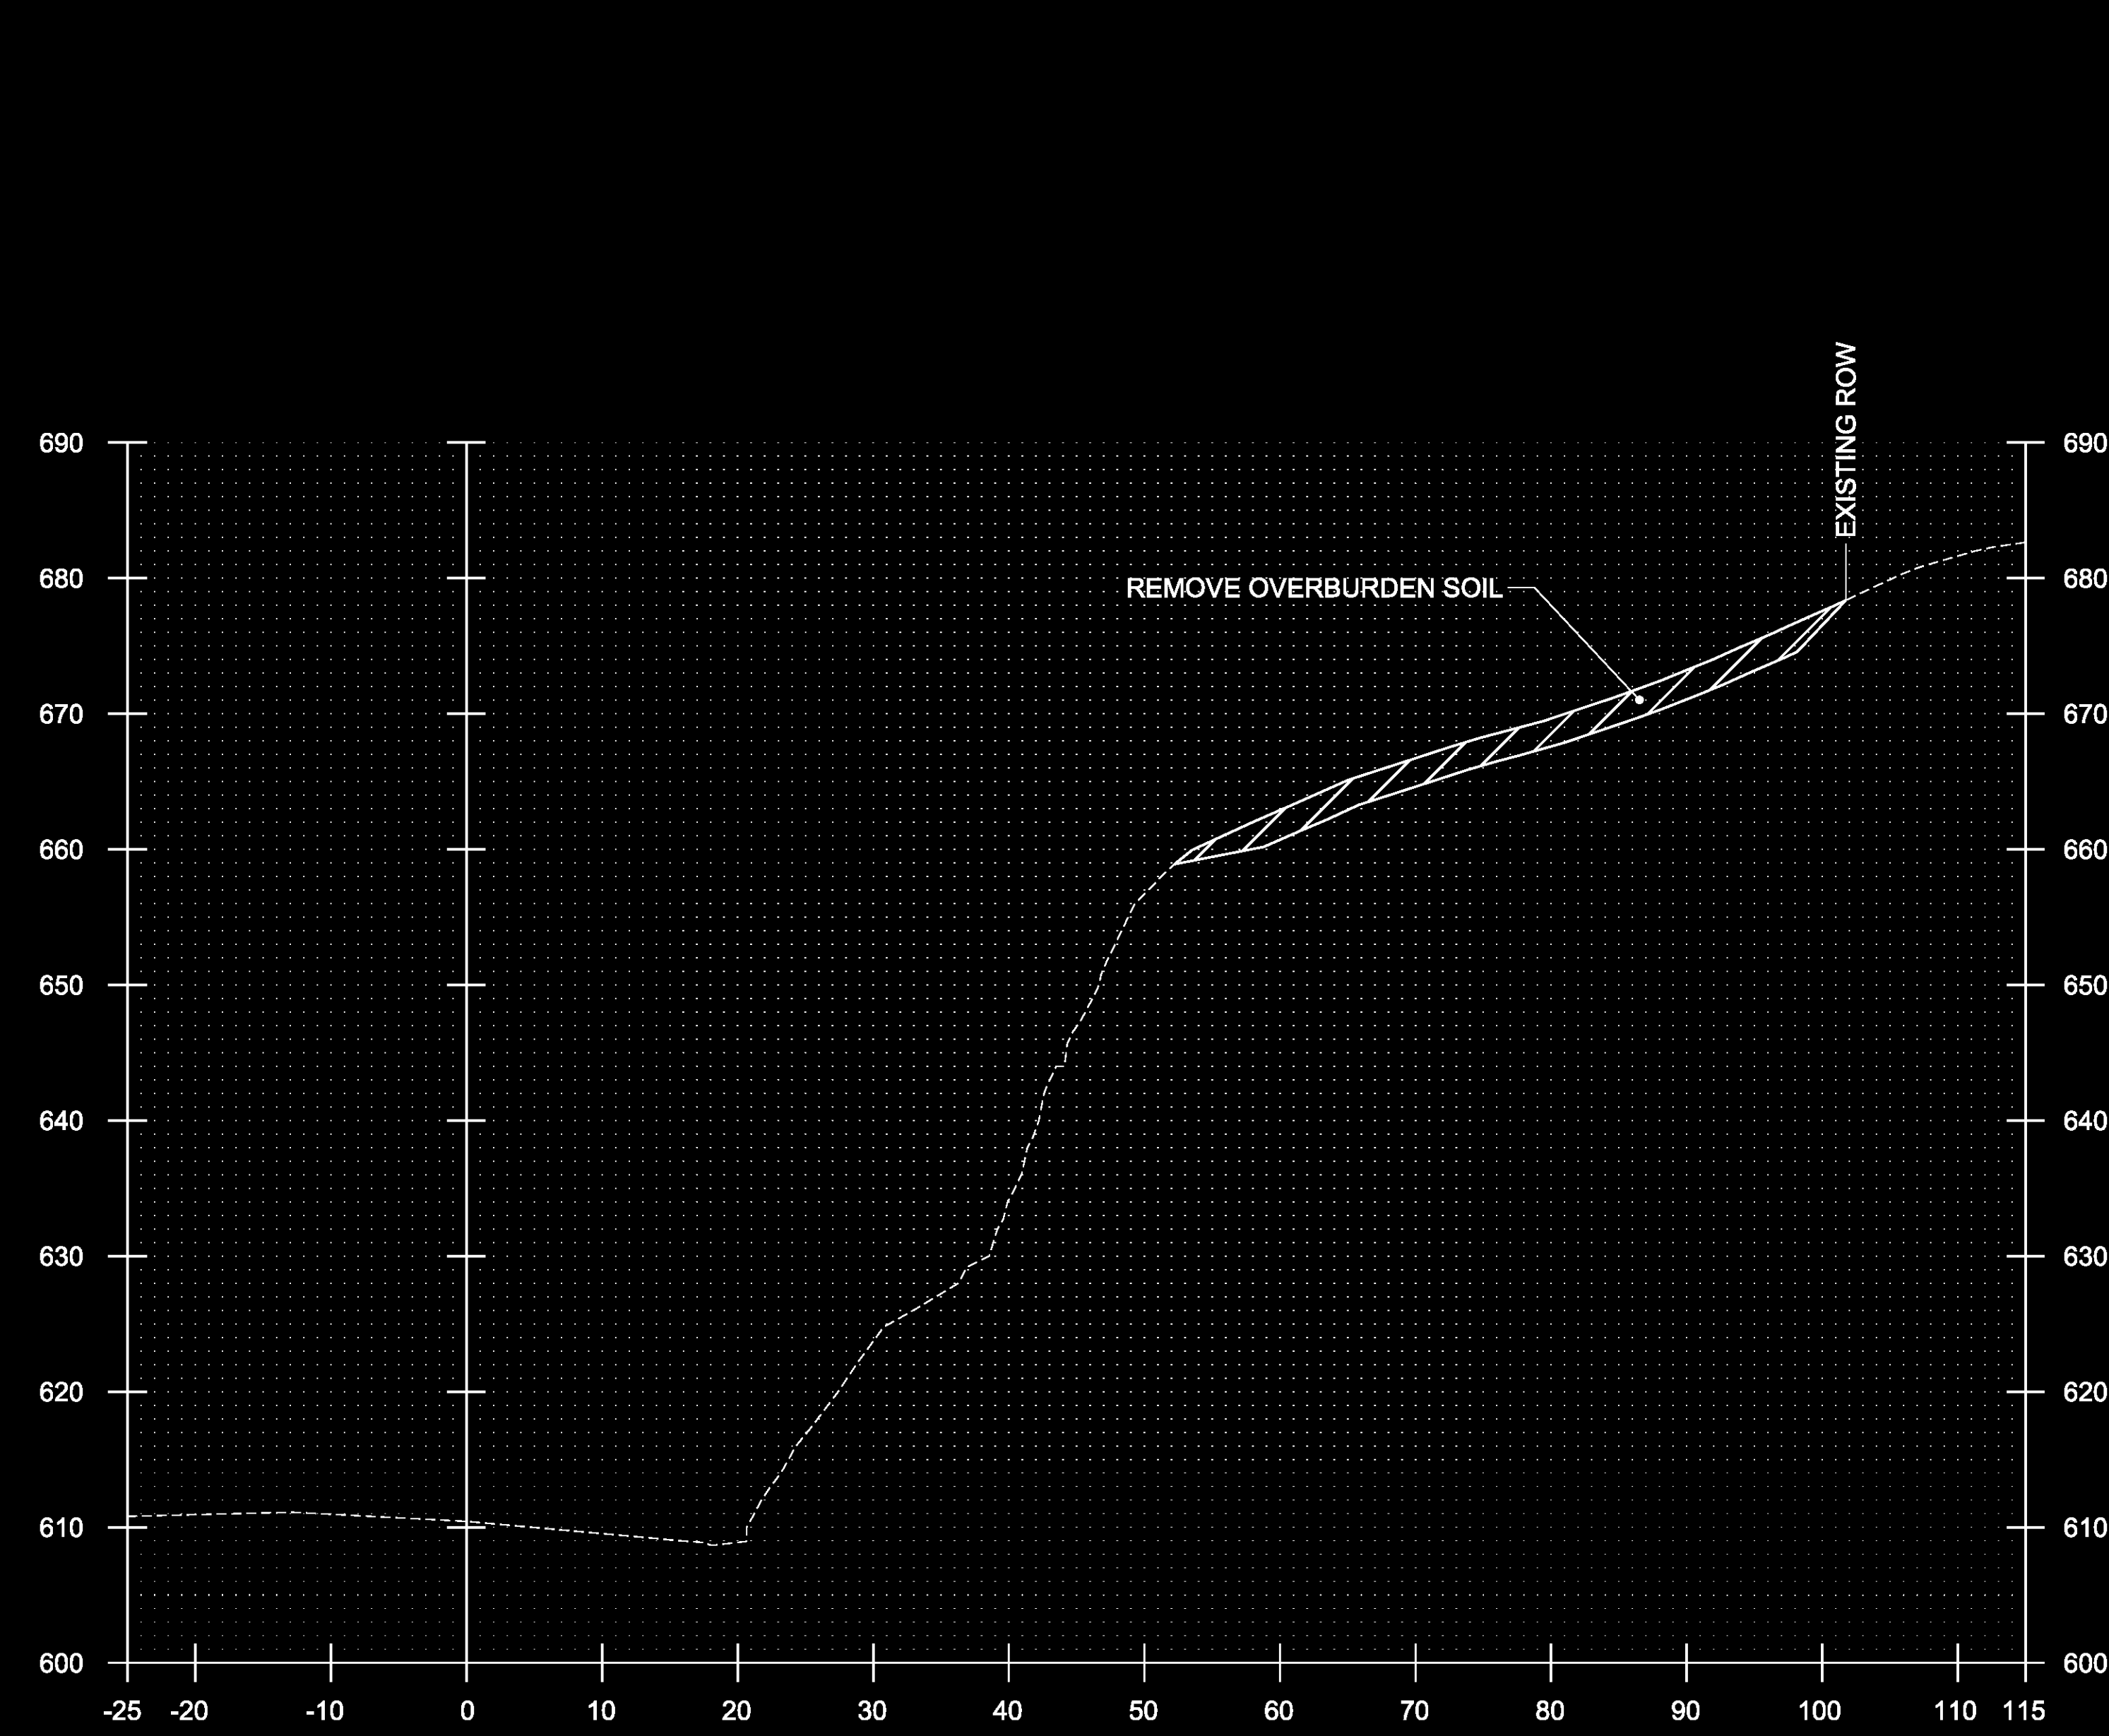

218+50

STA.218+00 TO STA.218+50

PROJECT NAME:	TOWNSHEND	PLOT DATE:	1/9/2015
PROJECT NUMBER:	STP 015-1(22)	DRAWN BY:	B. KIPP
FILE NAME:	dlib050xsc.dgn	CHECKED BY:	A. KEMPTON
PROJECT LEADER:	K. UPMAL	SHEET	23 OF 34
DESIGNED BY:	C. LEACH	CROSS SECTIONS	5