


219+00

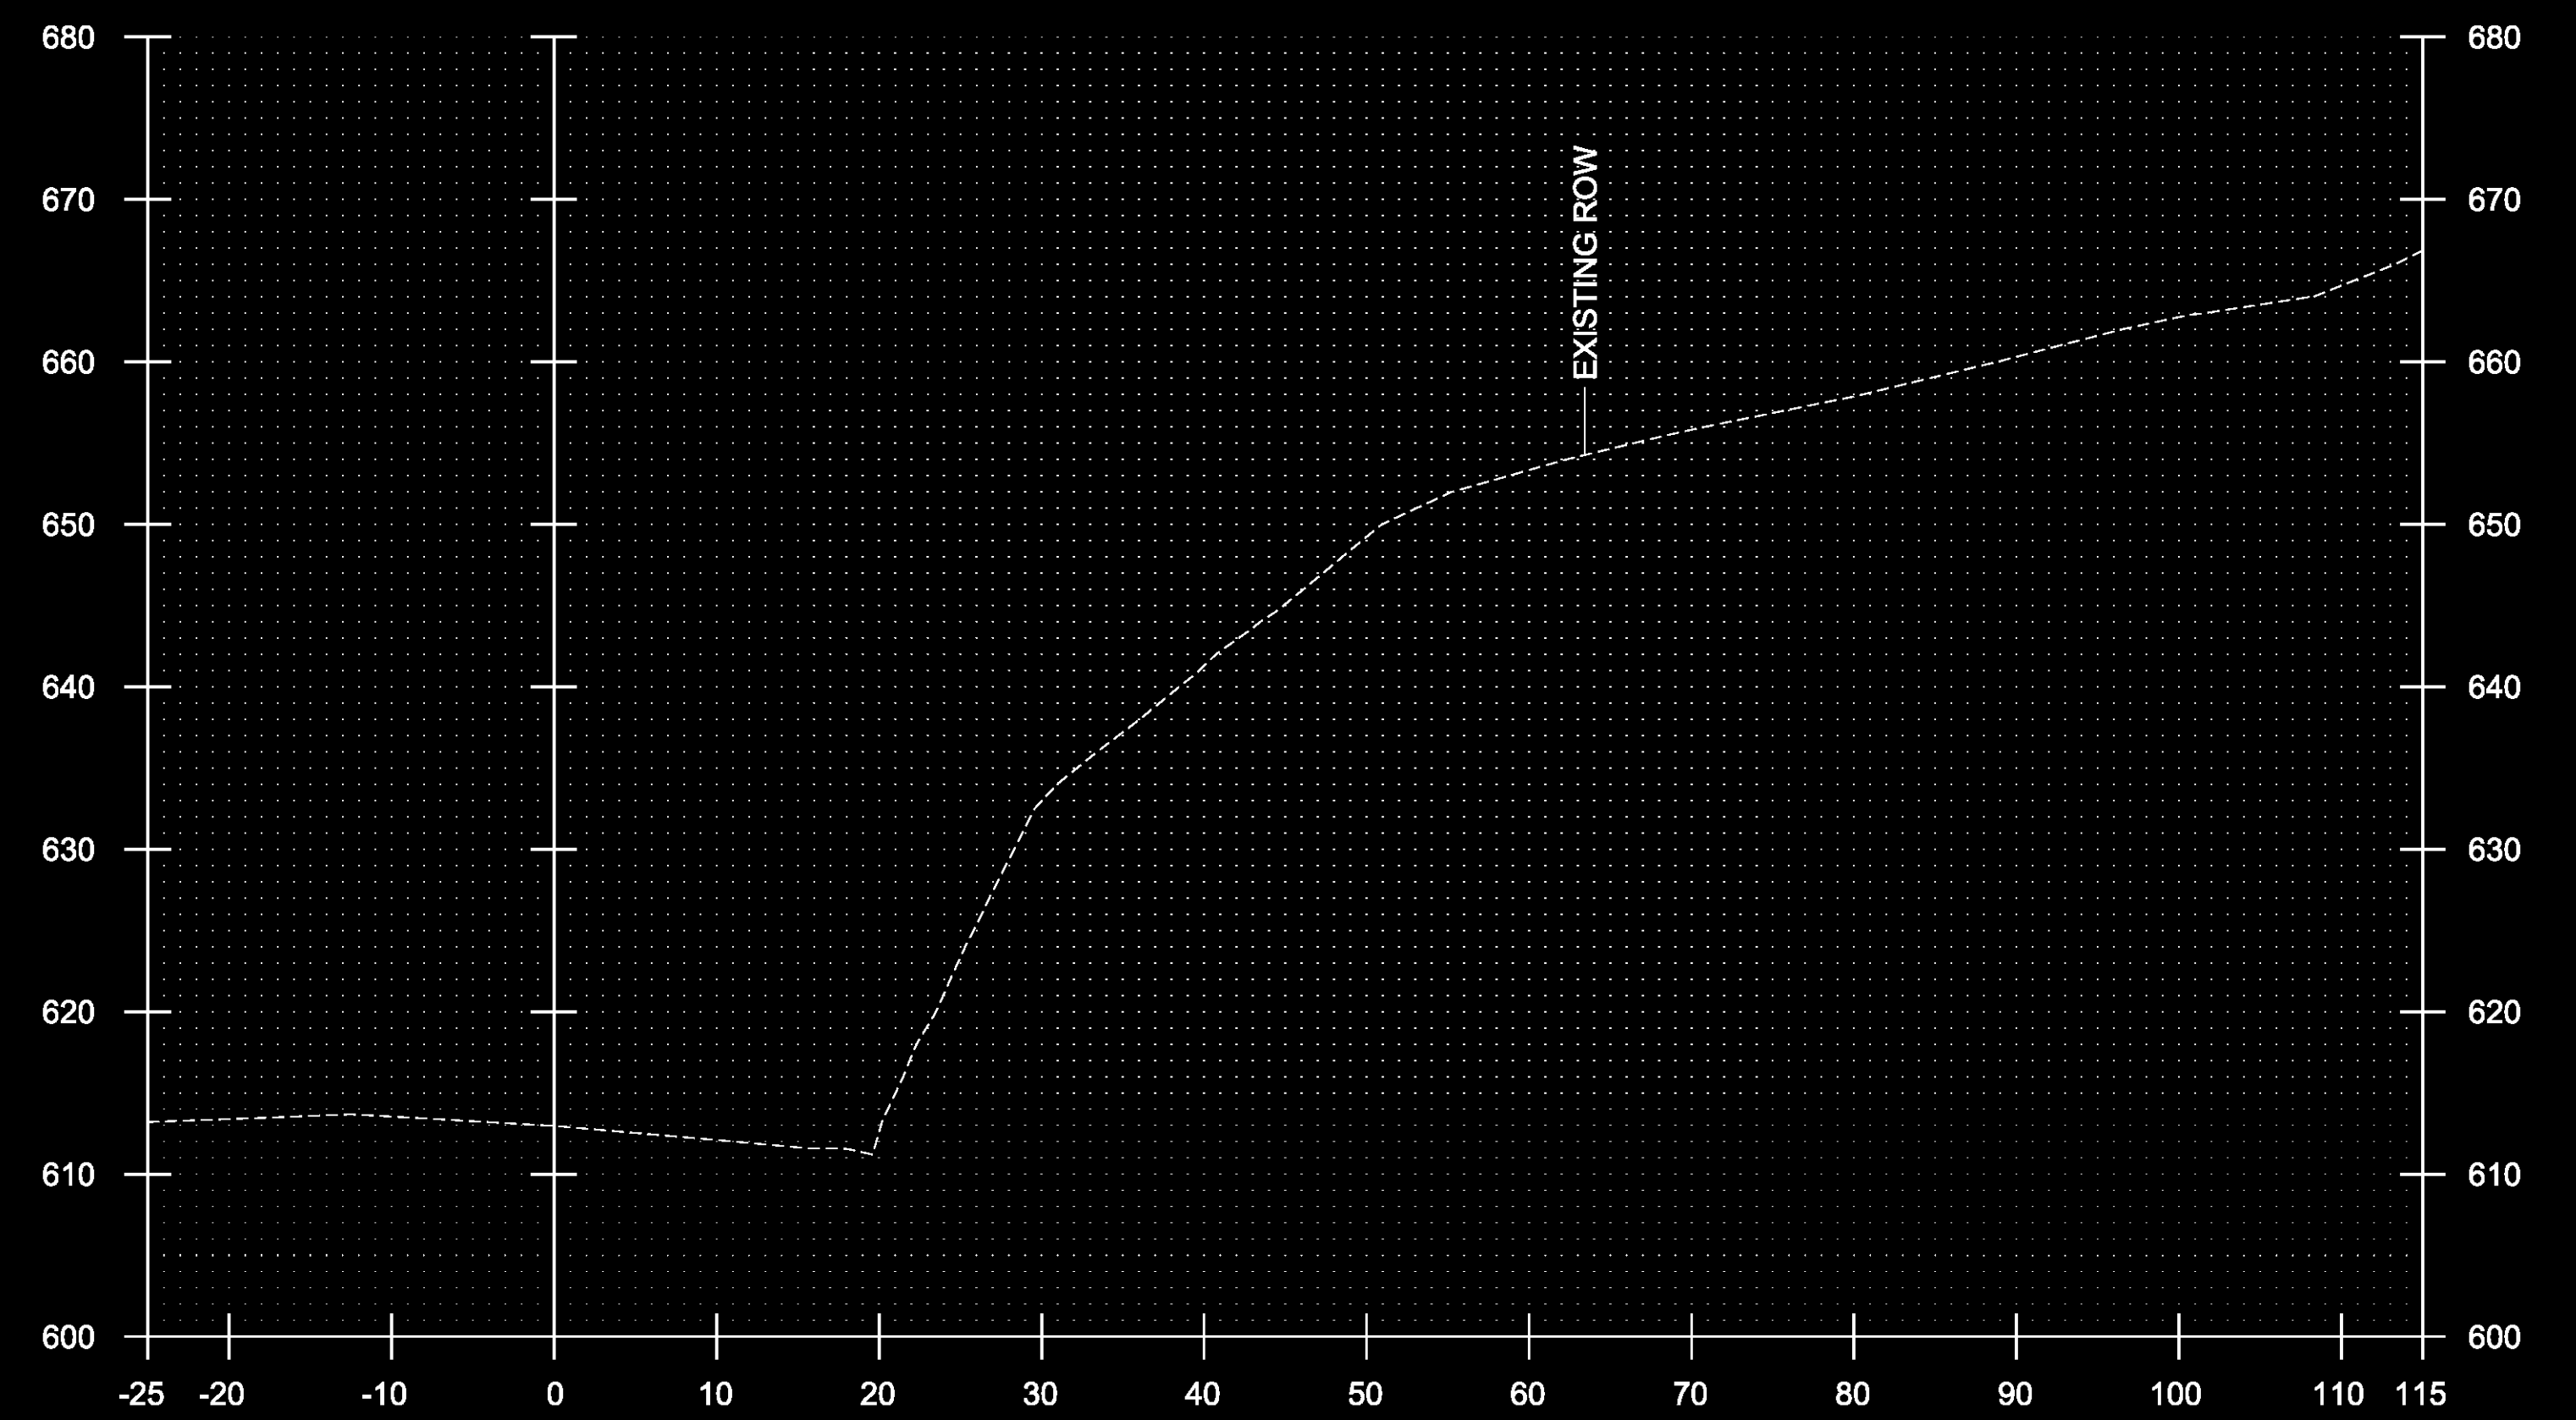

219+50

STA.219+00 TO STA.219+50

PROJECT NAME: TOWNSHEND	PLOT DATE: 1/9/2015
PROJECT NUMBER: STP 015-1(22)	DRAWN BY: B. KIPP
FILE NAME: dlib050xsc.dgn	CHECKED BY: A. KEMPTON
PROJECT LEADER: K. UPMAL	SHEET 24 OF 34
DESIGNED BY: C. LEACH	
CROSS SECTIONS 6	