




220+50

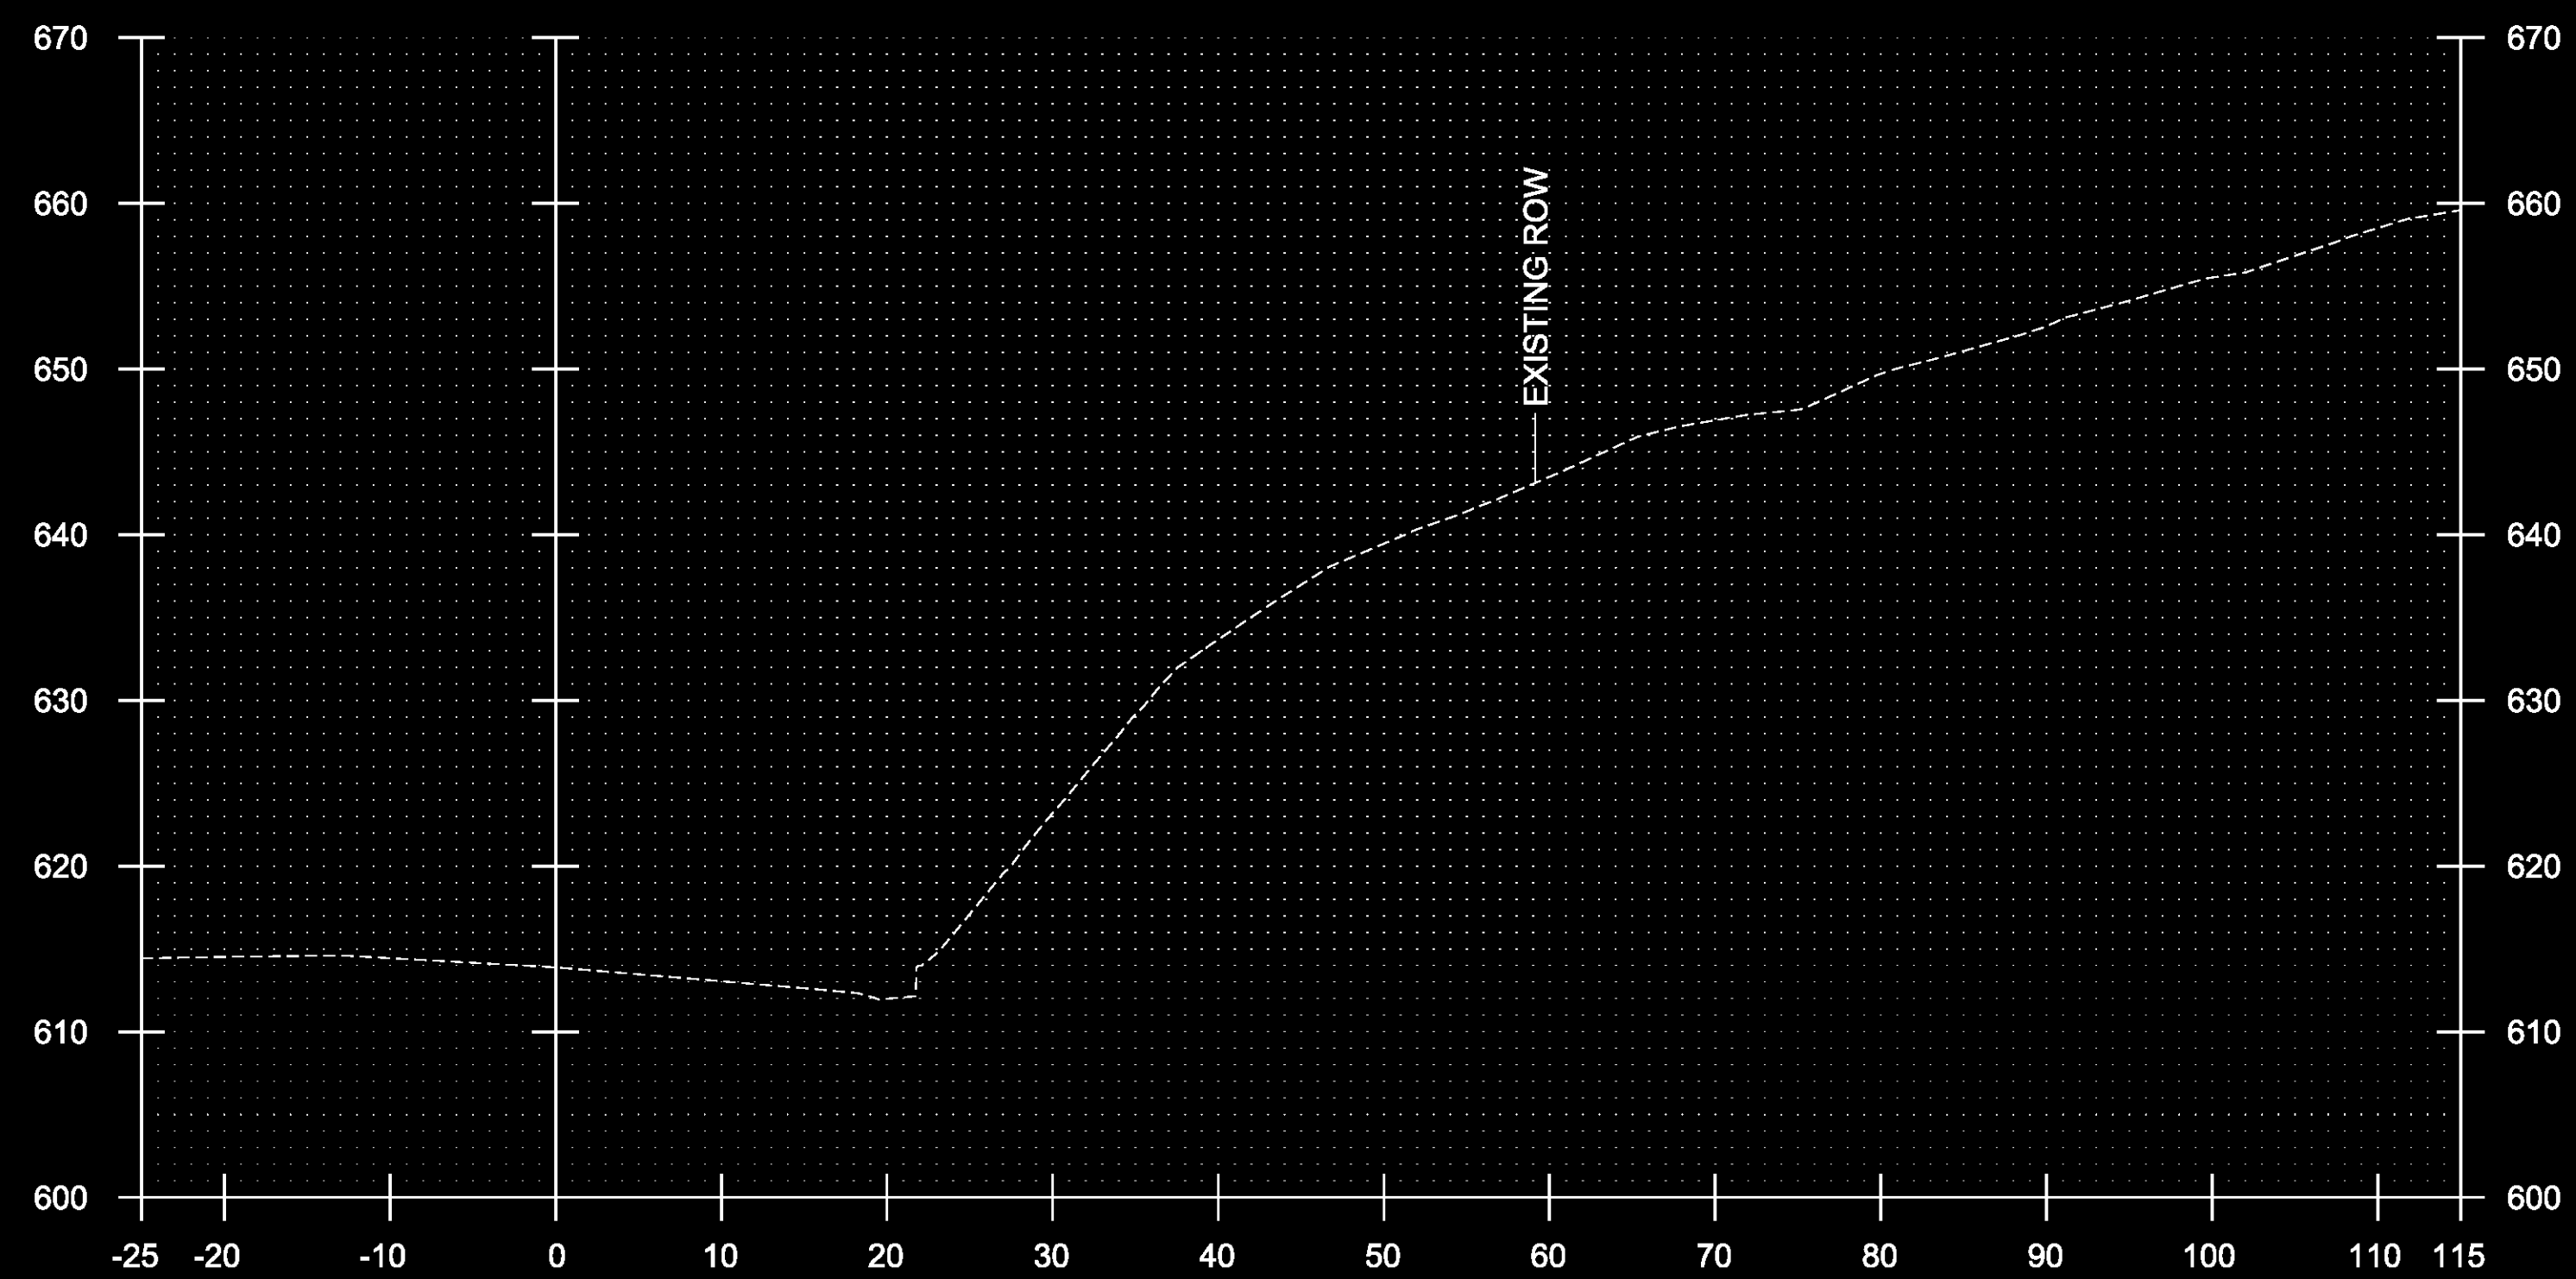

220+00

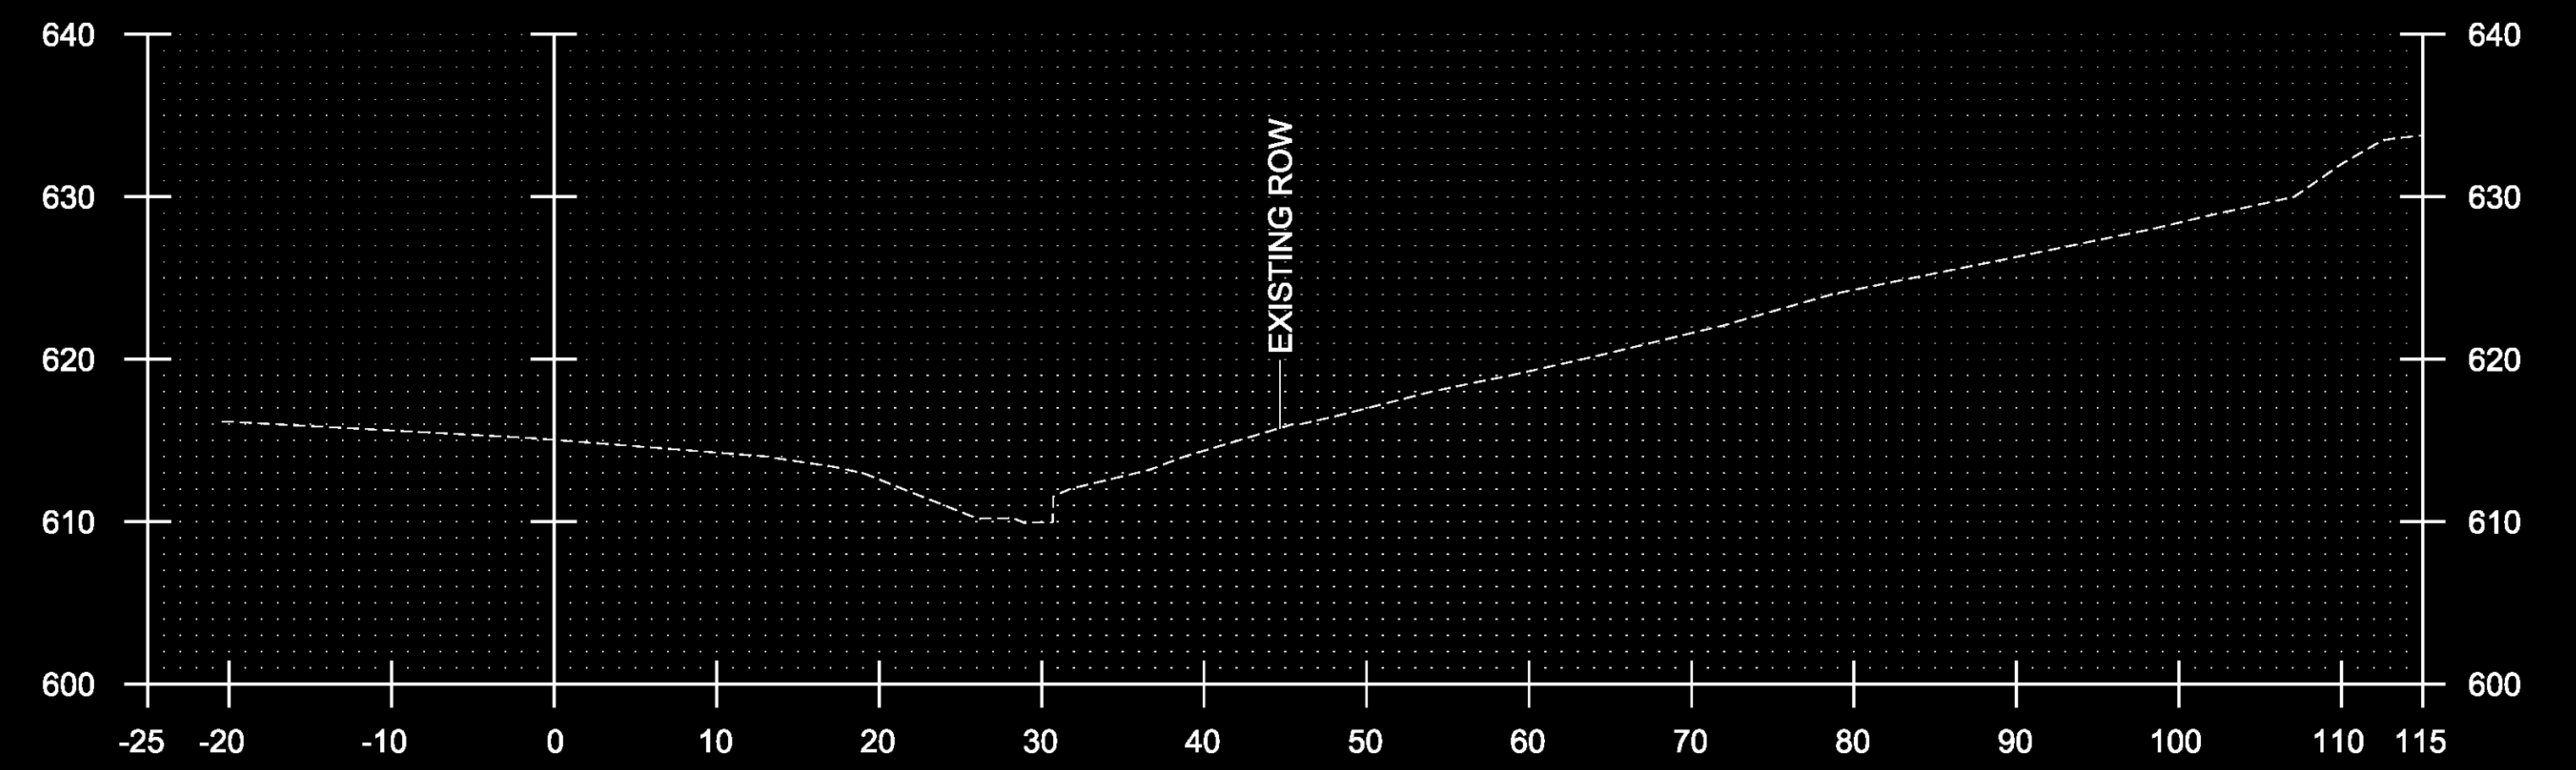

221+50

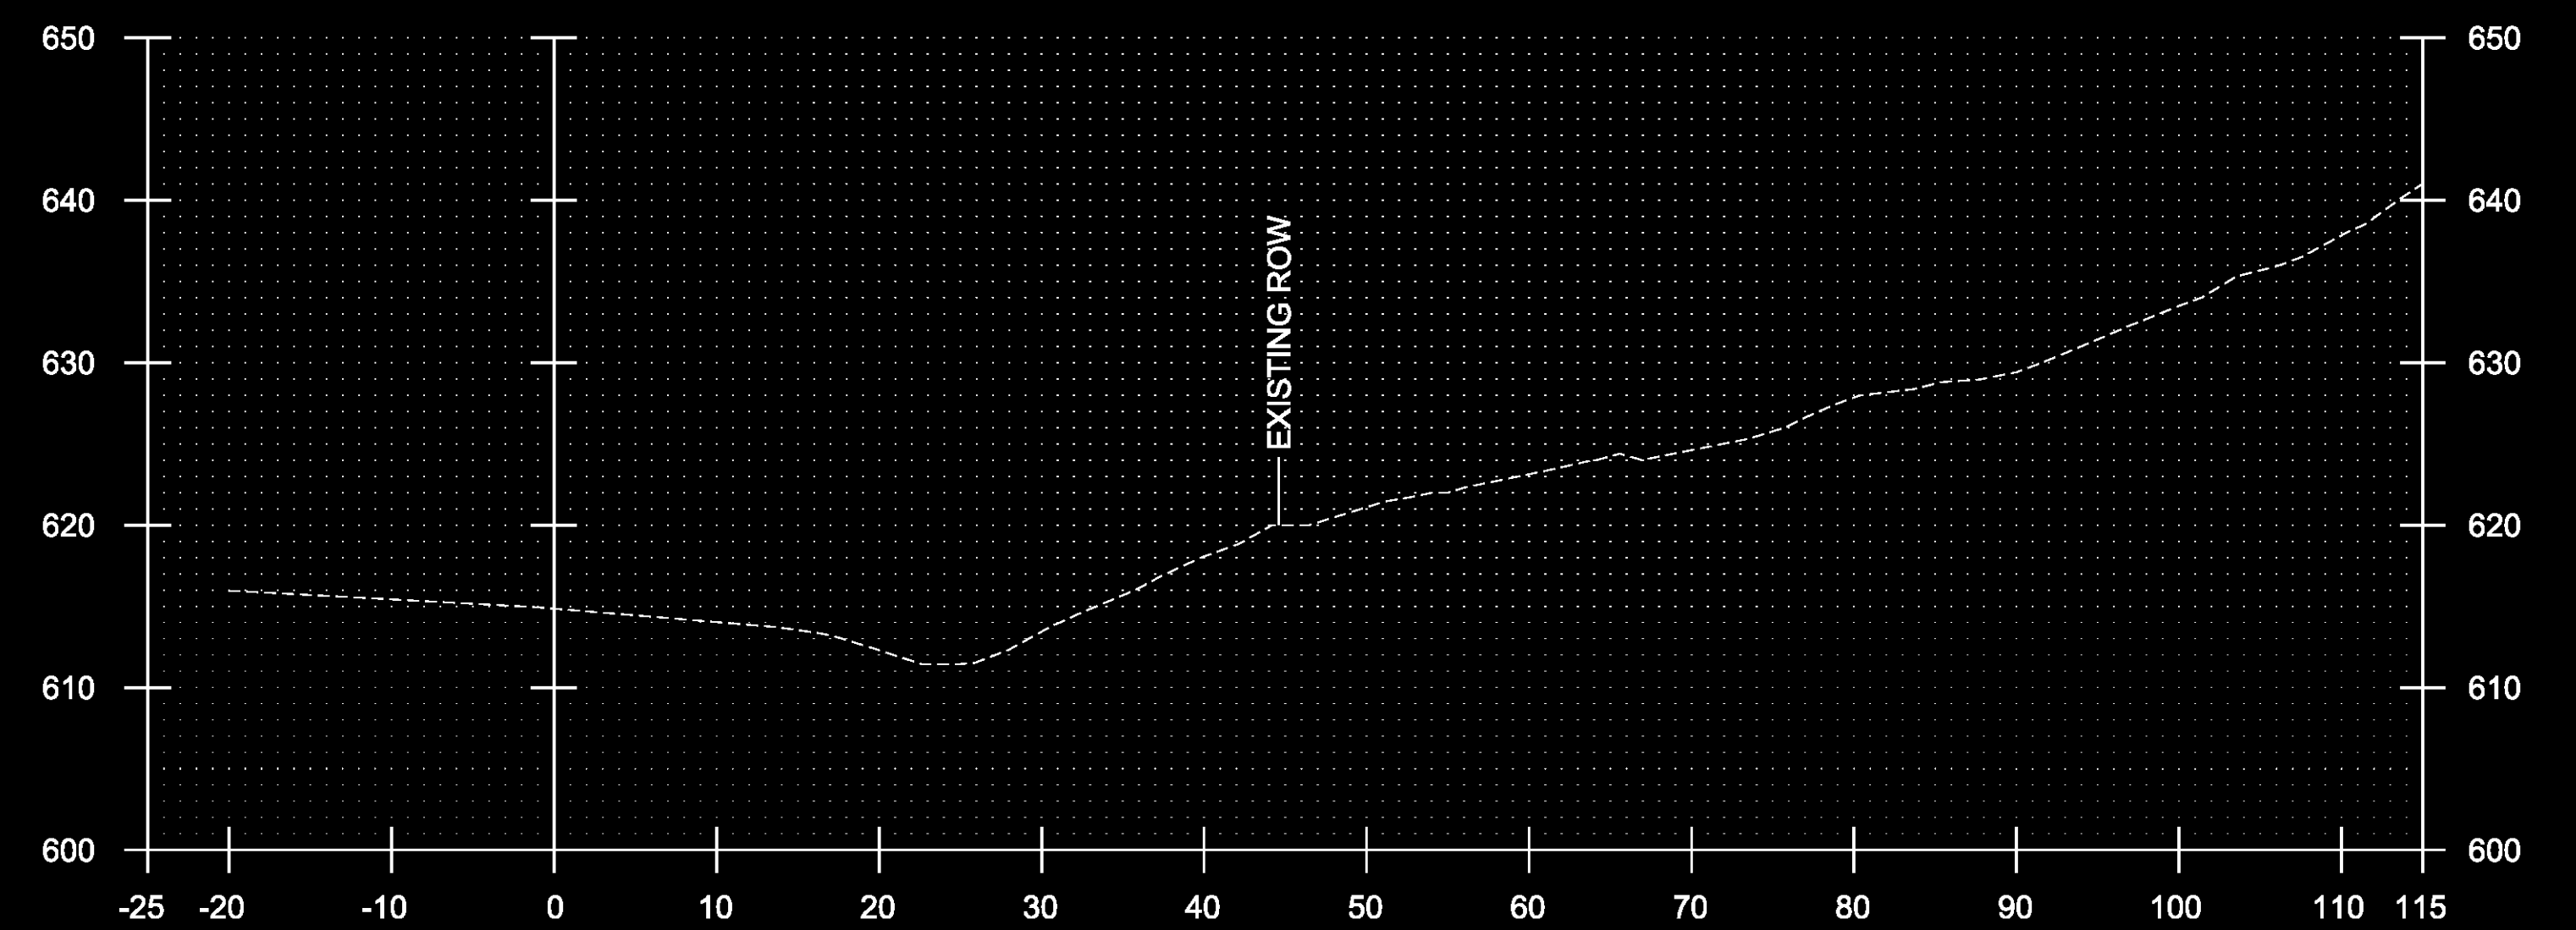

221+00

STA.220+00 TO STA.221+50

PROJECT NAME:	TOWNSHEND	PLOT DATE:	1/9/2015
PROJECT NUMBER:	STP 013-1(17)	DRAWN BY:	B. KIPP
FILE NAME:	dlib050xsc.dgn	CHECKED BY:	A. KEMPTON
PROJECT LEADER:	K. UPMAL	SHEET	25 OF 34
DESIGNED BY:	C. LEACH	CROSS SECTIONS	7