




222+50

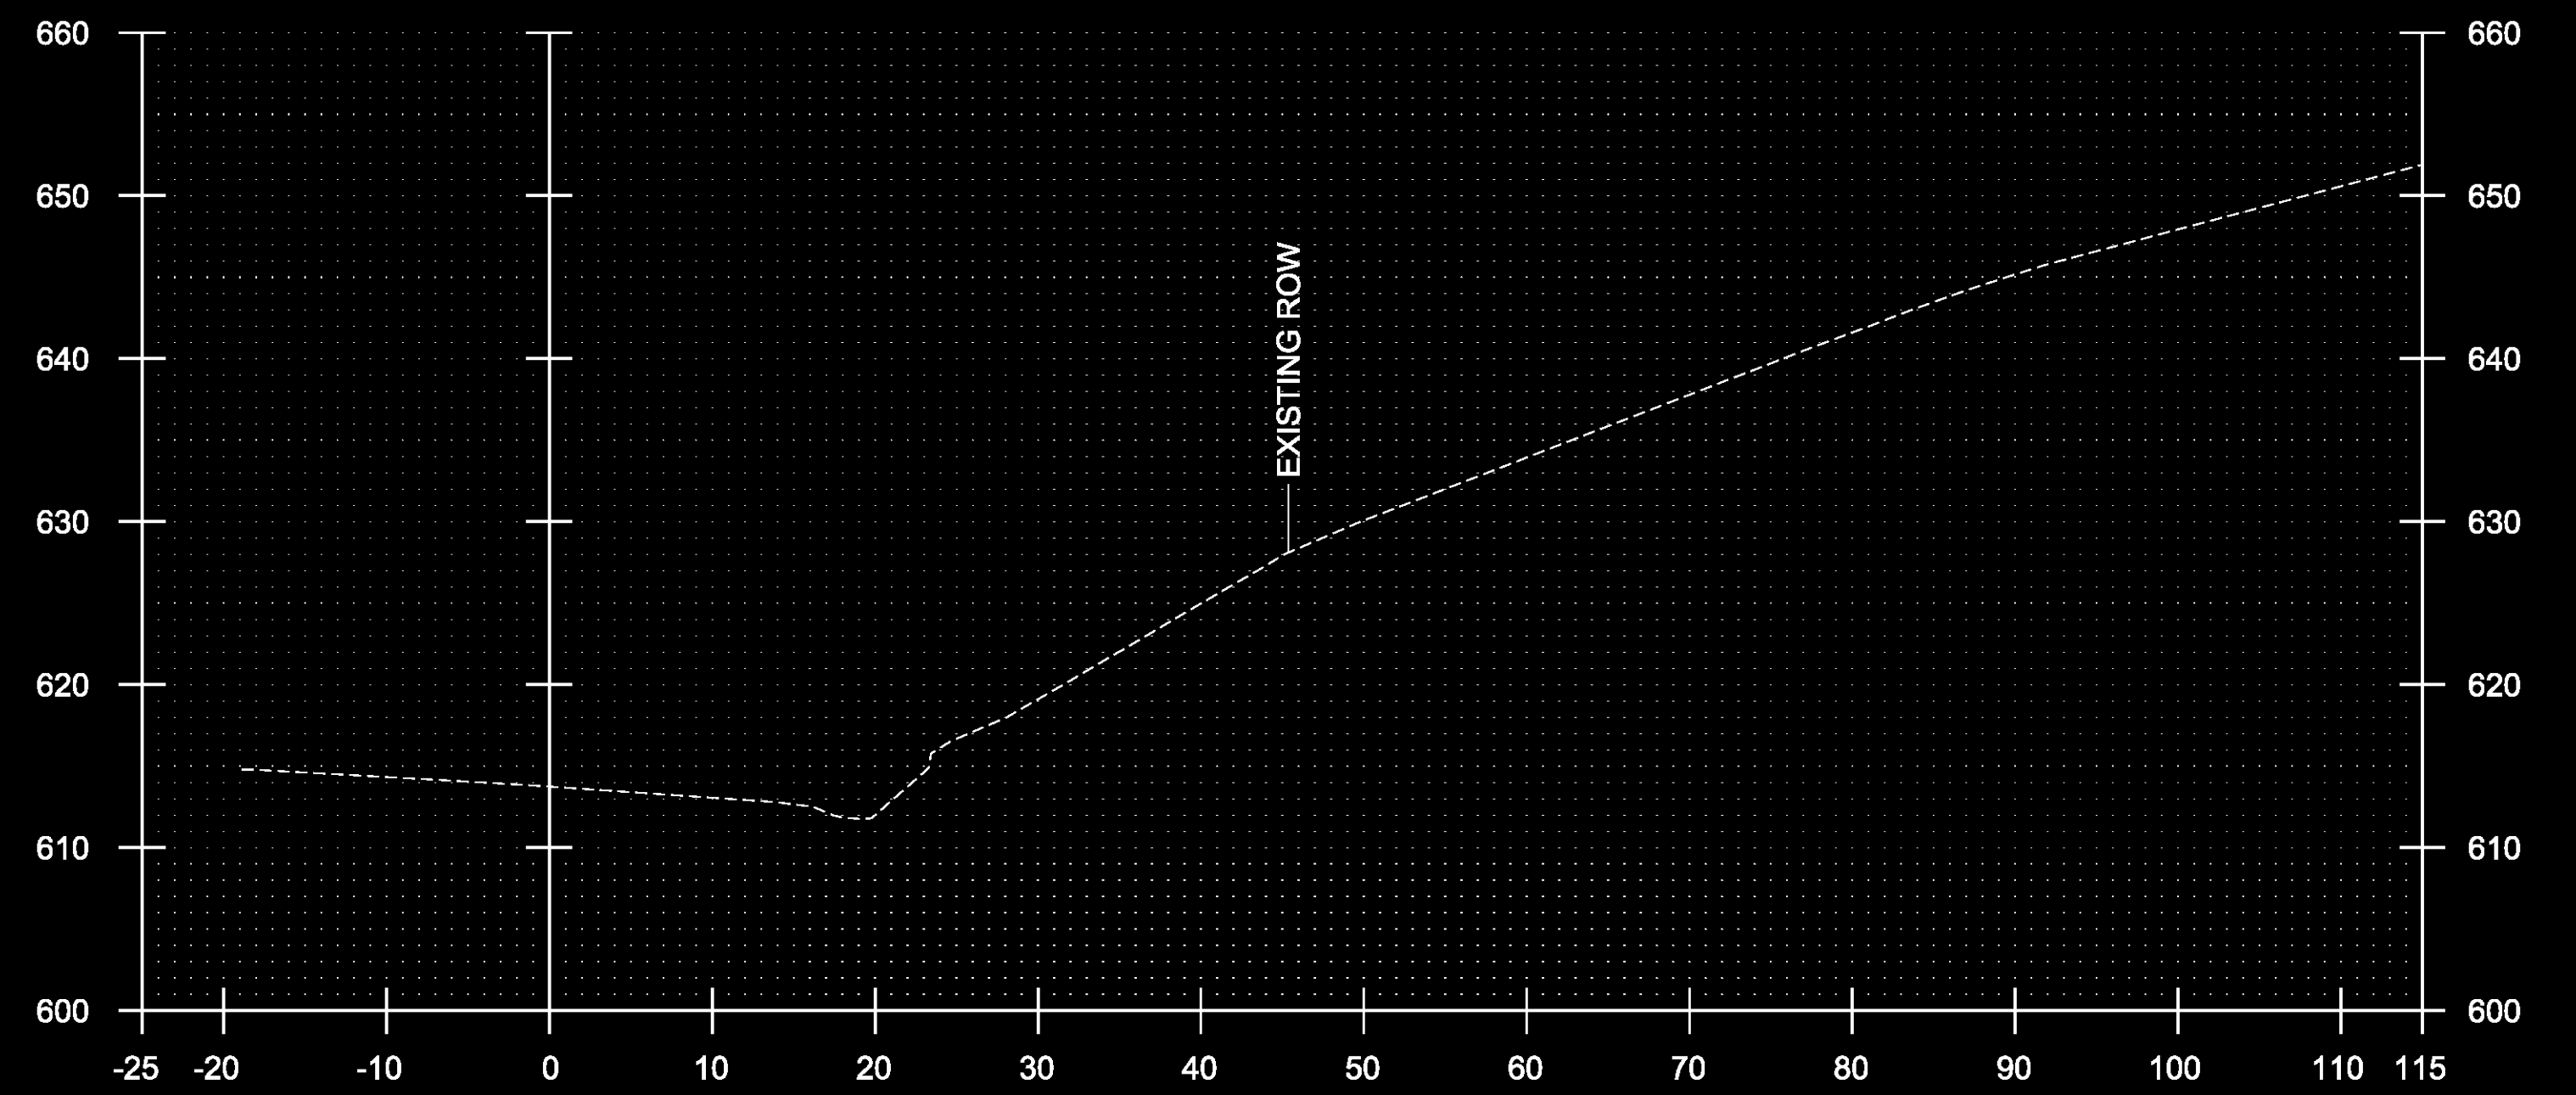

223+50

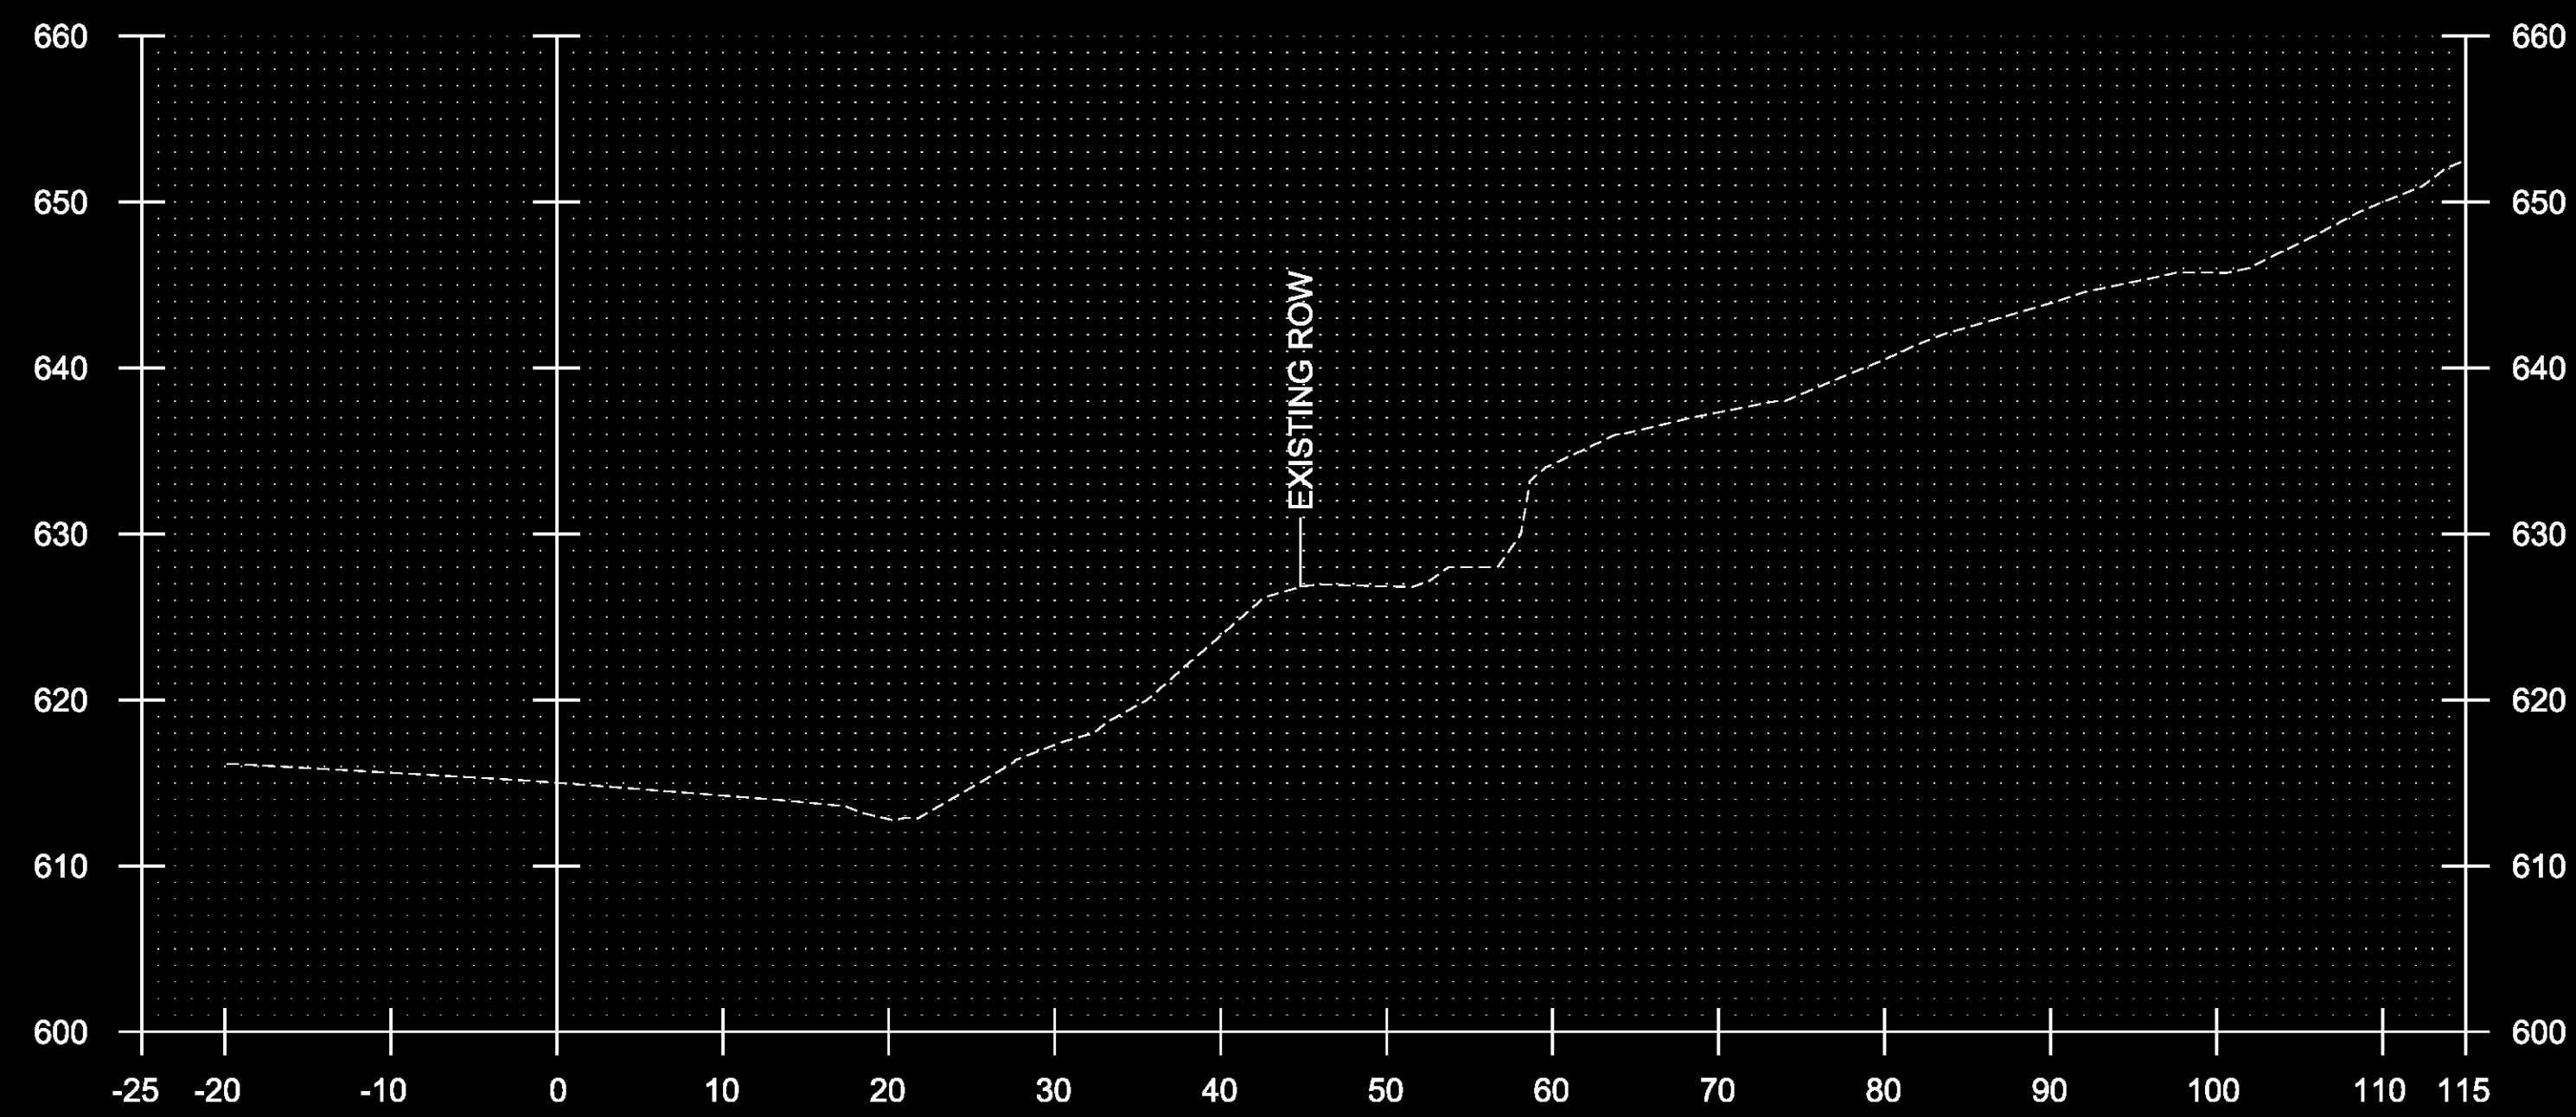

222+00

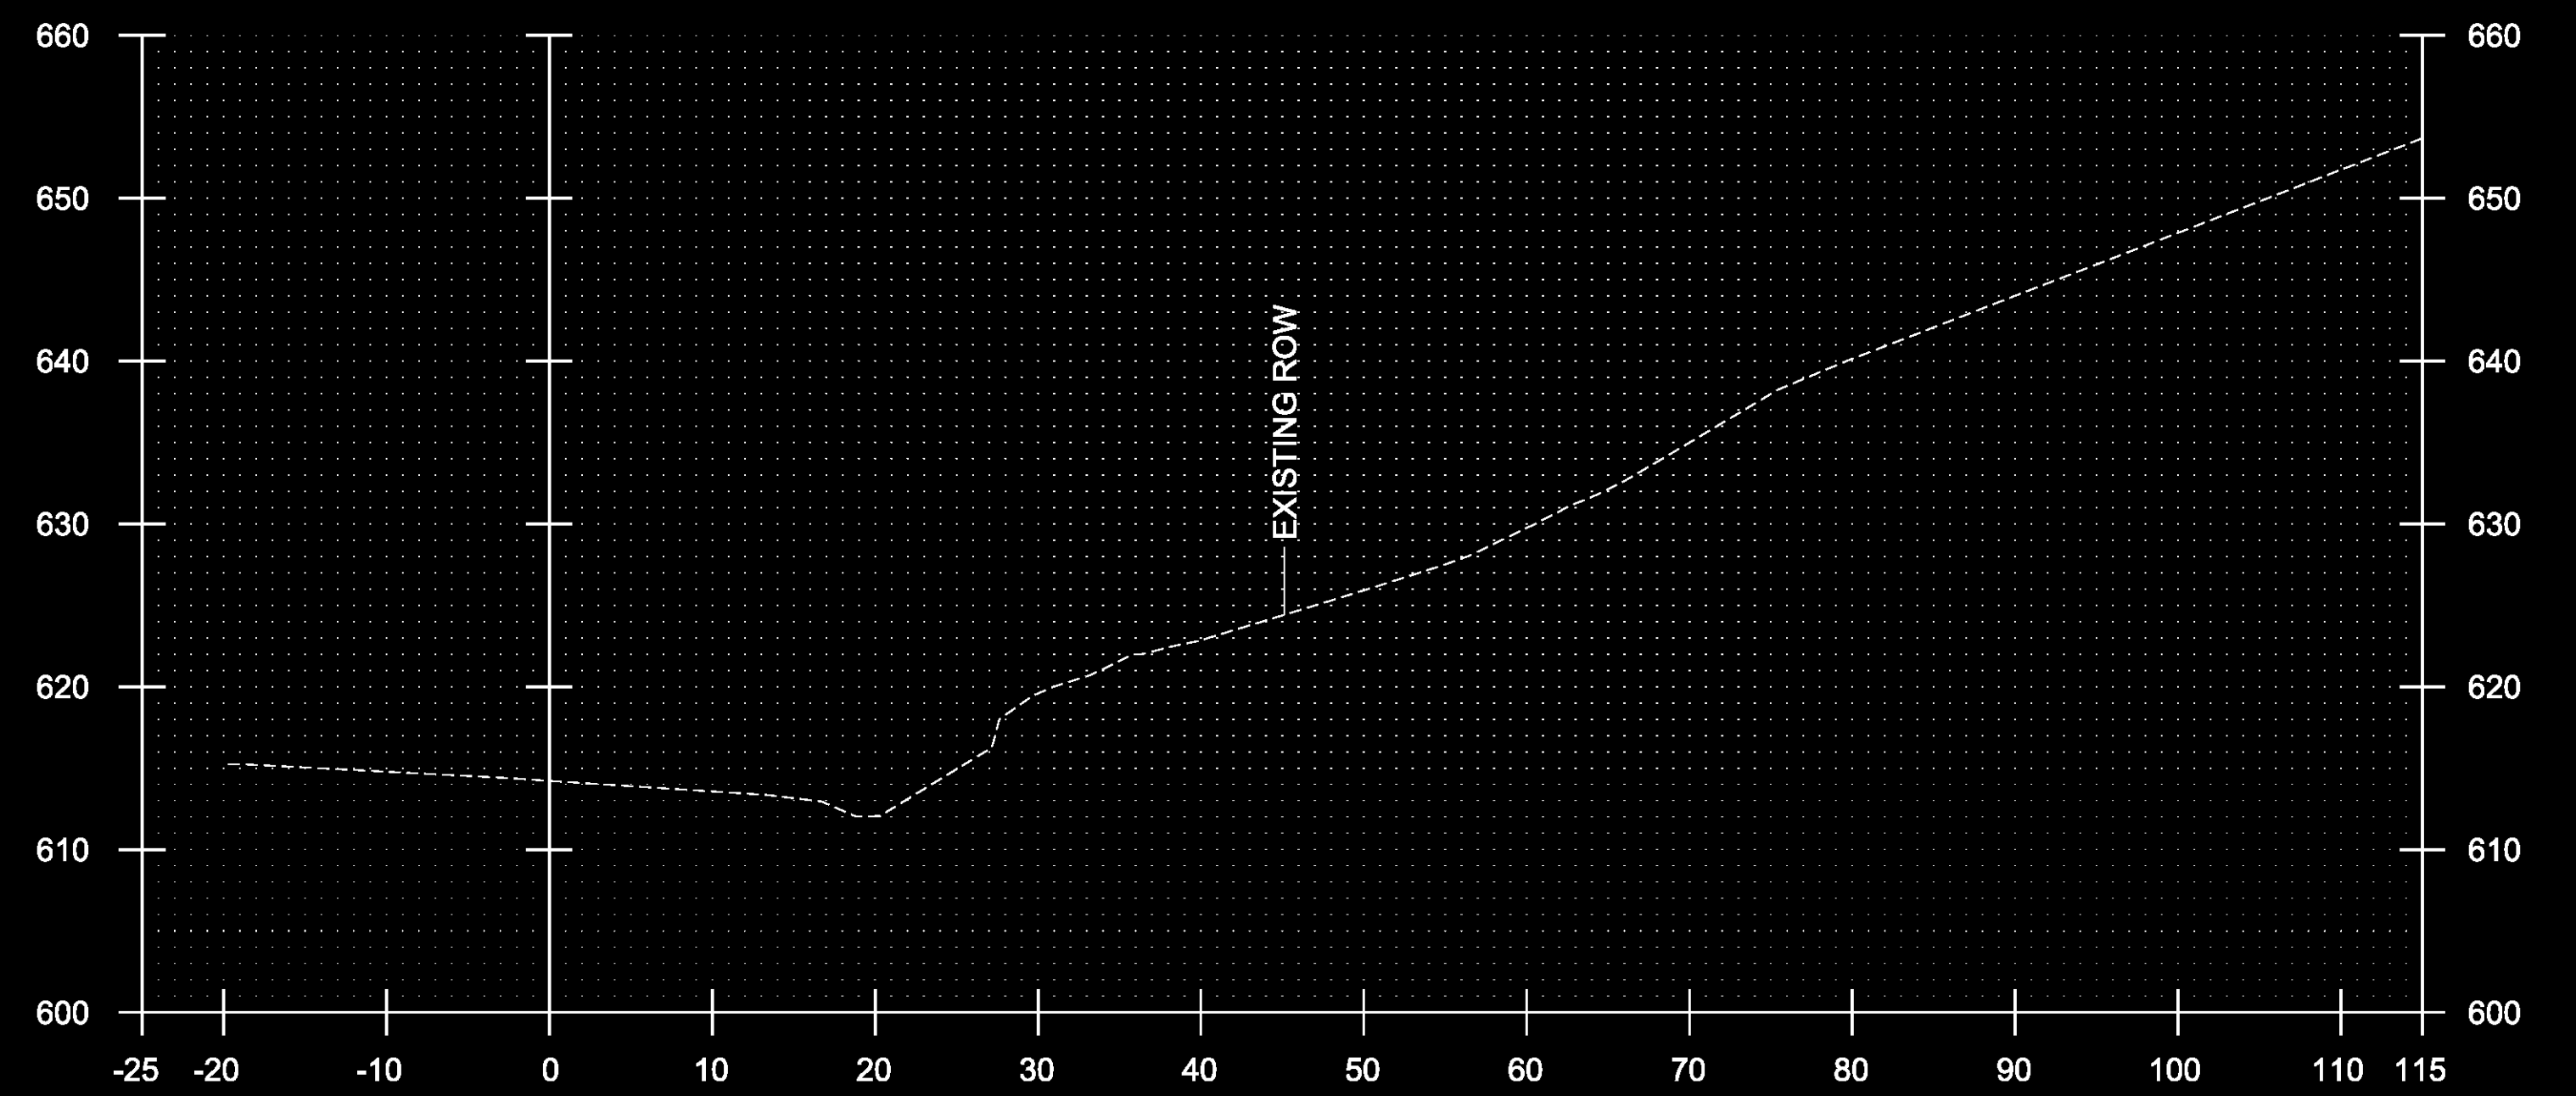

223+00

STA.222+00 TO STA.223+50

PROJECT NAME:	TOWNSHEND	FILE NAME:	dlib050xsc.dgn	PLOT DATE:	1/9/2015
PROJECT NUMBER:	STP 015-1(22)	PROJECT LEADER:	K. UPMAL	DRAWN BY:	B. KIPP
		DESIGNED BY:	C. LEACH	CHECKED BY:	A. KEMPTON
		CROSS SECTIONS	8	SHEET	26 OF 34