


TYPICAL SECTIONS


MONTPELIER STATE HIGHWAY TYPICAL SECTION

STA. 102+00 LT TO STA. 104+73 LT

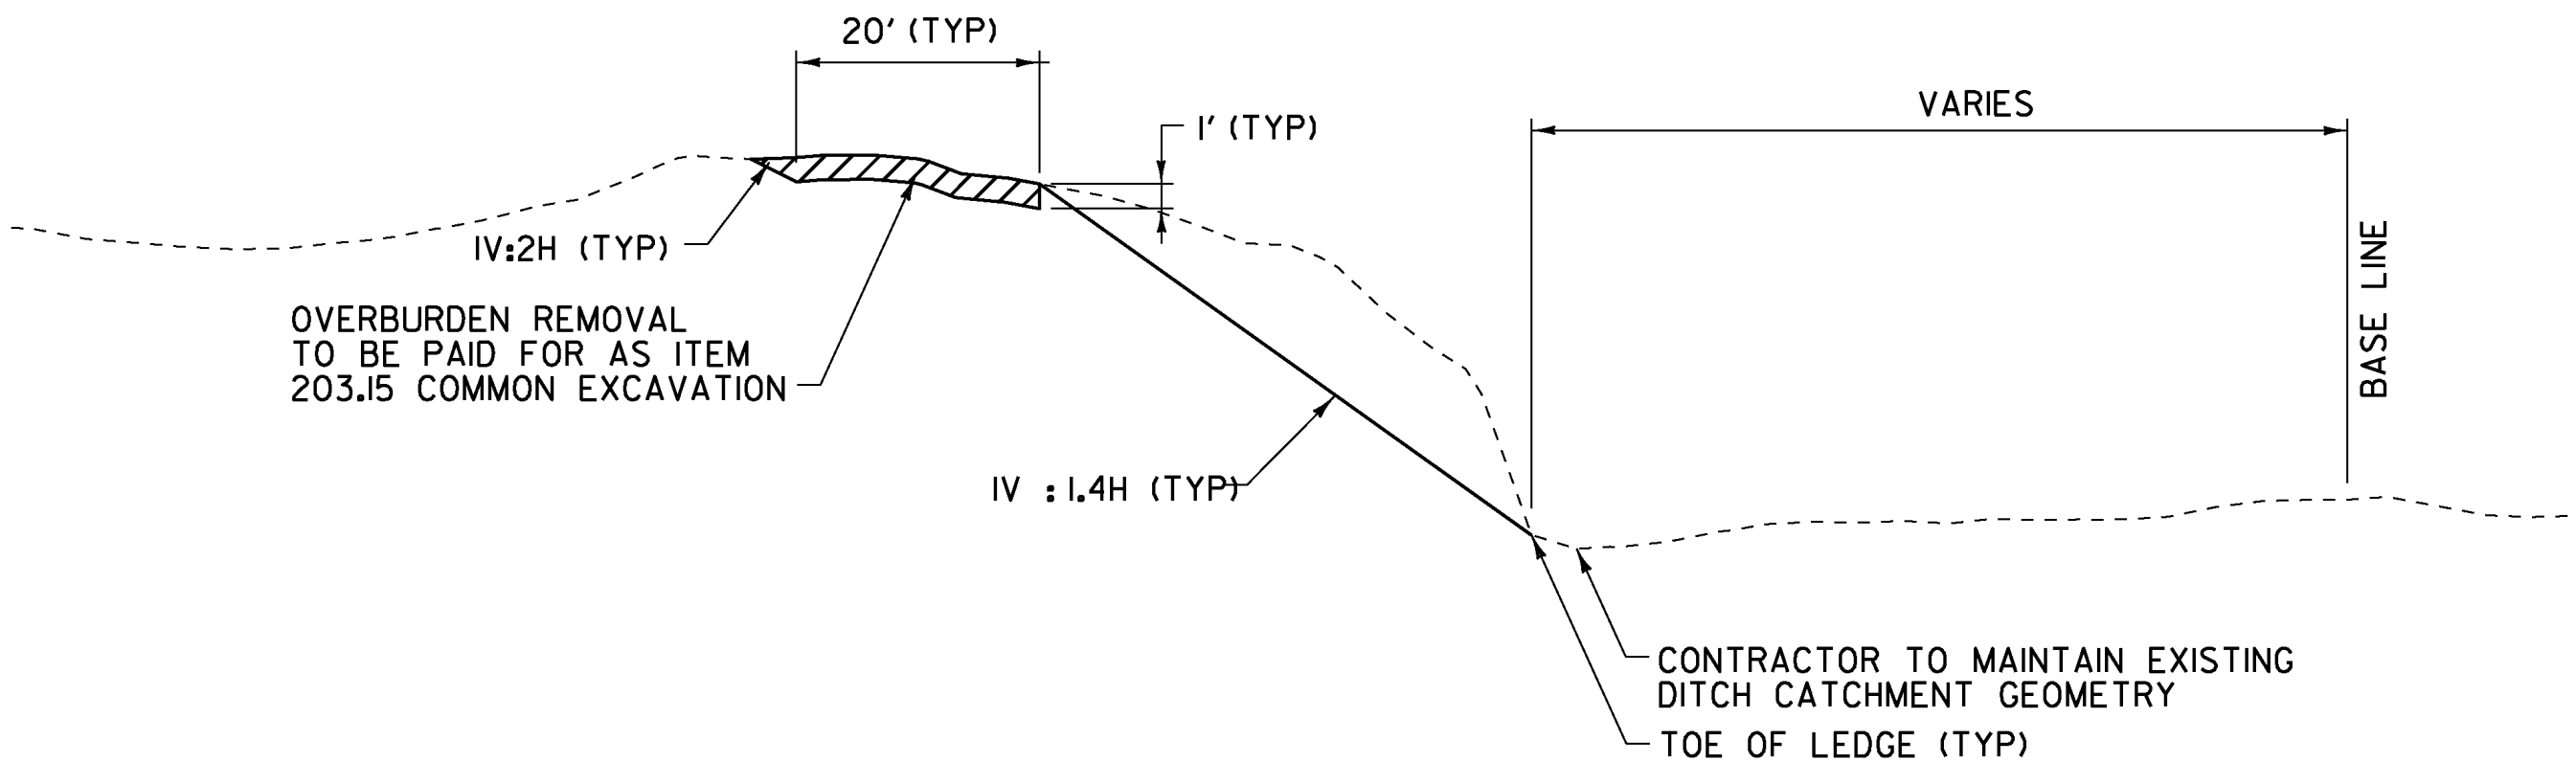

I-89 EXIT 8 RAMP A & B TYPICAL SECTION

RAMP B STA. 312+00 RT TO STA. 320+25 RT

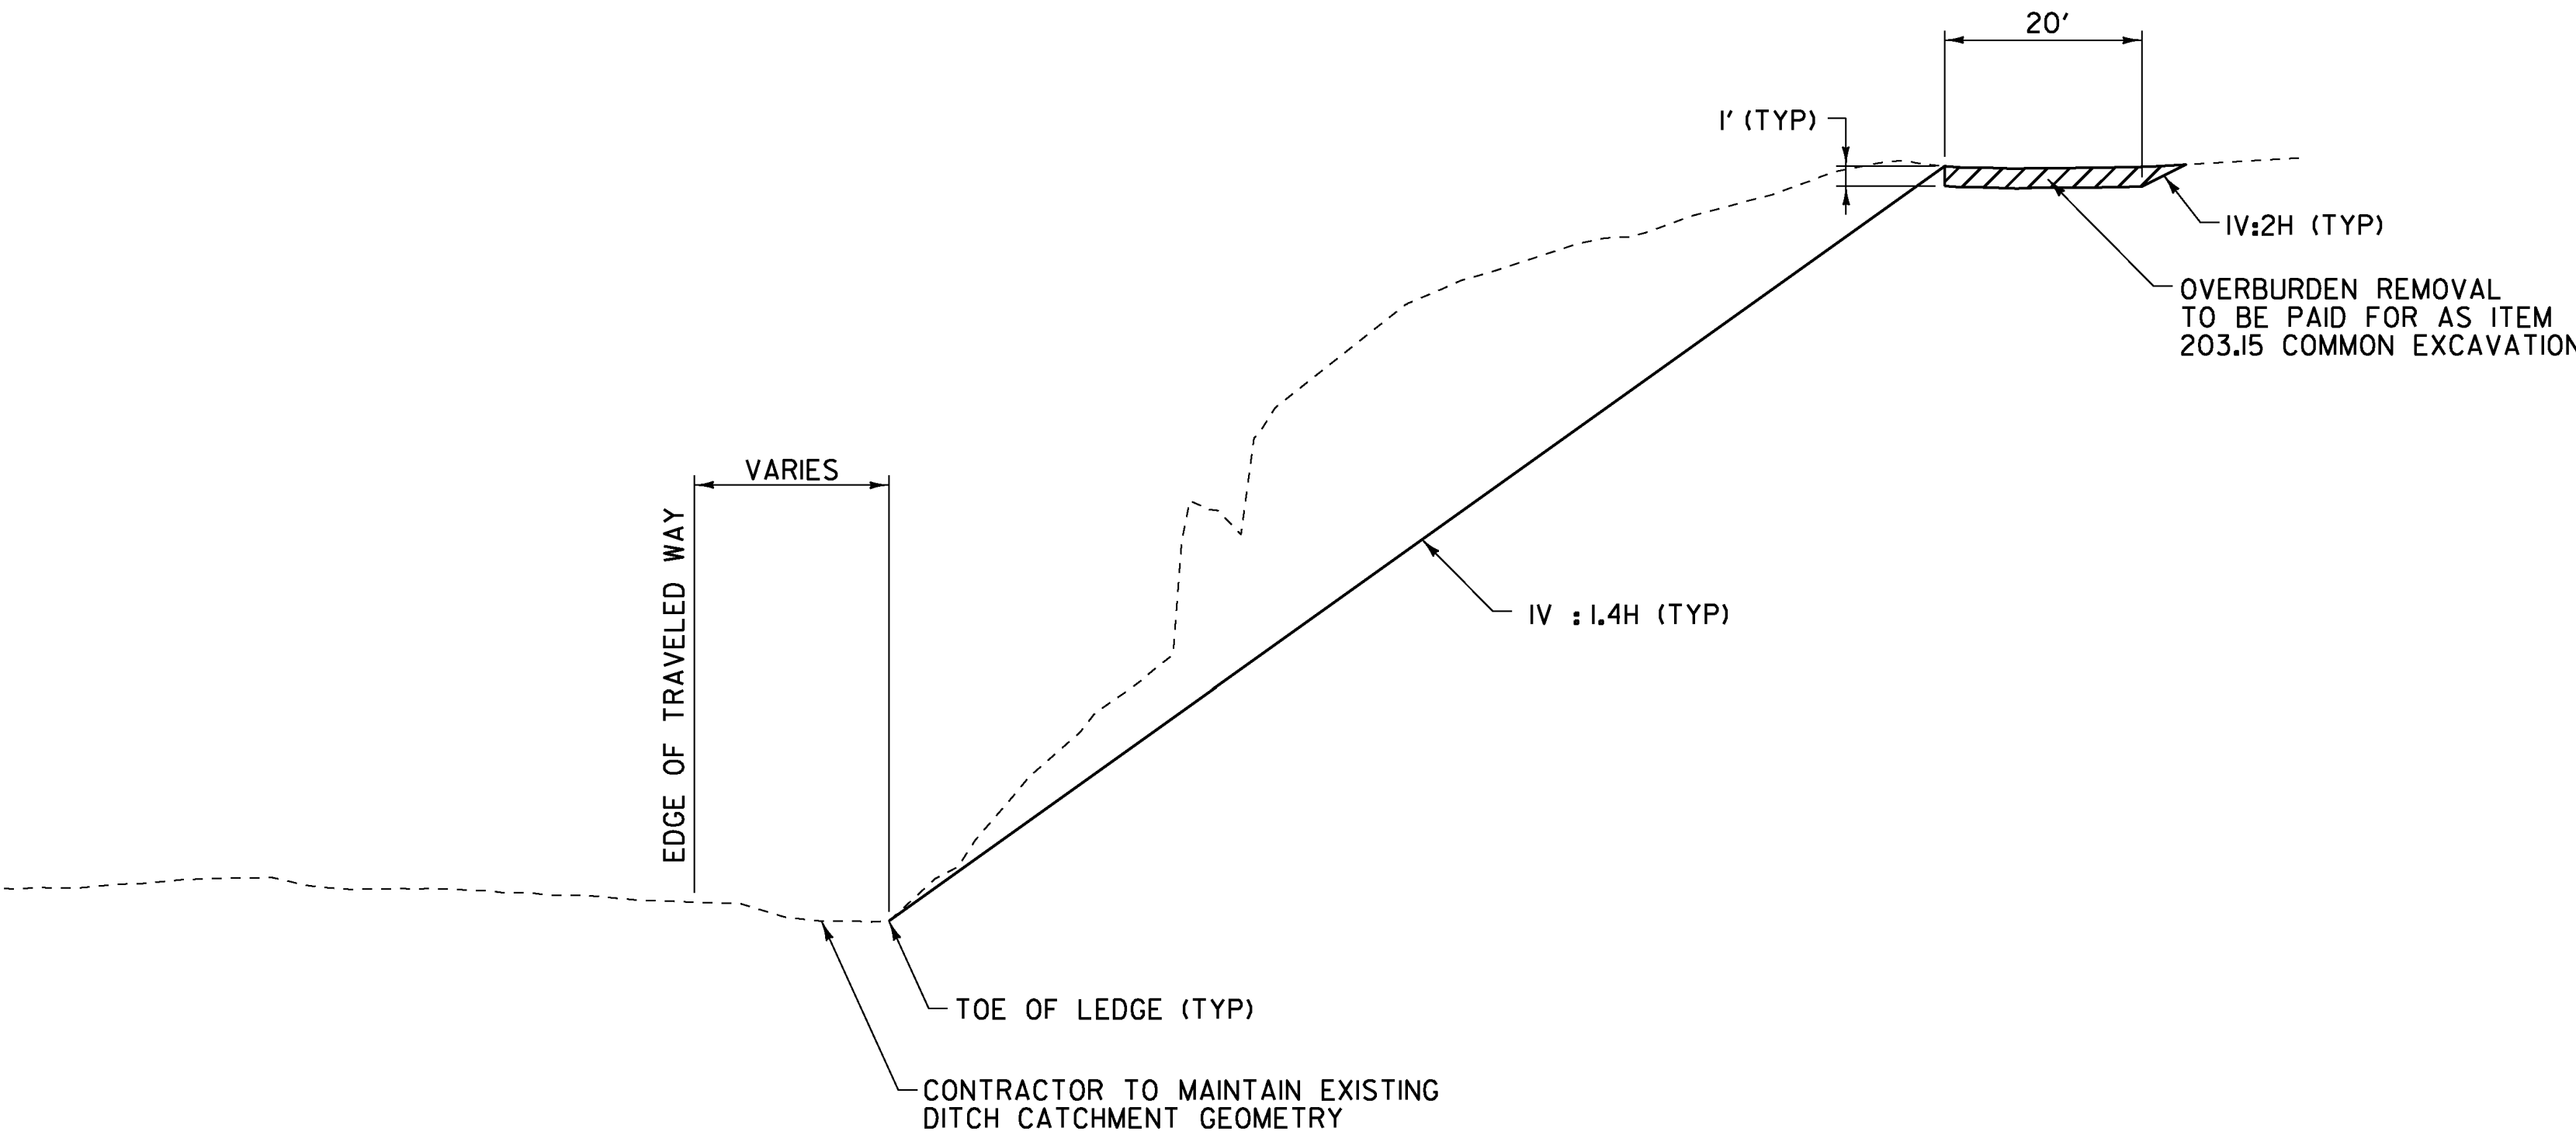

NOT TO SCALE

PROJECT NAME: MONTPELIER
PROJECT NUMBER: NH 028-2(9)

FILE NAME: I:\b066\Design\dlb066\frm.dgn
PROJECT LEADER: P. PELOQUIN
DESIGNED BY: P. PELOQUIN
TYPICAL SECTION SHEET

PLOT DATE: 24-MAY-2013
DRAWN BY: P. PELOQUIN
CHECKED BY: A. BOMBARDIER
SHEET 3 OF 62