



621.75 - REMOVE AND RESET GUARDRAIL  
MSH STA 101+79.40 LT TO MSH STA 105+00.00 LT

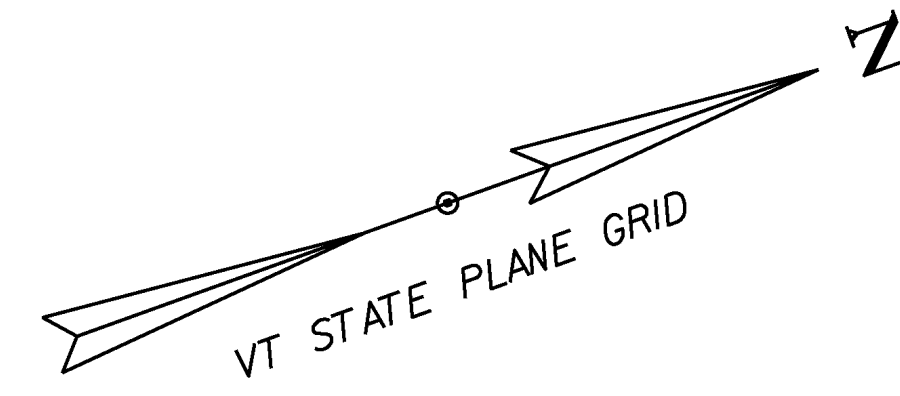


MSH MM 0.028 =  
STATION 101+50  
BEGIN PROJECT  
NH 028-2(9)

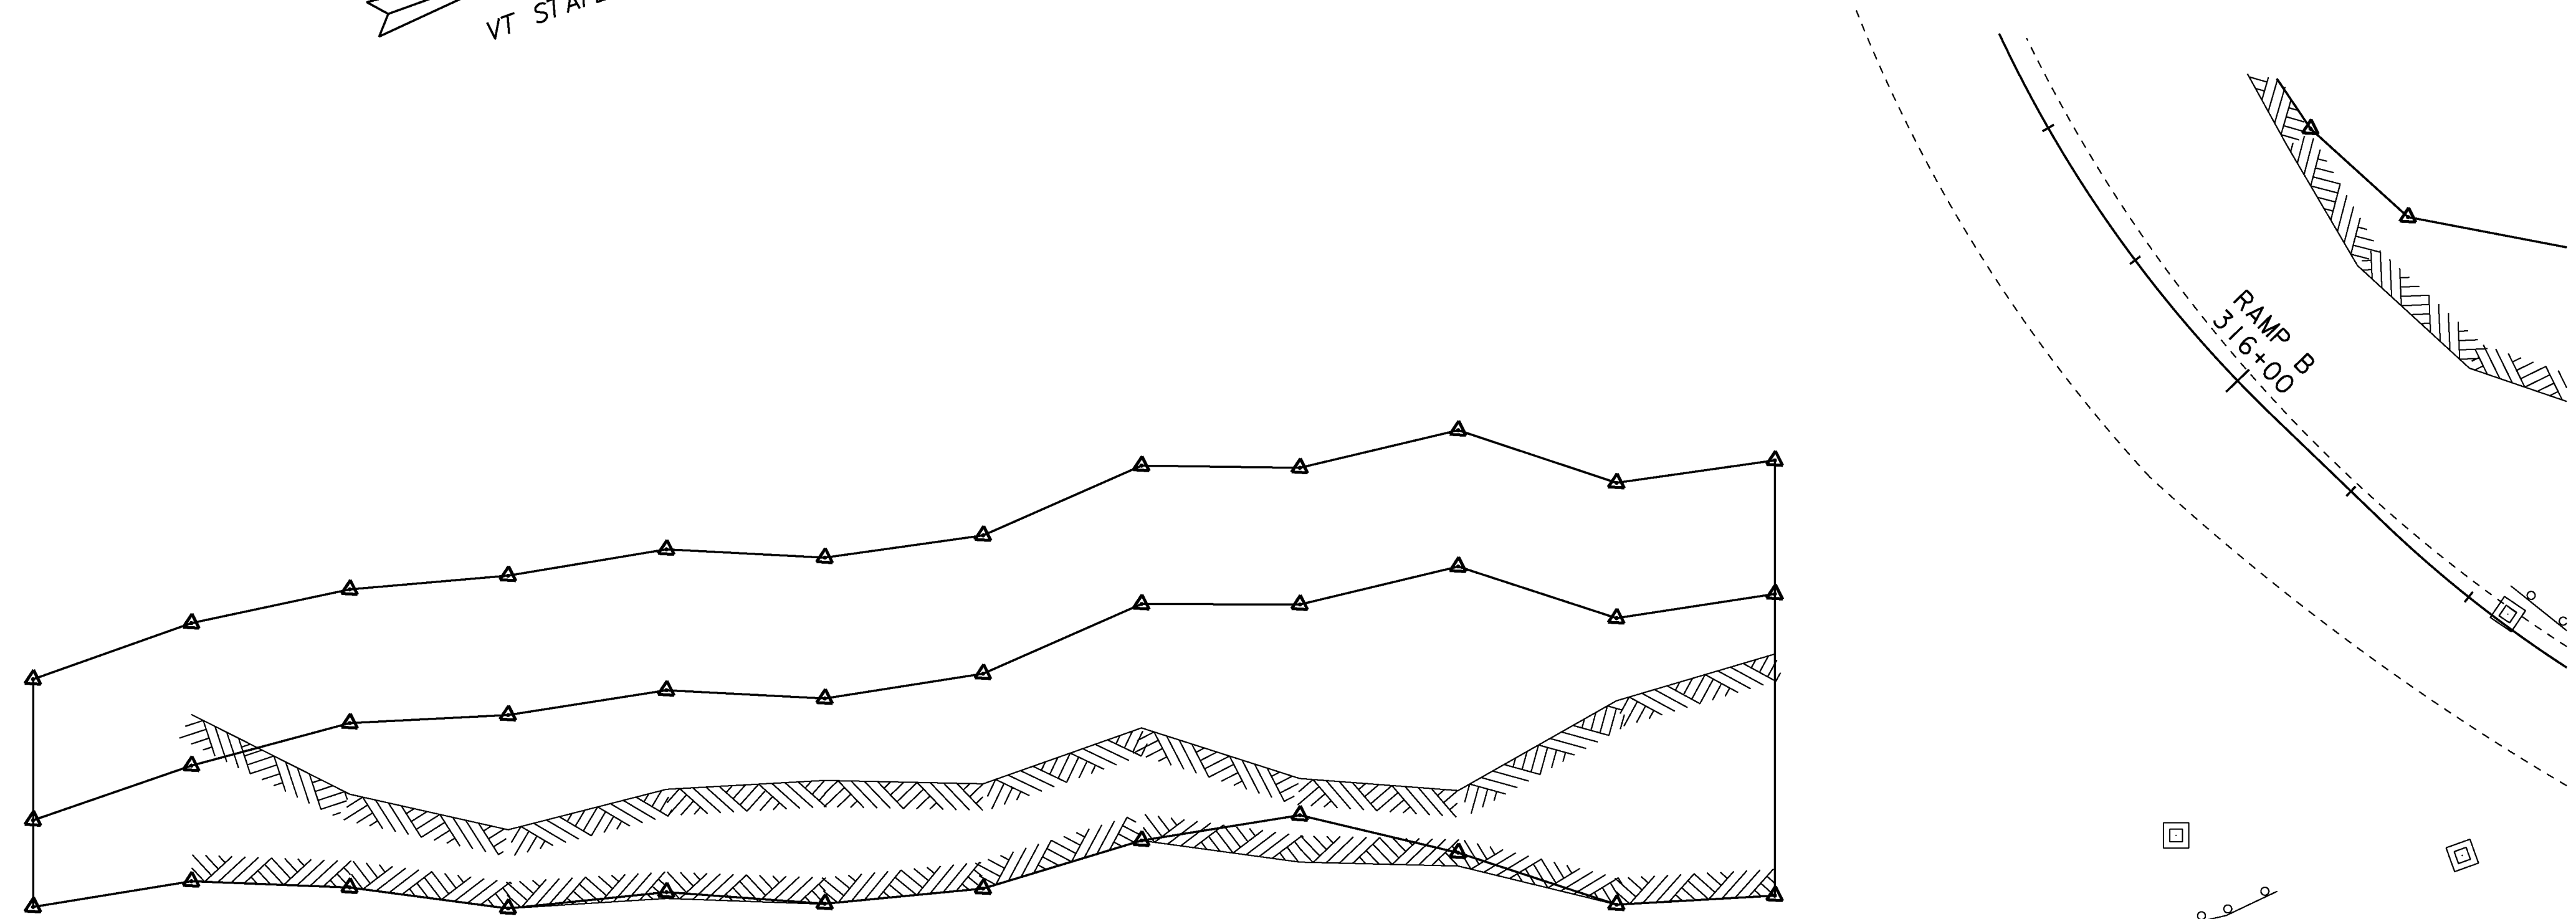

MSH 100+00                      MSH 101+00                      MSH 102+00                      MSH 103+00                      MSH 104+00                      MSH 105+00                      MSH 106+00

MSH  
STATION 105+00  
STOP PROJECT

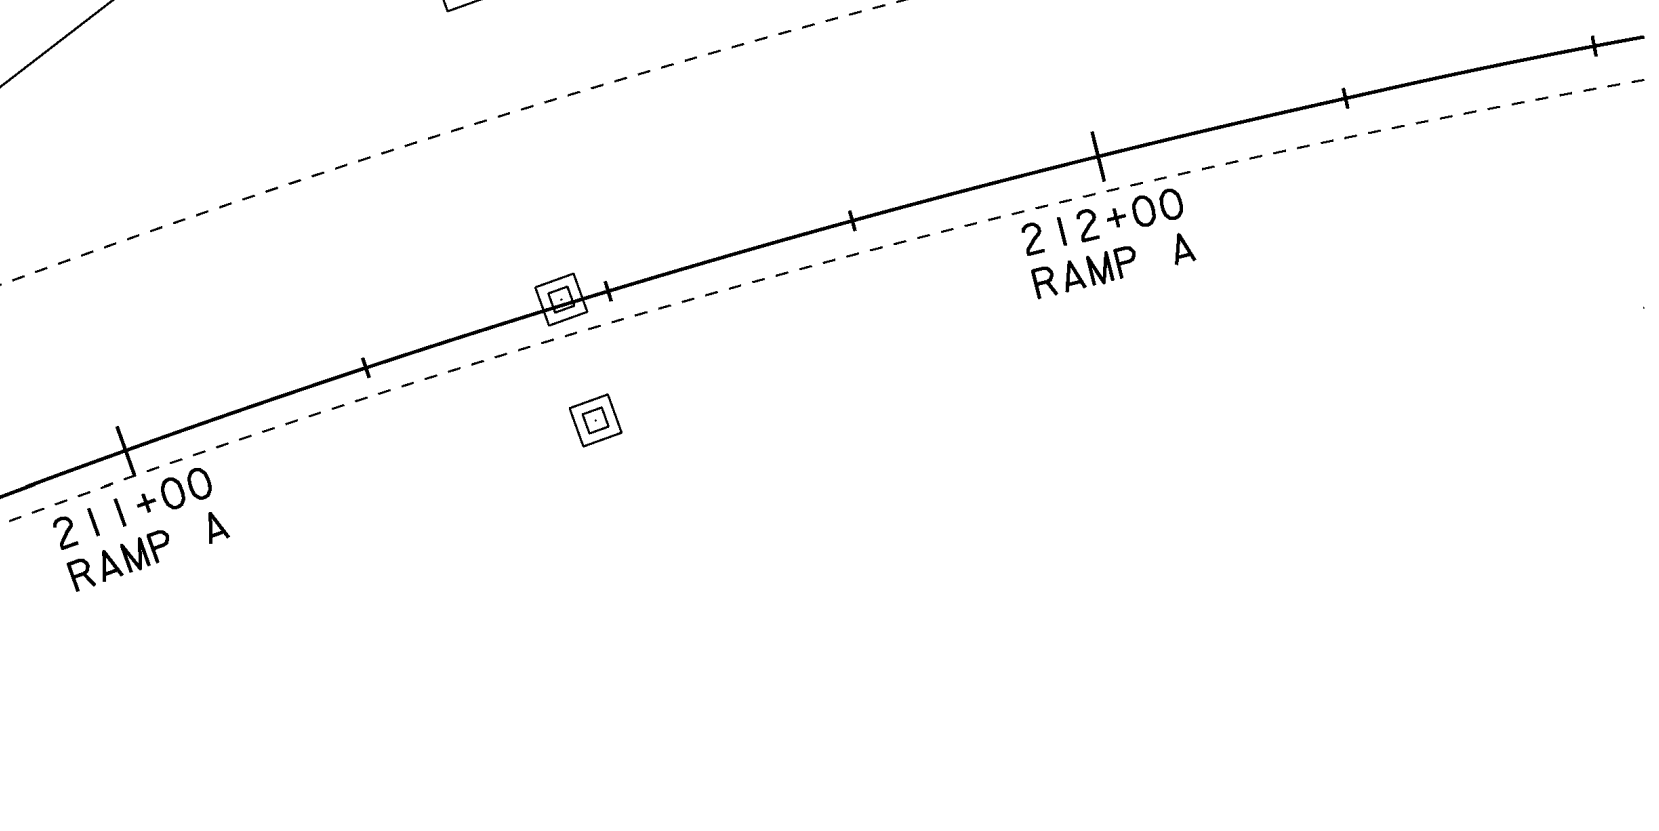

|                 |                                 |
|-----------------|---------------------------------|
| PROJECT NAME:   | MONTPELIER                      |
| PROJECT NUMBER: | NH 028-2(9)                     |
| FILE NAME:      | lib066\Design\dlb066bdr\msh.dgn |
| PLOT DATE:      | 24-MAY-2013                     |
| PROJECT LEADER: | P. PELOQUIN                     |
| DRAWN BY:       | P. PELOQUIN                     |
| DESIGNED BY:    | P. PELOQUIN                     |
| CHECKED BY:     | A. BOMBARDIER                   |
| LAYOUT SHEET I  | SHEET 7 OF 62                   |