


314+25

RAMP B

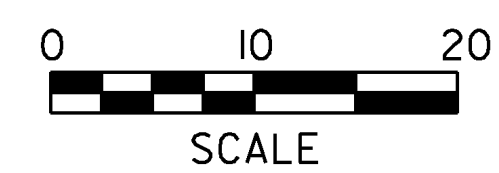

STA. 314+25

|  |                           |
|--|---------------------------|
| PROJECT NAME: MONTPELIER               | PLOT DATE: 24-MAY-2013    |
| PROJECT NUMBER: NH 028-2(9)            | DRAWN BY: P. PELOQUIN     |
| FILE NAME: I:\b066\Design\dlb066xs.dgn | CHECKED BY: A. BOMBARDIER |
| PROJECT LEADER: P. PELOQUIN            | SHEET 28 OF 62            |
| DESIGNED BY: P. PELOQUIN               |                           |
| CROSS SECTION SHEET 10                 |                           |