


315+25

RAMP B

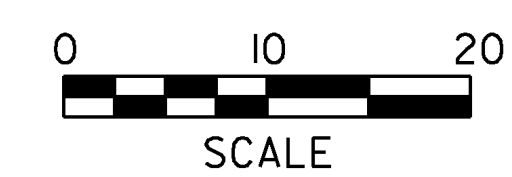

STA. 315+25

PROJECT NAME: MONTPELIER	PLOT DATE: 24-MAY-2013
PROJECT NUMBER: NH 028-2(9)	DRAWN BY: P. PELOQUIN
FILE NAME: I:\b066\Design\d11b066xs.dgn	CHECKED BY: A. BOMBARDIER
DESIGNED BY: P. PELOQUIN	SHEET 32 OF 62
CROSS SECTION SHEET 14	