
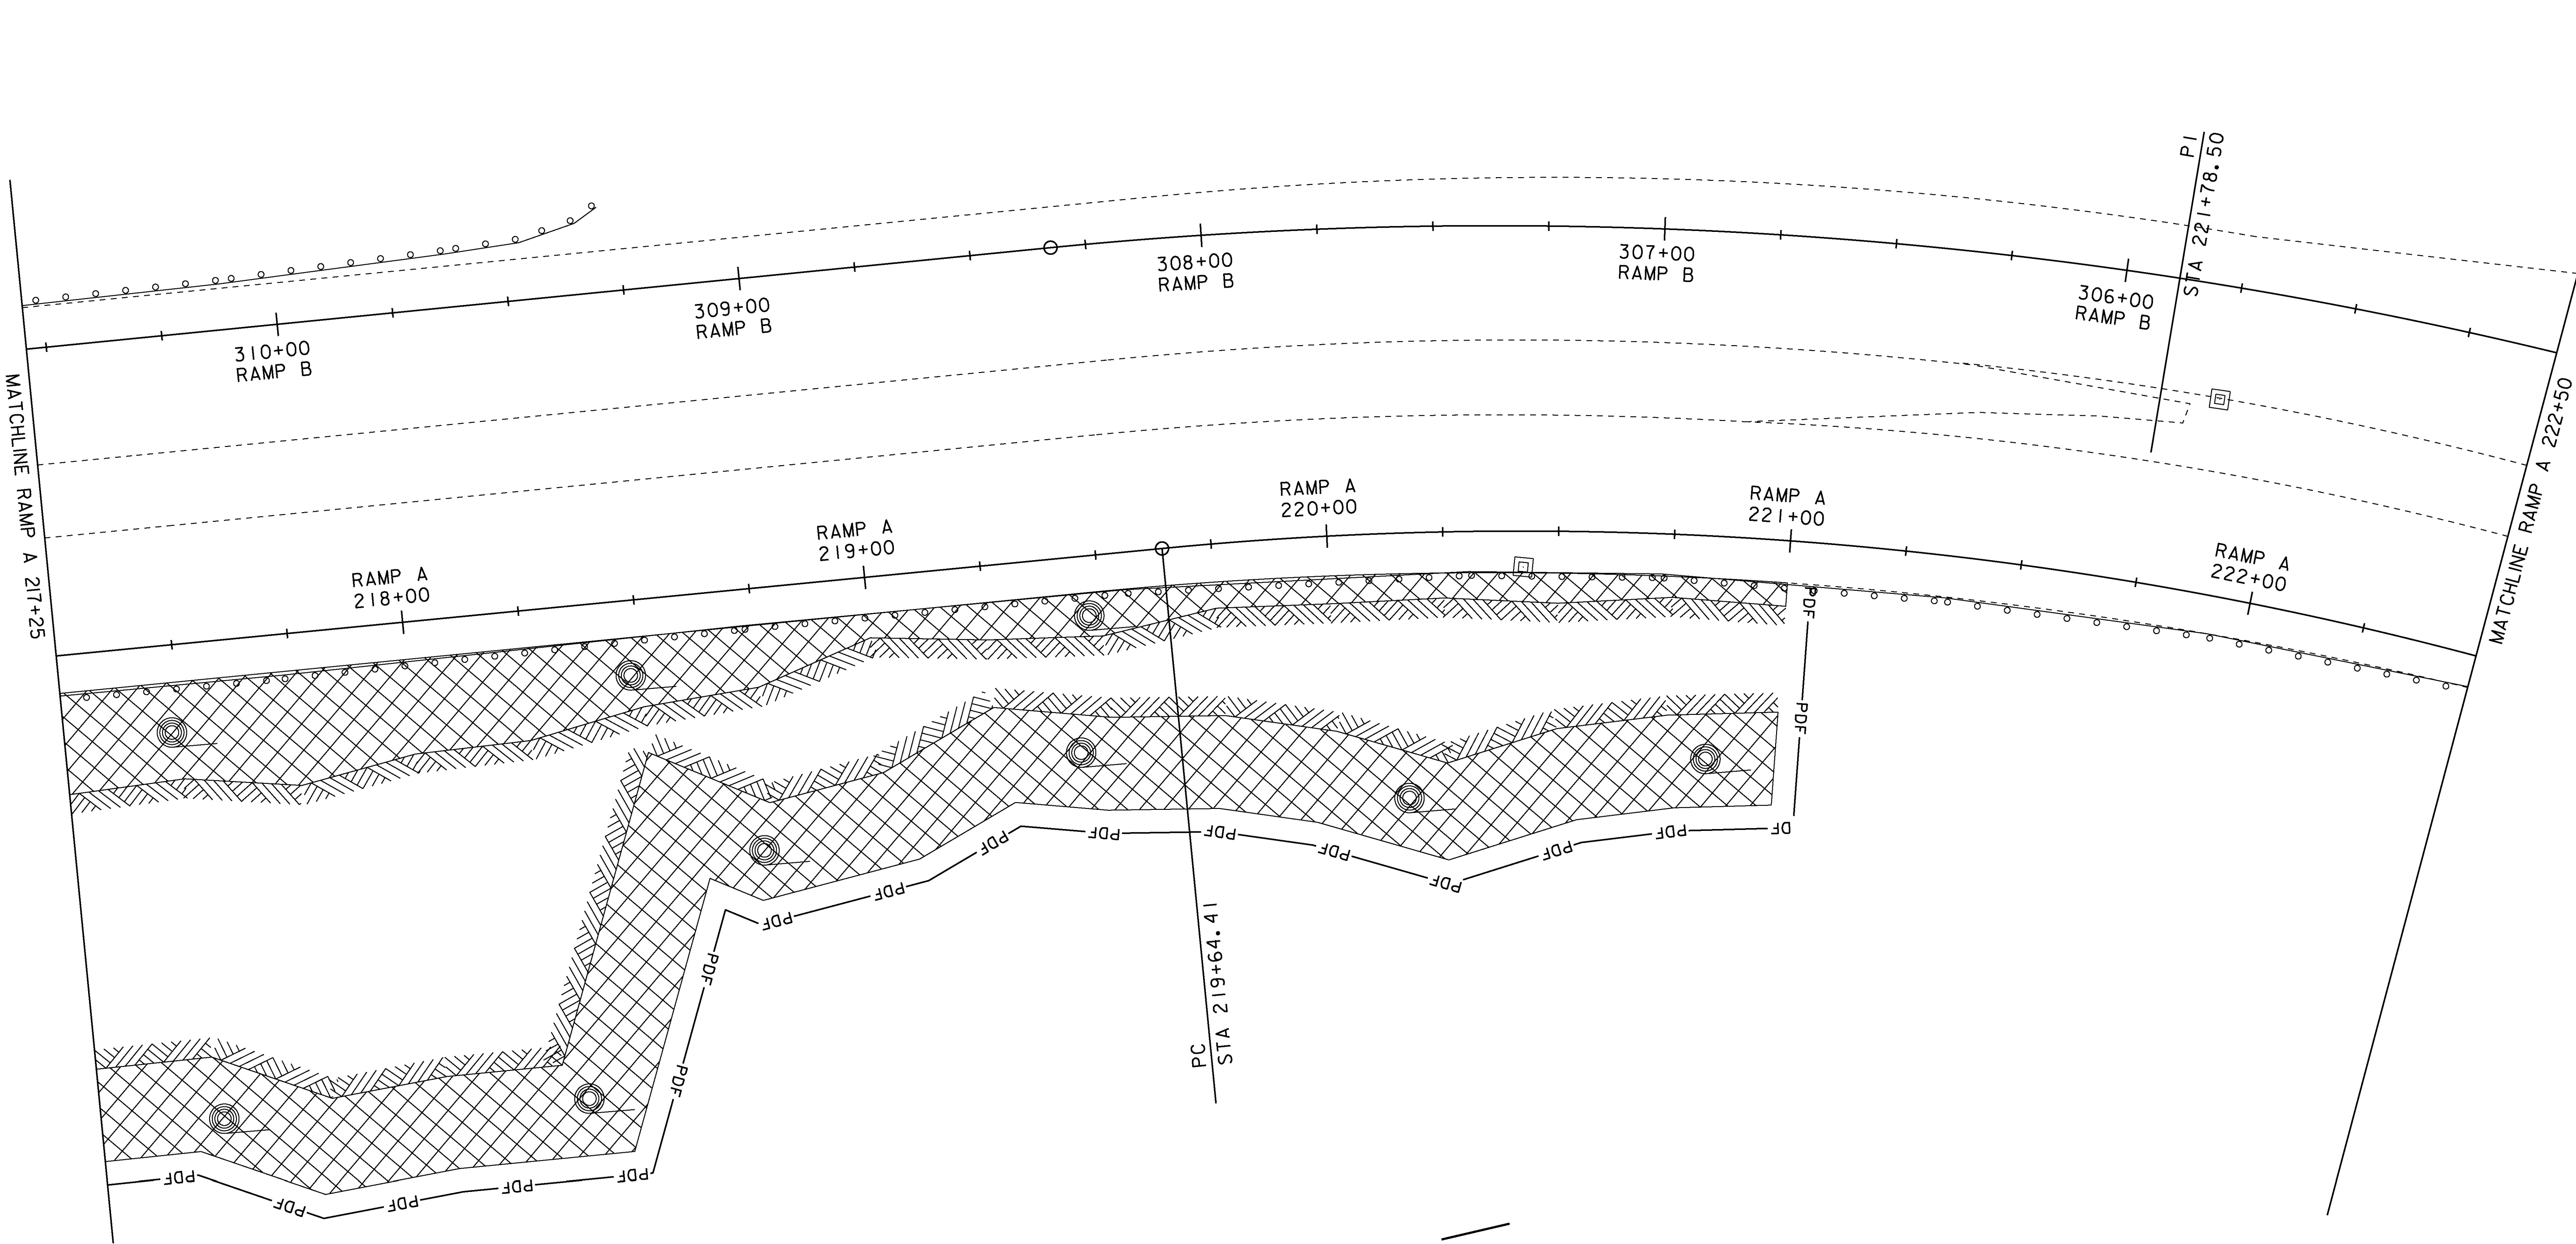


653.20 - TEMPORARY EROSION MATTING
RAMP A STA 217+25 RT TO RAMP A STA 220+00 RT




653.55 - PROJECT DEMARCATION FENCE
RAMP A STA 217+25 RT TO RAMP A STA 220+05 RT

AREA OF DISTURBANCE
CREST OF LEDGE: 8,398 SF = 0.193 ACRES
DITCH: 4,475 SF = 0.103 ACRES
ACCESS: 0 SF = 0 ACRES
SHEET TOTAL: 12,873 SF = 0.296 ACRES
PROJECT TOTAL: 86,811 SF = 1.993 ACRES


AREA OF SOLID ROCK EXCAVATION
SHEET TOTAL: 0 SF = 0 ACRES
PROJECT TOTAL: 27,864 SF = 0.639 ACRES

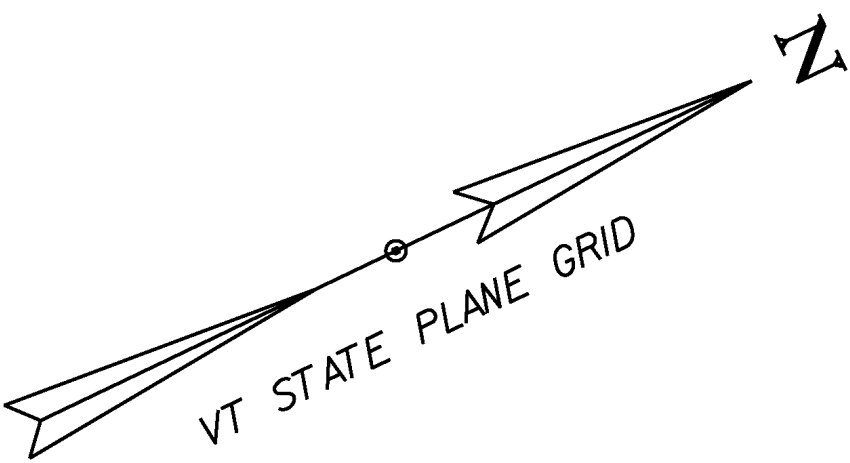

LEGEND

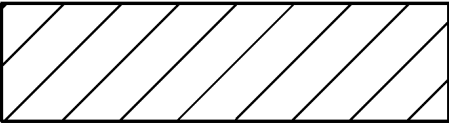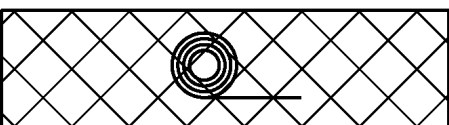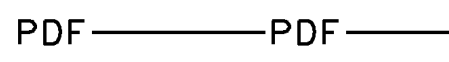-  SOLID ROCK EXCAVATION
-  EROSION MATTING/LIMITS OF DISTURBANCE
-  PROJECT DEMARCATION FENCE
-  DROP INLET PROTECTION

RAMP A LAYOUT SHEET 3

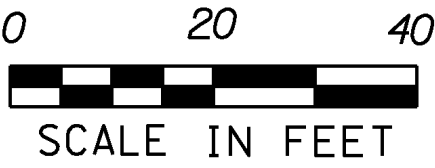

PROJECT NAME: MONTPELIER
PROJECT NUMBER: NH 028-2(9)

FILE NAME: d:\b066\Design\dlib066bdr\env.dgn PLOT DATE: 24-MAY-2013
PROJECT LEADER: P. PELOQUIN DRAWN BY: P. PELOQUIN
DESIGNED BY: P. PELOQUIN CHECKED BY: A. BOMBARDIER
EPSC LAYOUT SHEET 4 SHEET 47 OF 62