


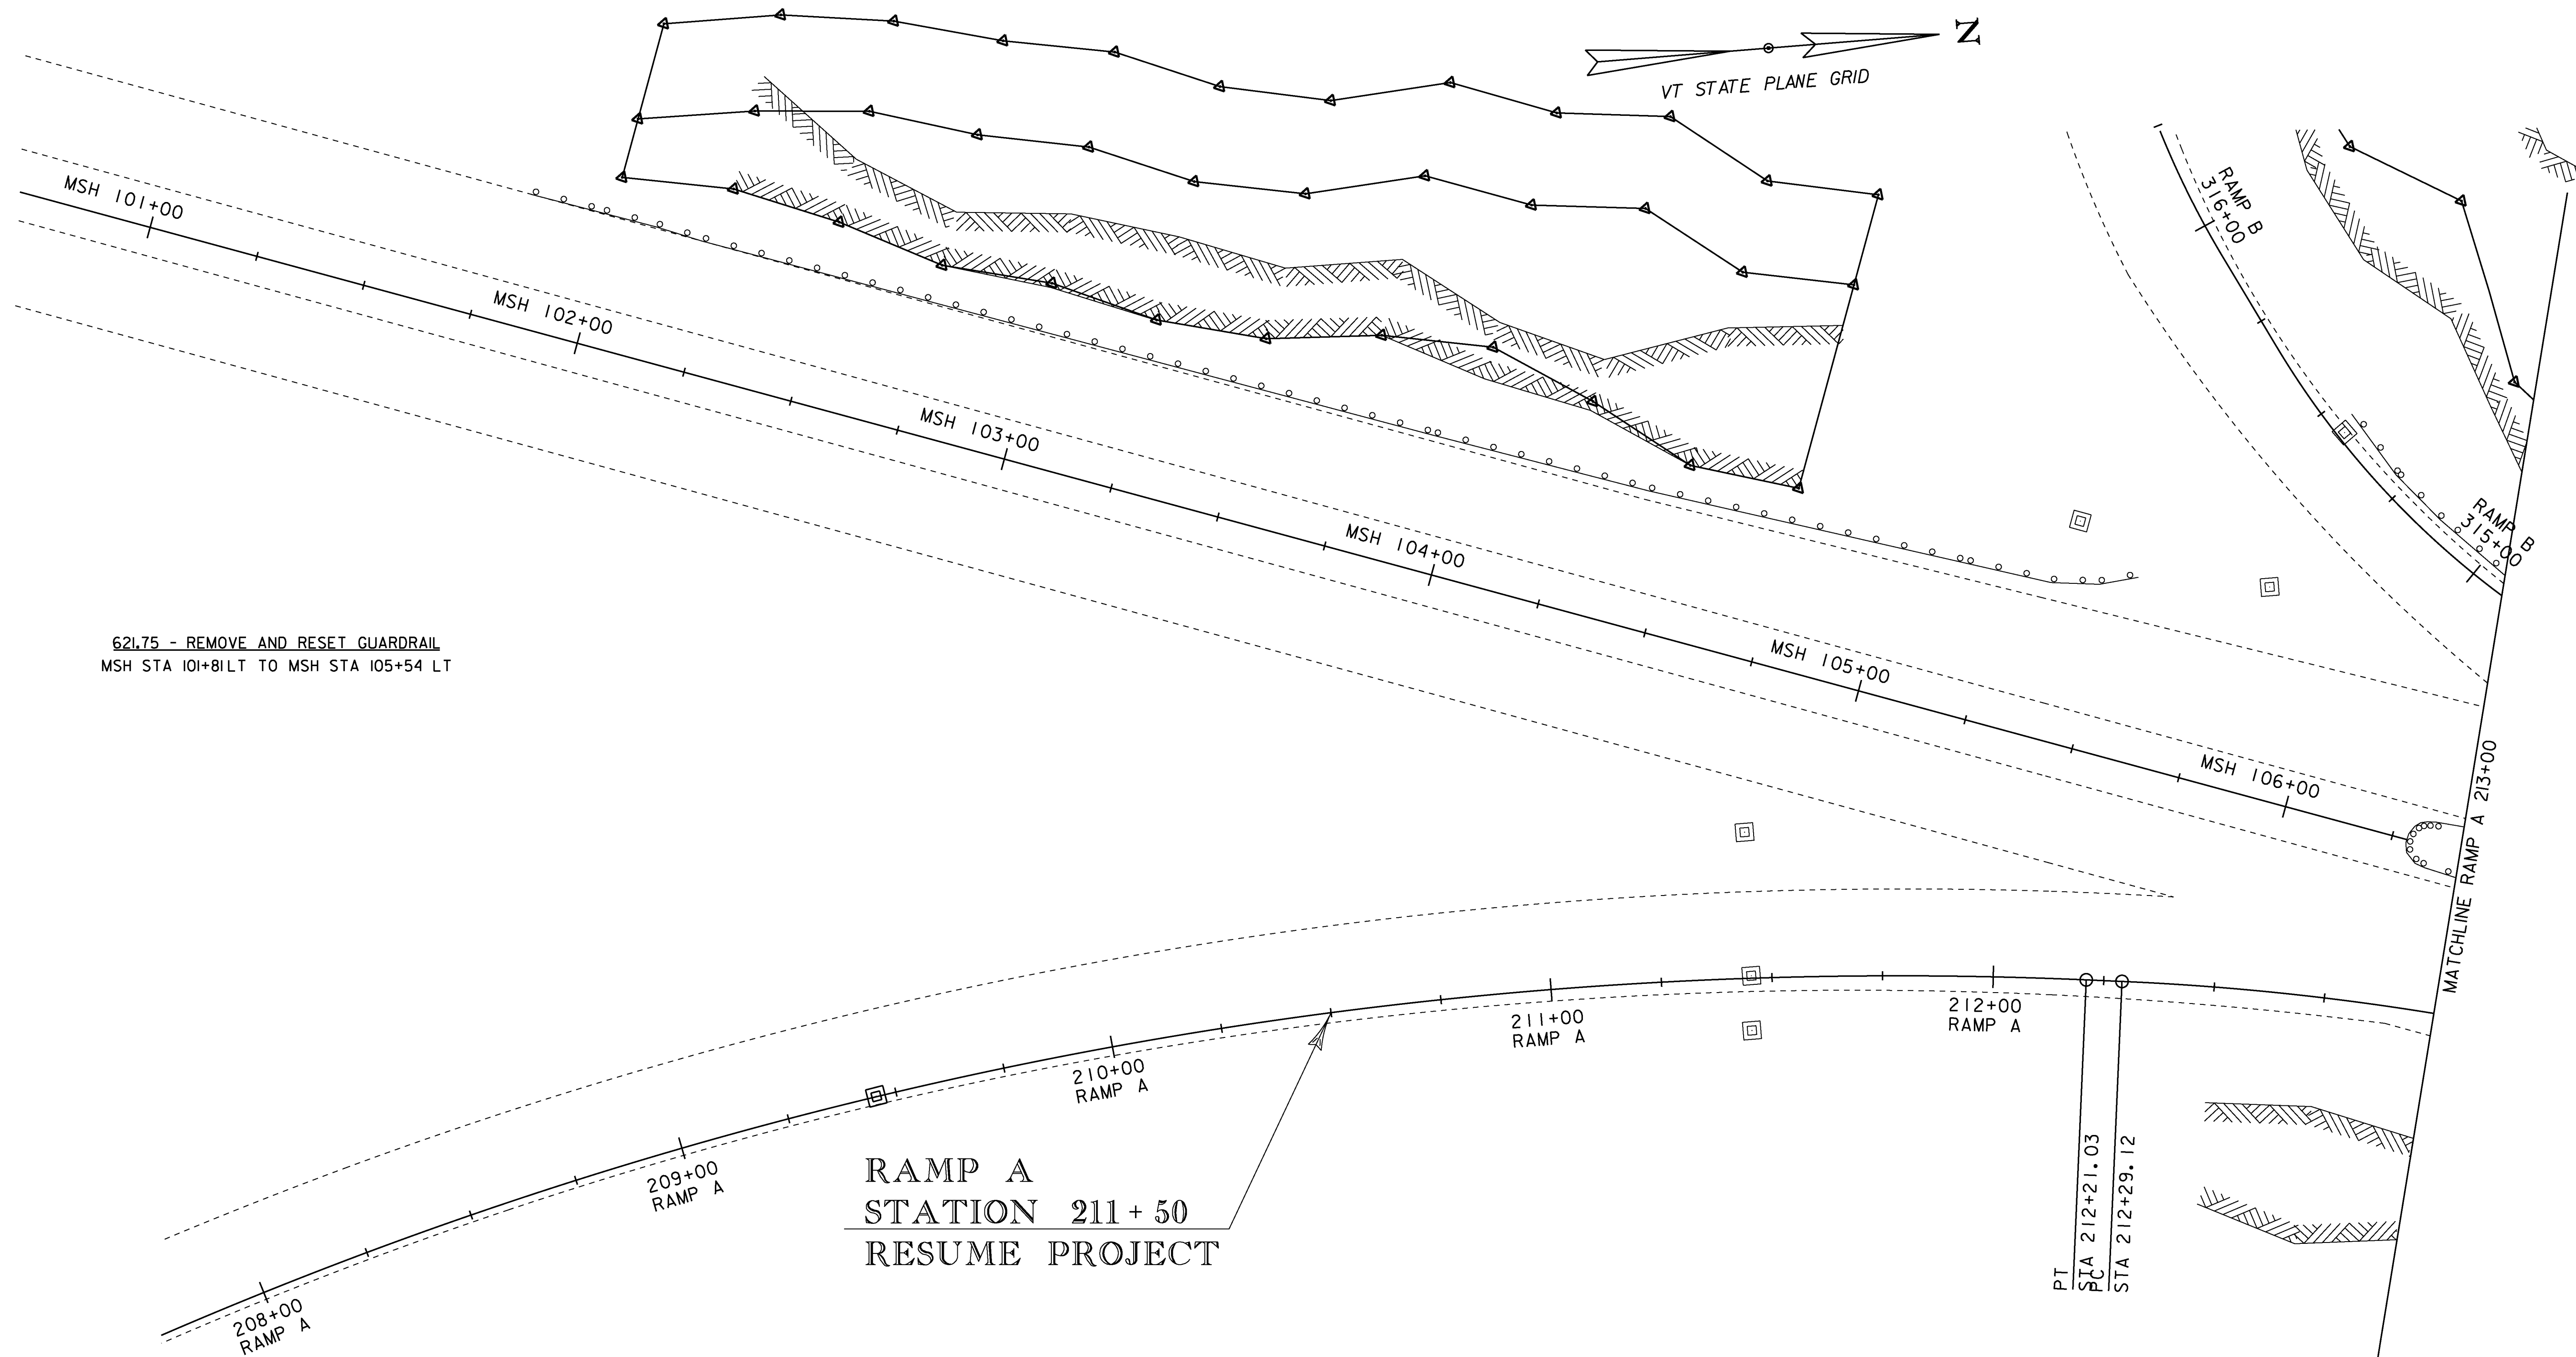

621.75 - REMOVE AND RESET GUARDRAIL
MSH STA 101+81 LT TO MSH STA 105+54 LT

RAMP A
STATION 211 + 50
RESUME PROJECT



PROJECT NAME: MONTPELIER	
PROJECT NUMBER: NH 028-2(9)	
FILE NAME: d:\b066\Design\d\l\b066b\dra.dgn	PLOT DATE: 24-MAY-2013
PROJECT LEADER: P. PELOQUIN	DRAWN BY: P. PELOQUIN
DESIGNED BY: P. PELOQUIN	CHECKED BY: A. BOMBARDIER
LAYOUT SHEET 2	SHEET 8 OF 62