



621.75 - REMOVE AND RESET GUARDRAIL  
 RAMP A STA 213+05 RT TO RAMP A STA 217+25 RT

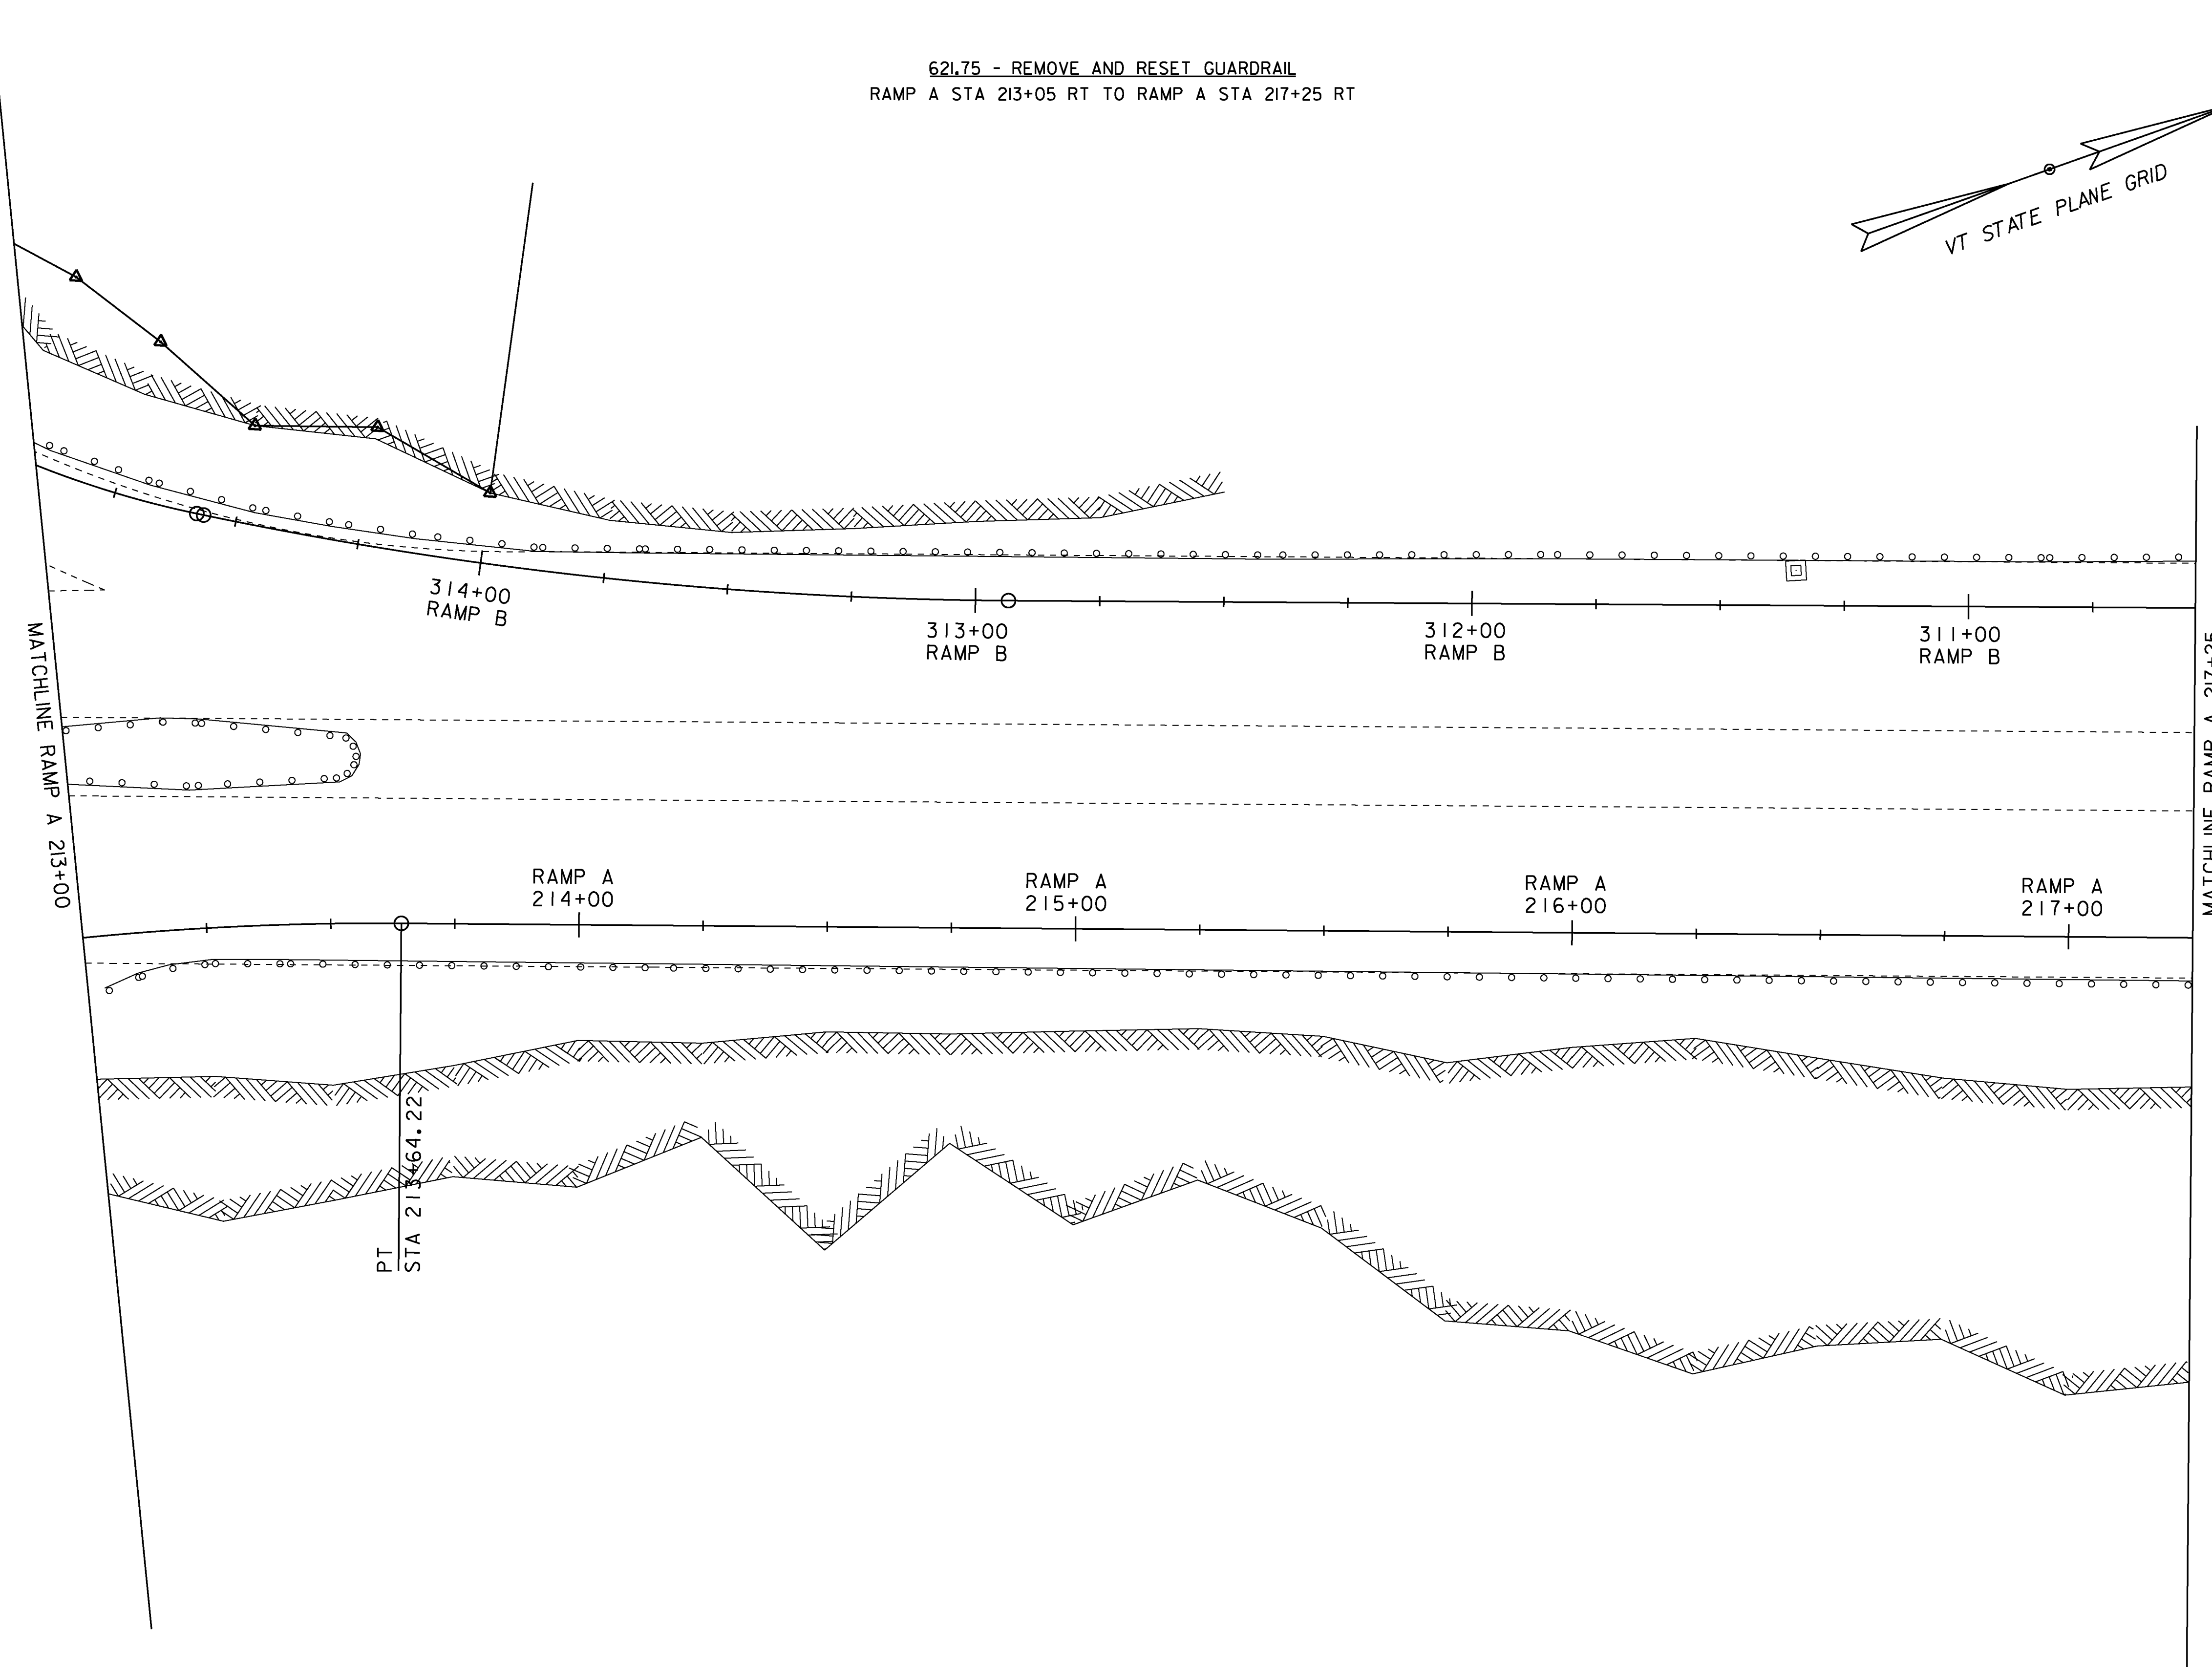

PLEASE SEE LAYOUT SHEET 6 FOR DETAILS ON RAMP B.

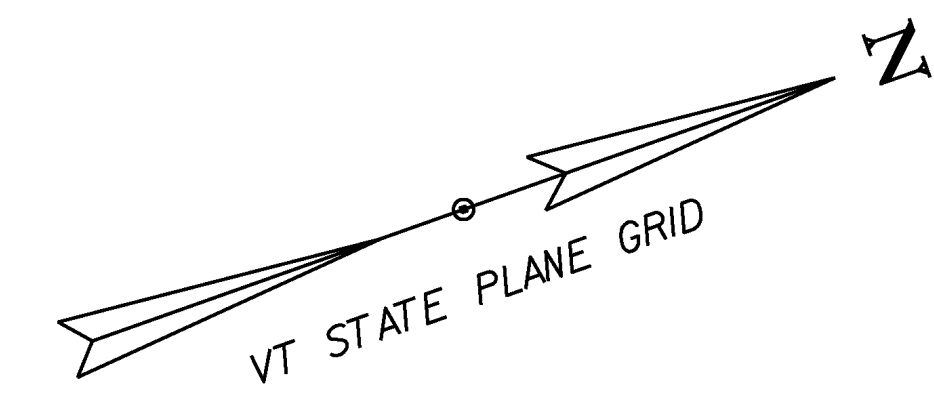

PROJECT NAME: MONTPELIER  
 PROJECT NUMBER: NH 028-2(9)

FILE NAME: d:\b066\Design\d\lib066bdra.dgn PLOT DATE: 24-MAY-2013  
 PROJECT LEADER: P. PELOQUIN DRAWN BY: P. PELOQUIN  
 DESIGNED BY: P. PELOQUIN CHECKED BY: A. BOMBARDIER  
 LAYOUT SHEET 3 SHEET 9 OF 62