



101+75

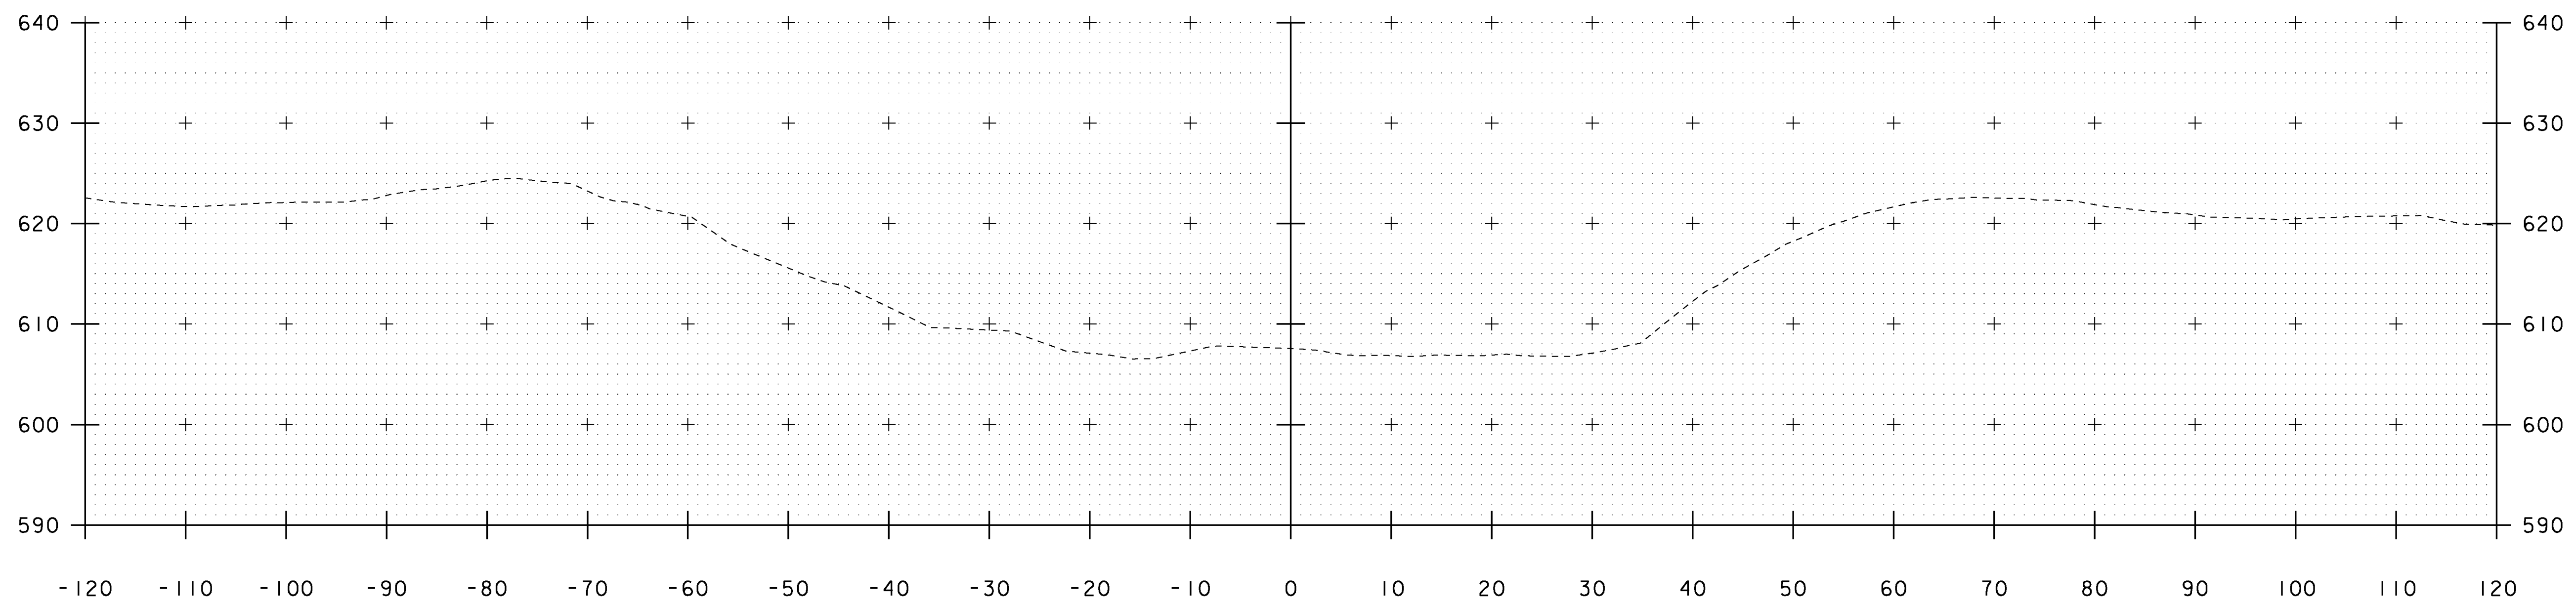

101+50
BEGIN PROJECT

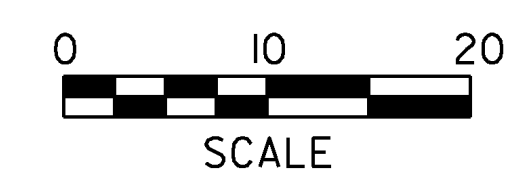

STA. 101+50 TO STA. 101+75

MONTPELIER STATE HIGHWAY

PROJECT NAME: MONTPELIER	PLOT DATE: 24-MAY-2013
PROJECT NUMBER: NH 028-2(9)	DRAWN BY: P. PELOQUIN
FILE NAME: I:\b066\Design\d11b066xs.dgn	CHECKED BY: A. BOMBARDIER
PROJECT LEADER: P. PELOQUIN	SHEET 19 OF 62
DESIGNED BY: P. PELOQUIN	CROSS SECTION SHEET 1