



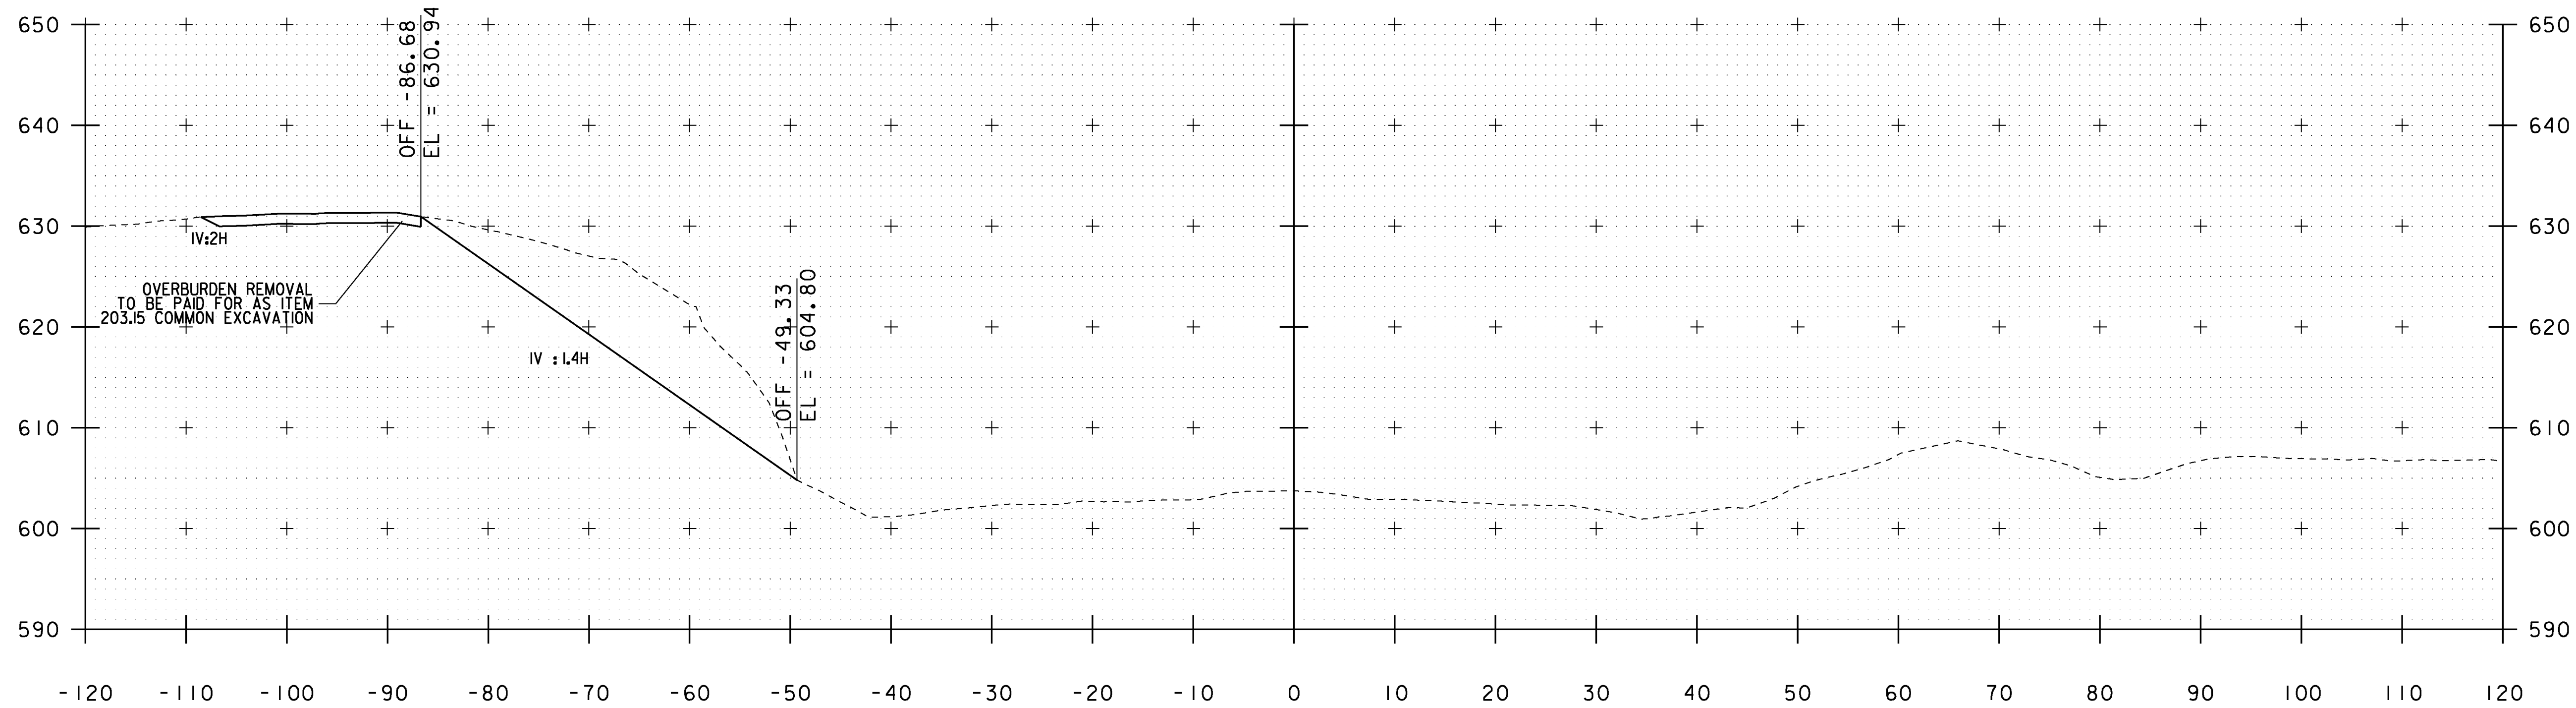


103+75

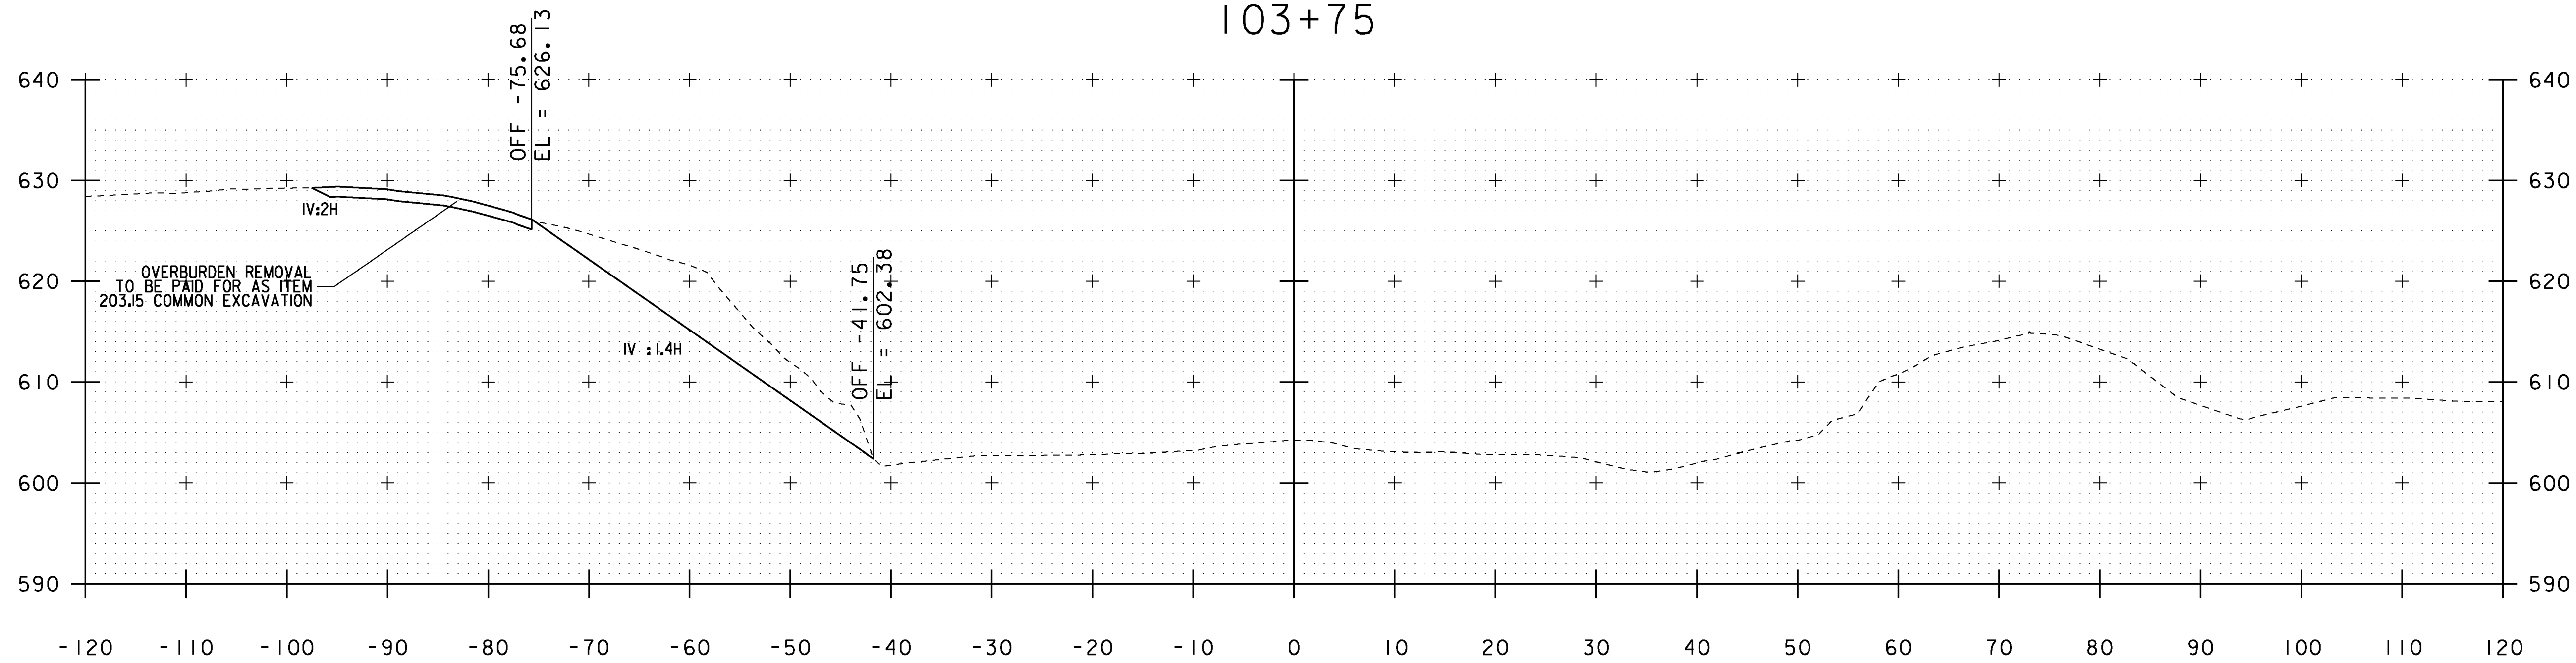

103+50

MONTPELIER STATE HIGHWAY

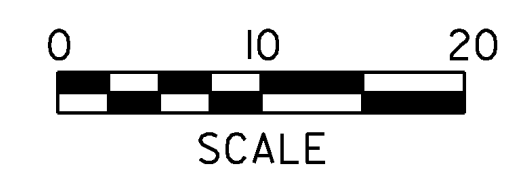

STA. 103+50 TO STA. 103+75

PROJECT NAME:	MONTPELIER	PLOT DATE:	24-MAY-2013
PROJECT NUMBER:	NH 028-2(9)	DRAWN BY:	P. PELOQUIN
FILE NAME:	lib066\Design\dlb066xs.dgn	CHECKED BY:	A. BOMBARDIER
PROJECT LEADER:	P. PELOQUIN	SHEET	23 OF 62
DESIGNED BY:	P. PELOQUIN		
CROSS SECTION SHEET	5		