



105+25

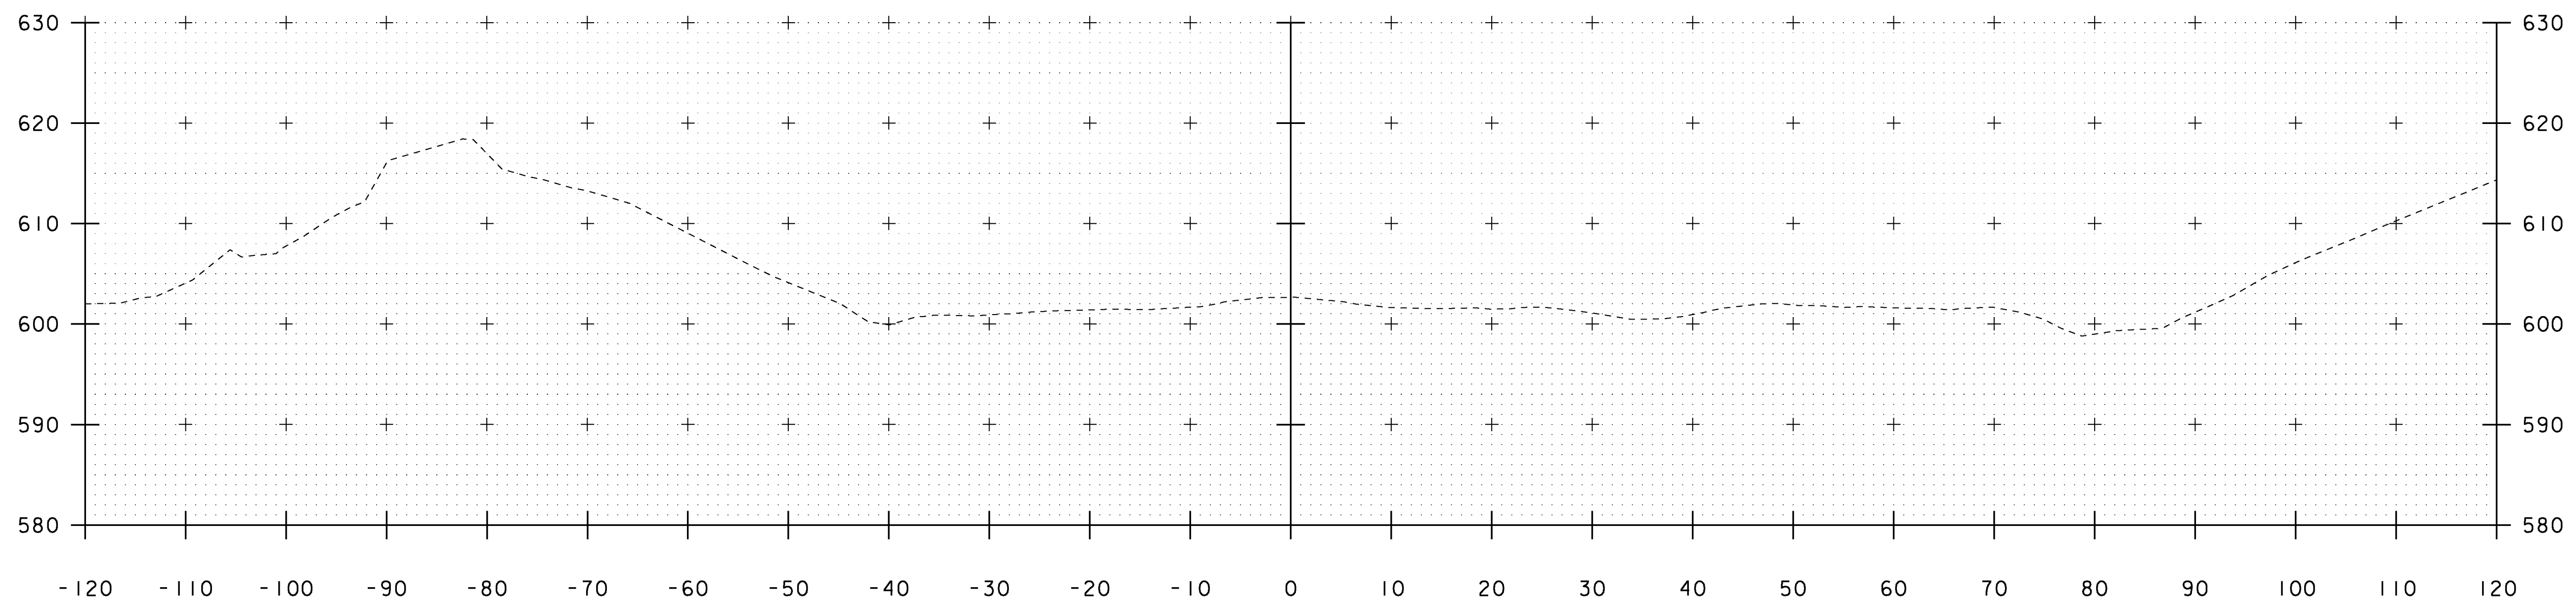

105+00  
STOP PROJECT

MONTPELIER STATE HIGHWAY

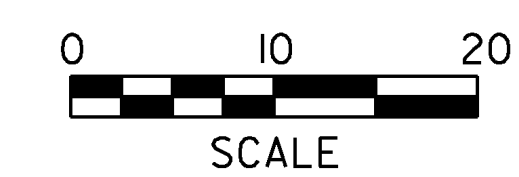

STA. 105+00 TO STA. 105+25

PROJECT NAME: MONTPELIER	PLOT DATE: 24-MAY-2013
PROJECT NUMBER: NH 028-2(9)	DRAWN BY: P. PELOQUIN
FILE NAME: I:\b066\Design\d11b066xs.dgn	CHECKED BY: A. BOMBARDIER
PROJECT LEADER: P. PELOQUIN	SHEET 26 OF 62
DESIGNED BY: P. PELOQUIN	
CROSS SECTION SHEET 8	