


314+00
 BEGIN SOLID ROCK EXCAVATION
 312+00
 RESUME PROJECT

RAMP B

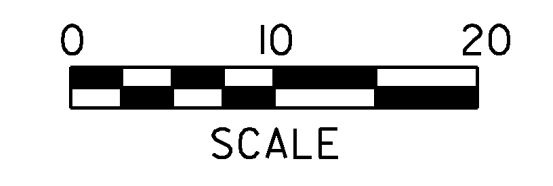

STA. 314+00

PROJECT NAME: MONTPELIER	PLOT DATE: 24-MAY-2013
PROJECT NUMBER: NH 028-2(9)	DRAWN BY: P. PELOQUIN
FILE NAME: I:\b066\Design\dlb066xs.dgn	CHECKED BY: A. BOMBARDIER
PROJECT LEADER: P. PELOQUIN	SHEET 27 OF 62
DESIGNED BY: P. PELOQUIN	
CROSS SECTION SHEET 9	