



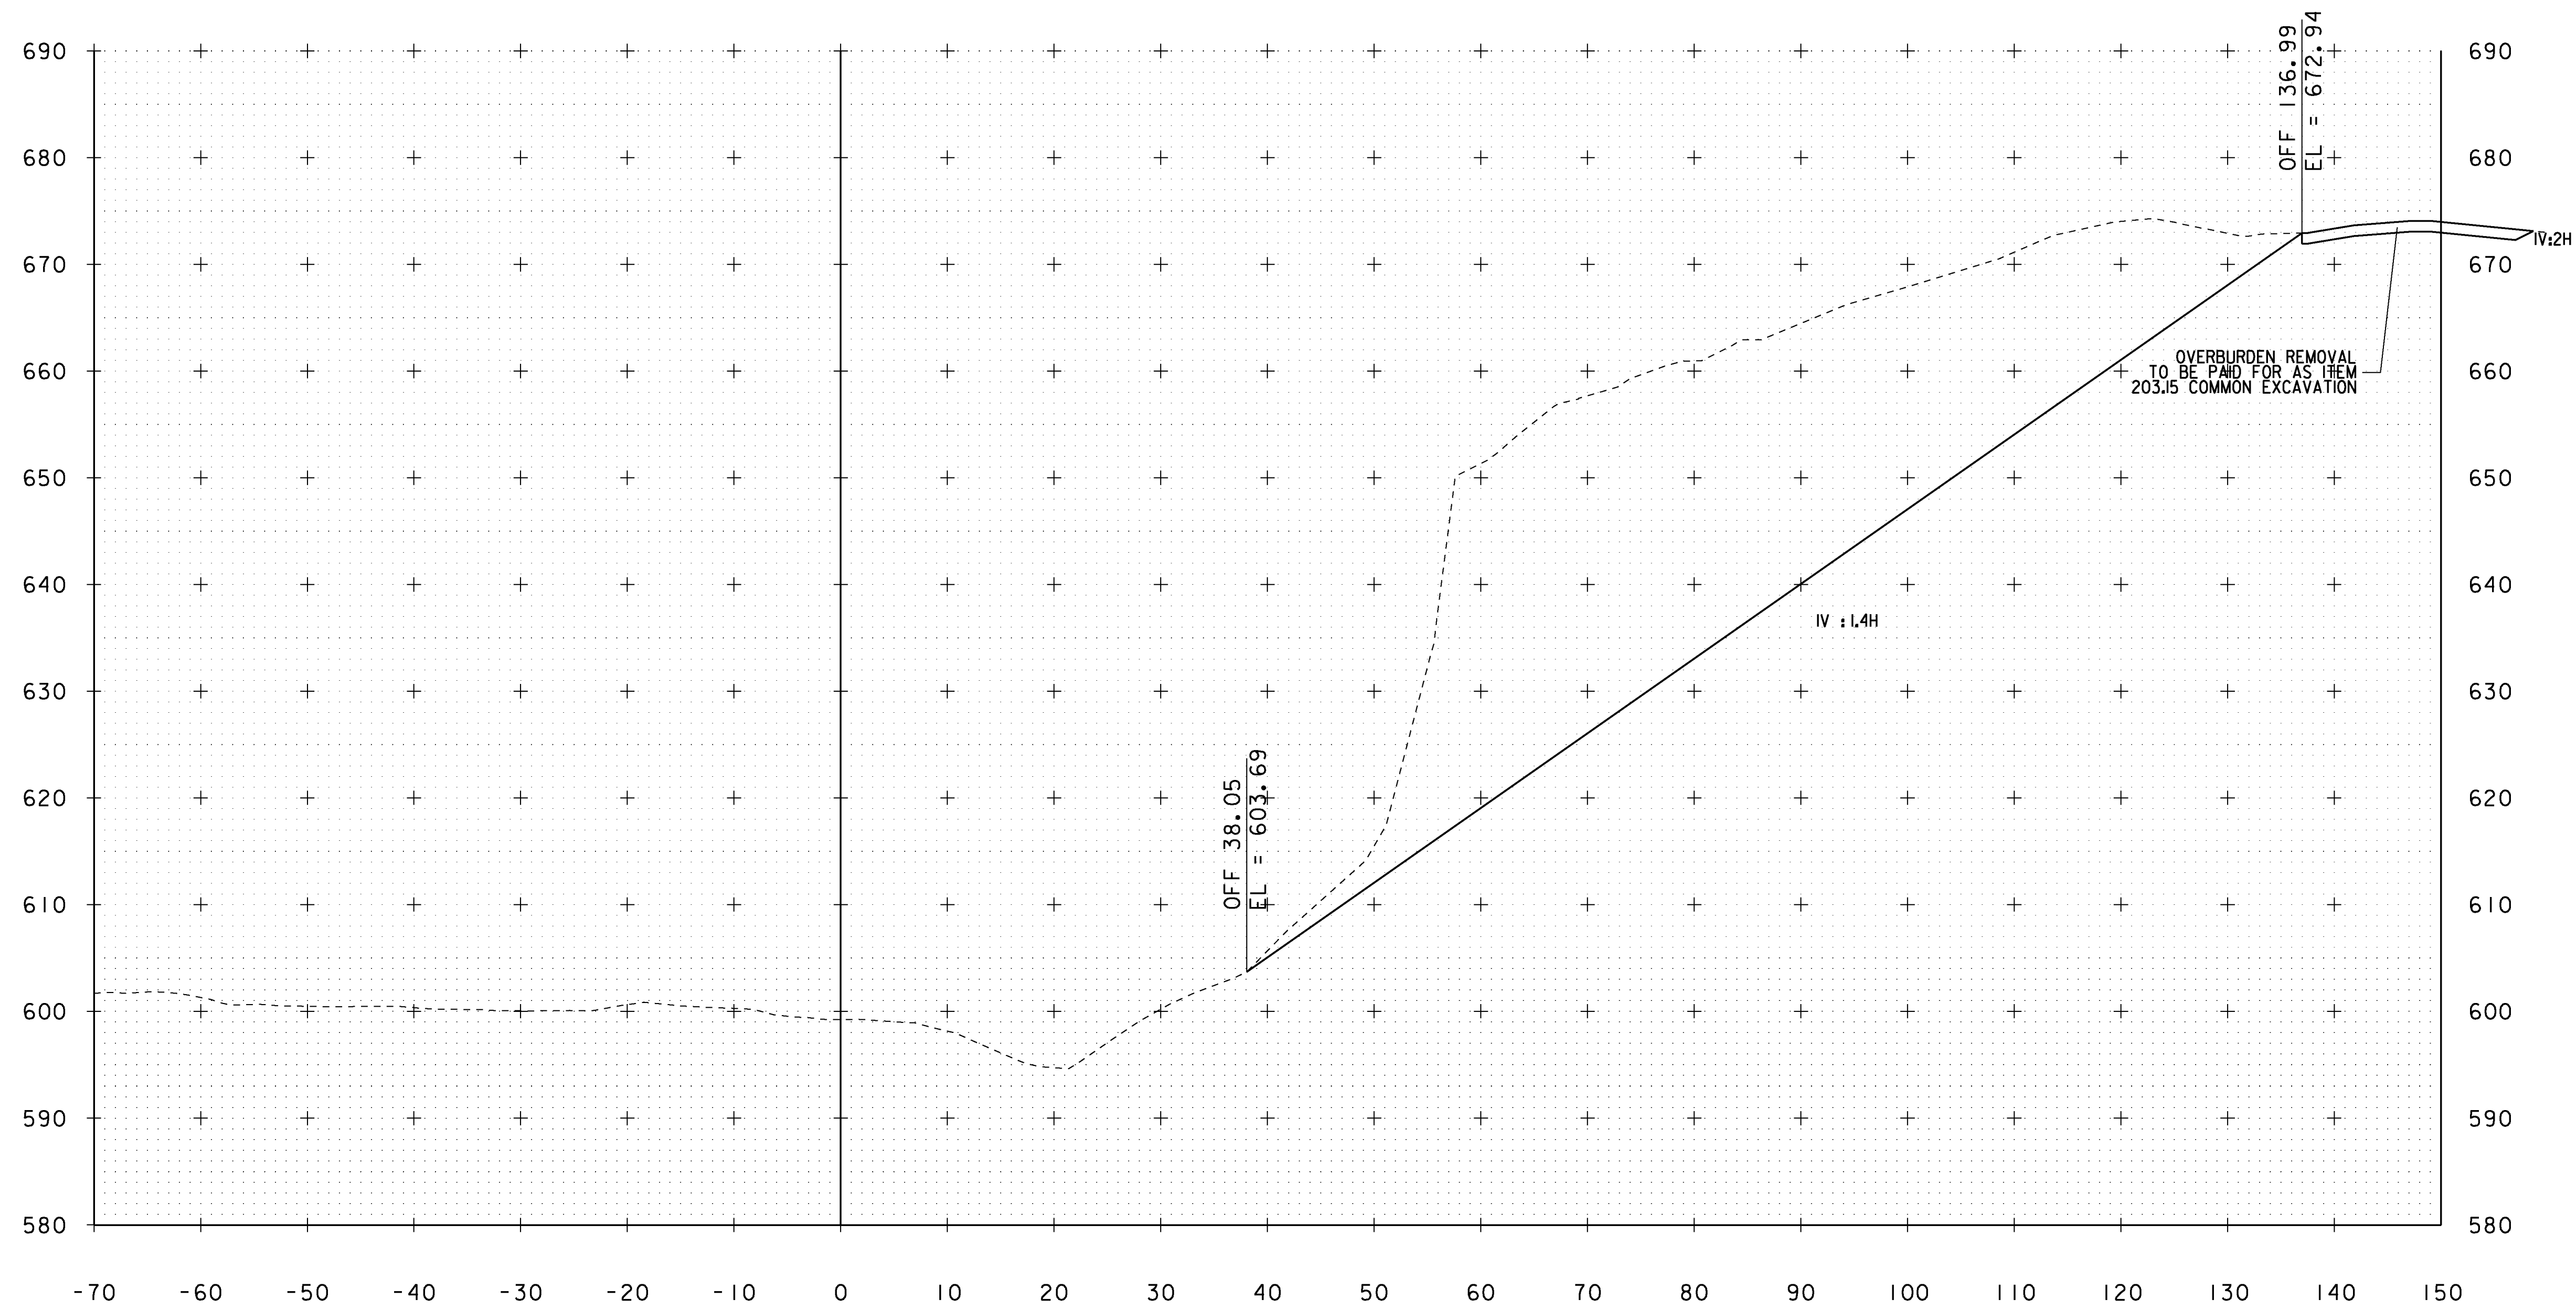

315+00

RAMP B

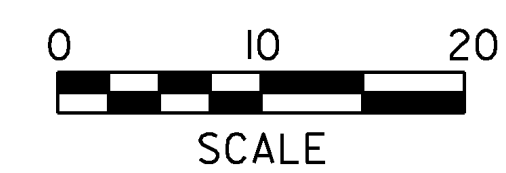

STA. 315+00

PROJECT NAME:	MONTPELIER	PLOT DATE:	24-MAY-2013
PROJECT NUMBER:	NH 028-2(9)	DRAWN BY:	P. PELOQUIN
FILE NAME:	lib066\Design\dlb066xs.dgn	CHECKED BY:	A. BOMBARDIER
PROJECT LEADER:	P. PELOQUIN	SHEET	31 OF 62
DESIGNED BY:	P. PELOQUIN	CROSS SECTION SHEET	I3