



320+25
END PROJECT

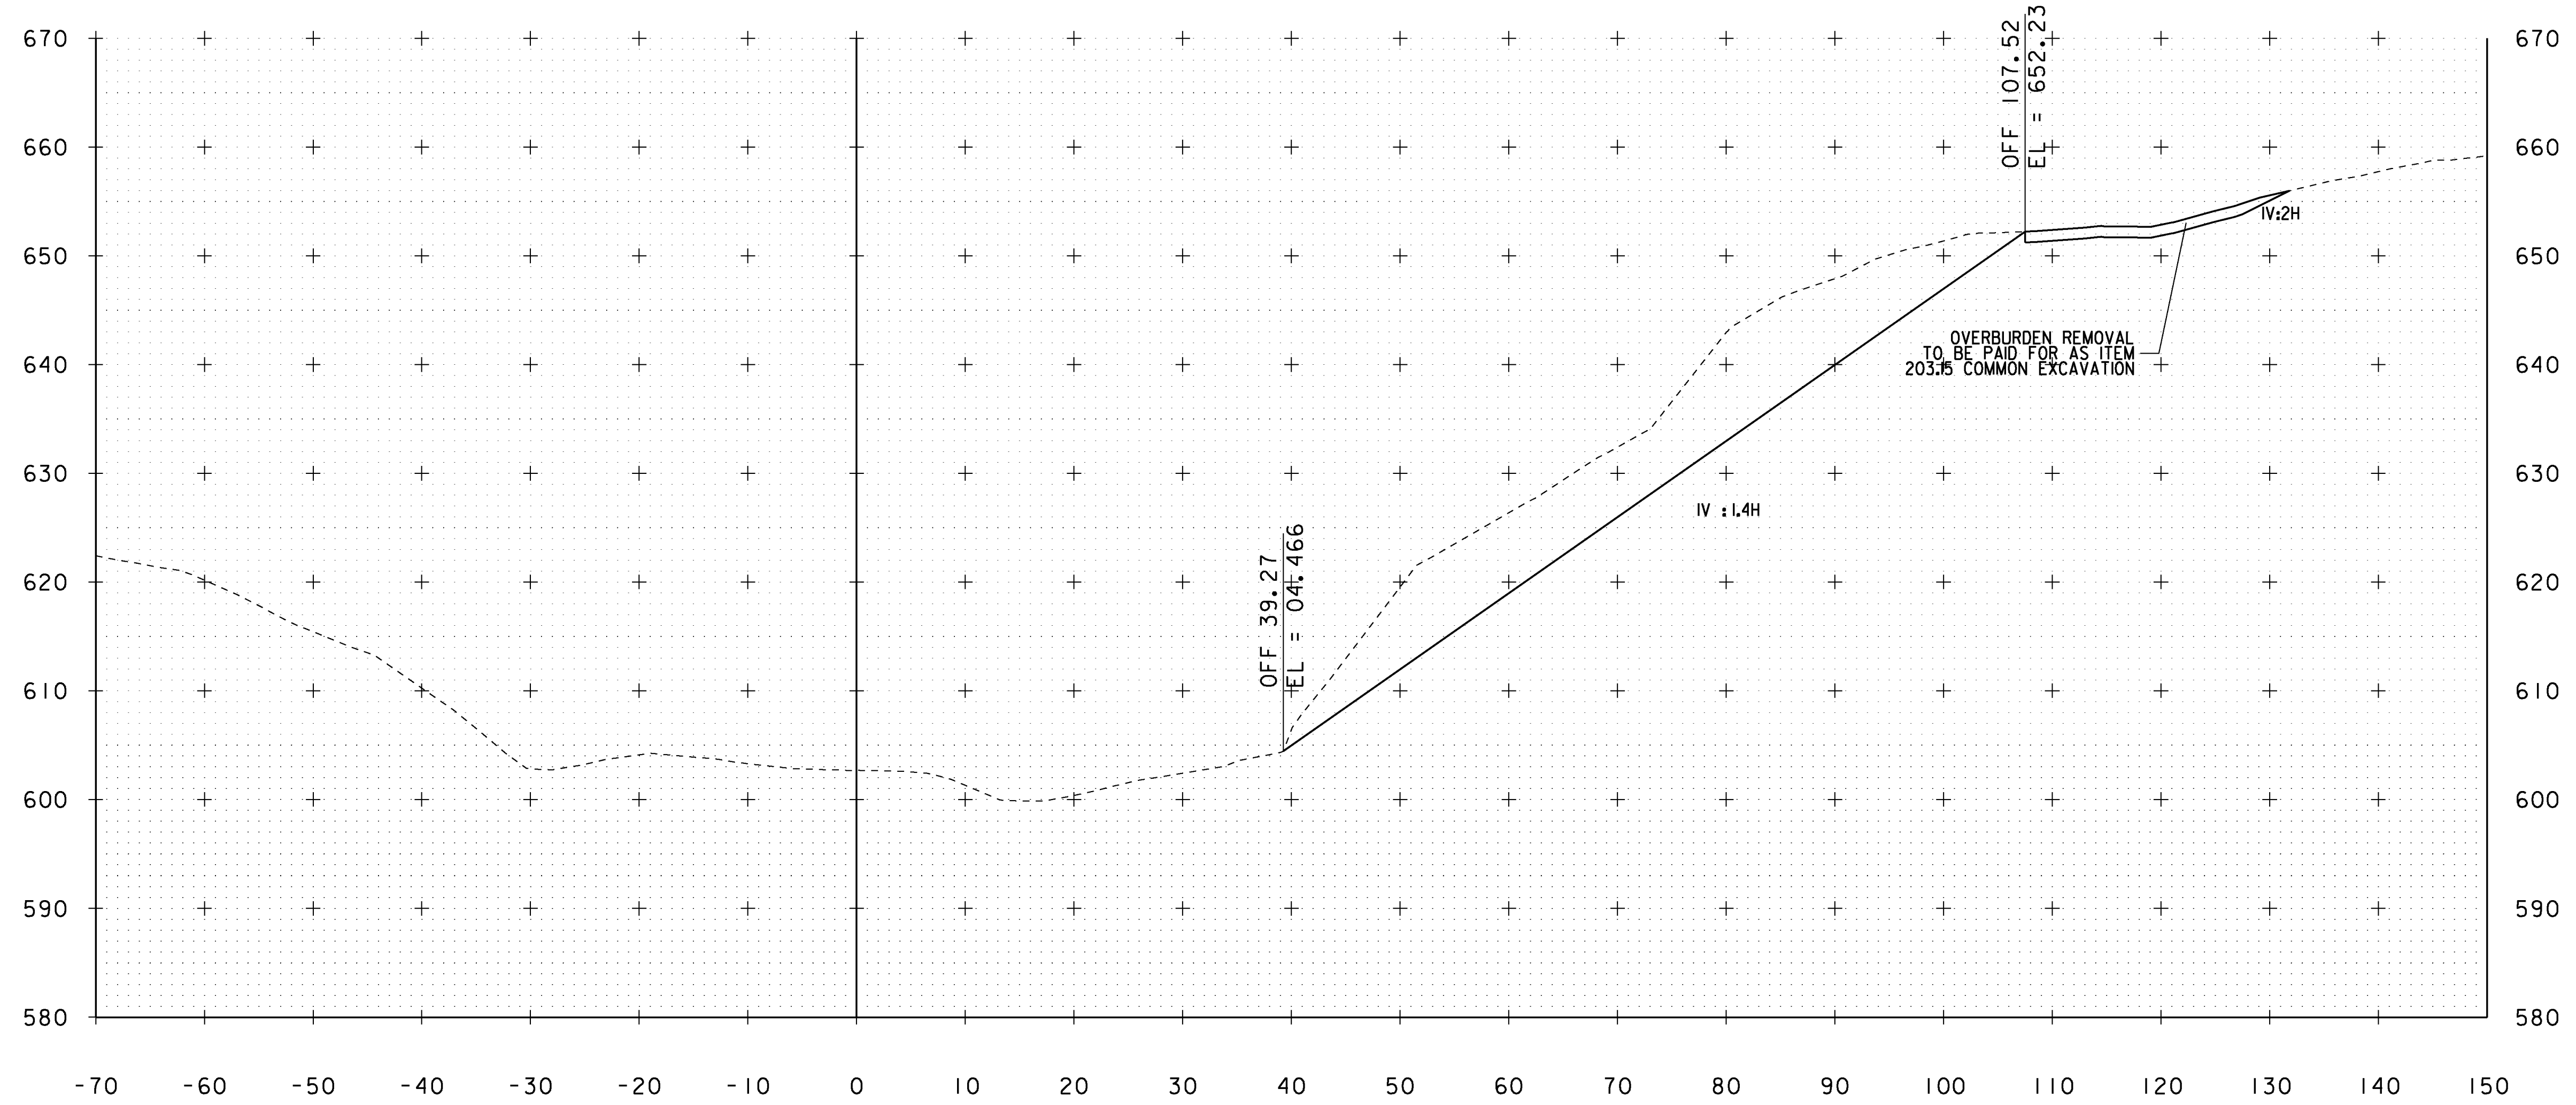

317+00
END SOLID ROCK EXCAVATION

RAMP B

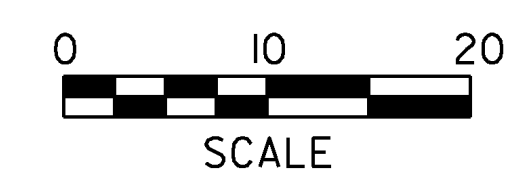

STA. 317+00

PROJECT NAME: MONTPELIER	PLOT DATE: 24-MAY-2013
PROJECT NUMBER: NH 028-2(9)	DRAWN BY: P. PELOQUIN
FILE NAME: I:\b066\Design\dib066xs.dgn	CHECKED BY: A. BOMBARDIER
PROJECT LEADER: P. PELOQUIN	SHEET 39 OF 62
DESIGNED BY: P. PELOQUIN	CROSS SECTION SHEET 21