


MILEMARKER, STATION, OR SIGN NUMBER	SIGN LEGEND	SIGN DIMENSIONS		NEW SIGN "A"	EXIST. SIGN	NO. OF POSTS	NEW SIGN POSTS SQUARE STEEL (in)			REMARKS	SIGN DETAIL	
		WIDTH (in)	HEIGHT (in)				1.75	2.0	2.5		DETAIL ON SHEET NUMBER	STD. SHEET NUMBER
							1.88	2.42	3.35			
55+39.00 RT	BRIDGE 84 VT 105	6	8	0.33		1	8		X	VD-701	E-134	
56+31.00 LT	BRIDGE 84 VT 105	6	8	0.33		1	8		X	VD-701	E-134	
		TOTALS		SF 0.66			FT 16		EA	SHS = STANDARD HIGHWAY SIGNS (MUTCD)		

SIGN LEGEND
 N = NEW
 R = RETAIN

FINAL POST LENGTHS ARE TO BE DETERMINED IN THE FIELD. POST SIZES ARE COMPUTED BASED ON INFORMATION FURNISHED ON THE STANDARD SHEETS AND THE VTRANS "SIGN POST DESIGN GUIDELINE."

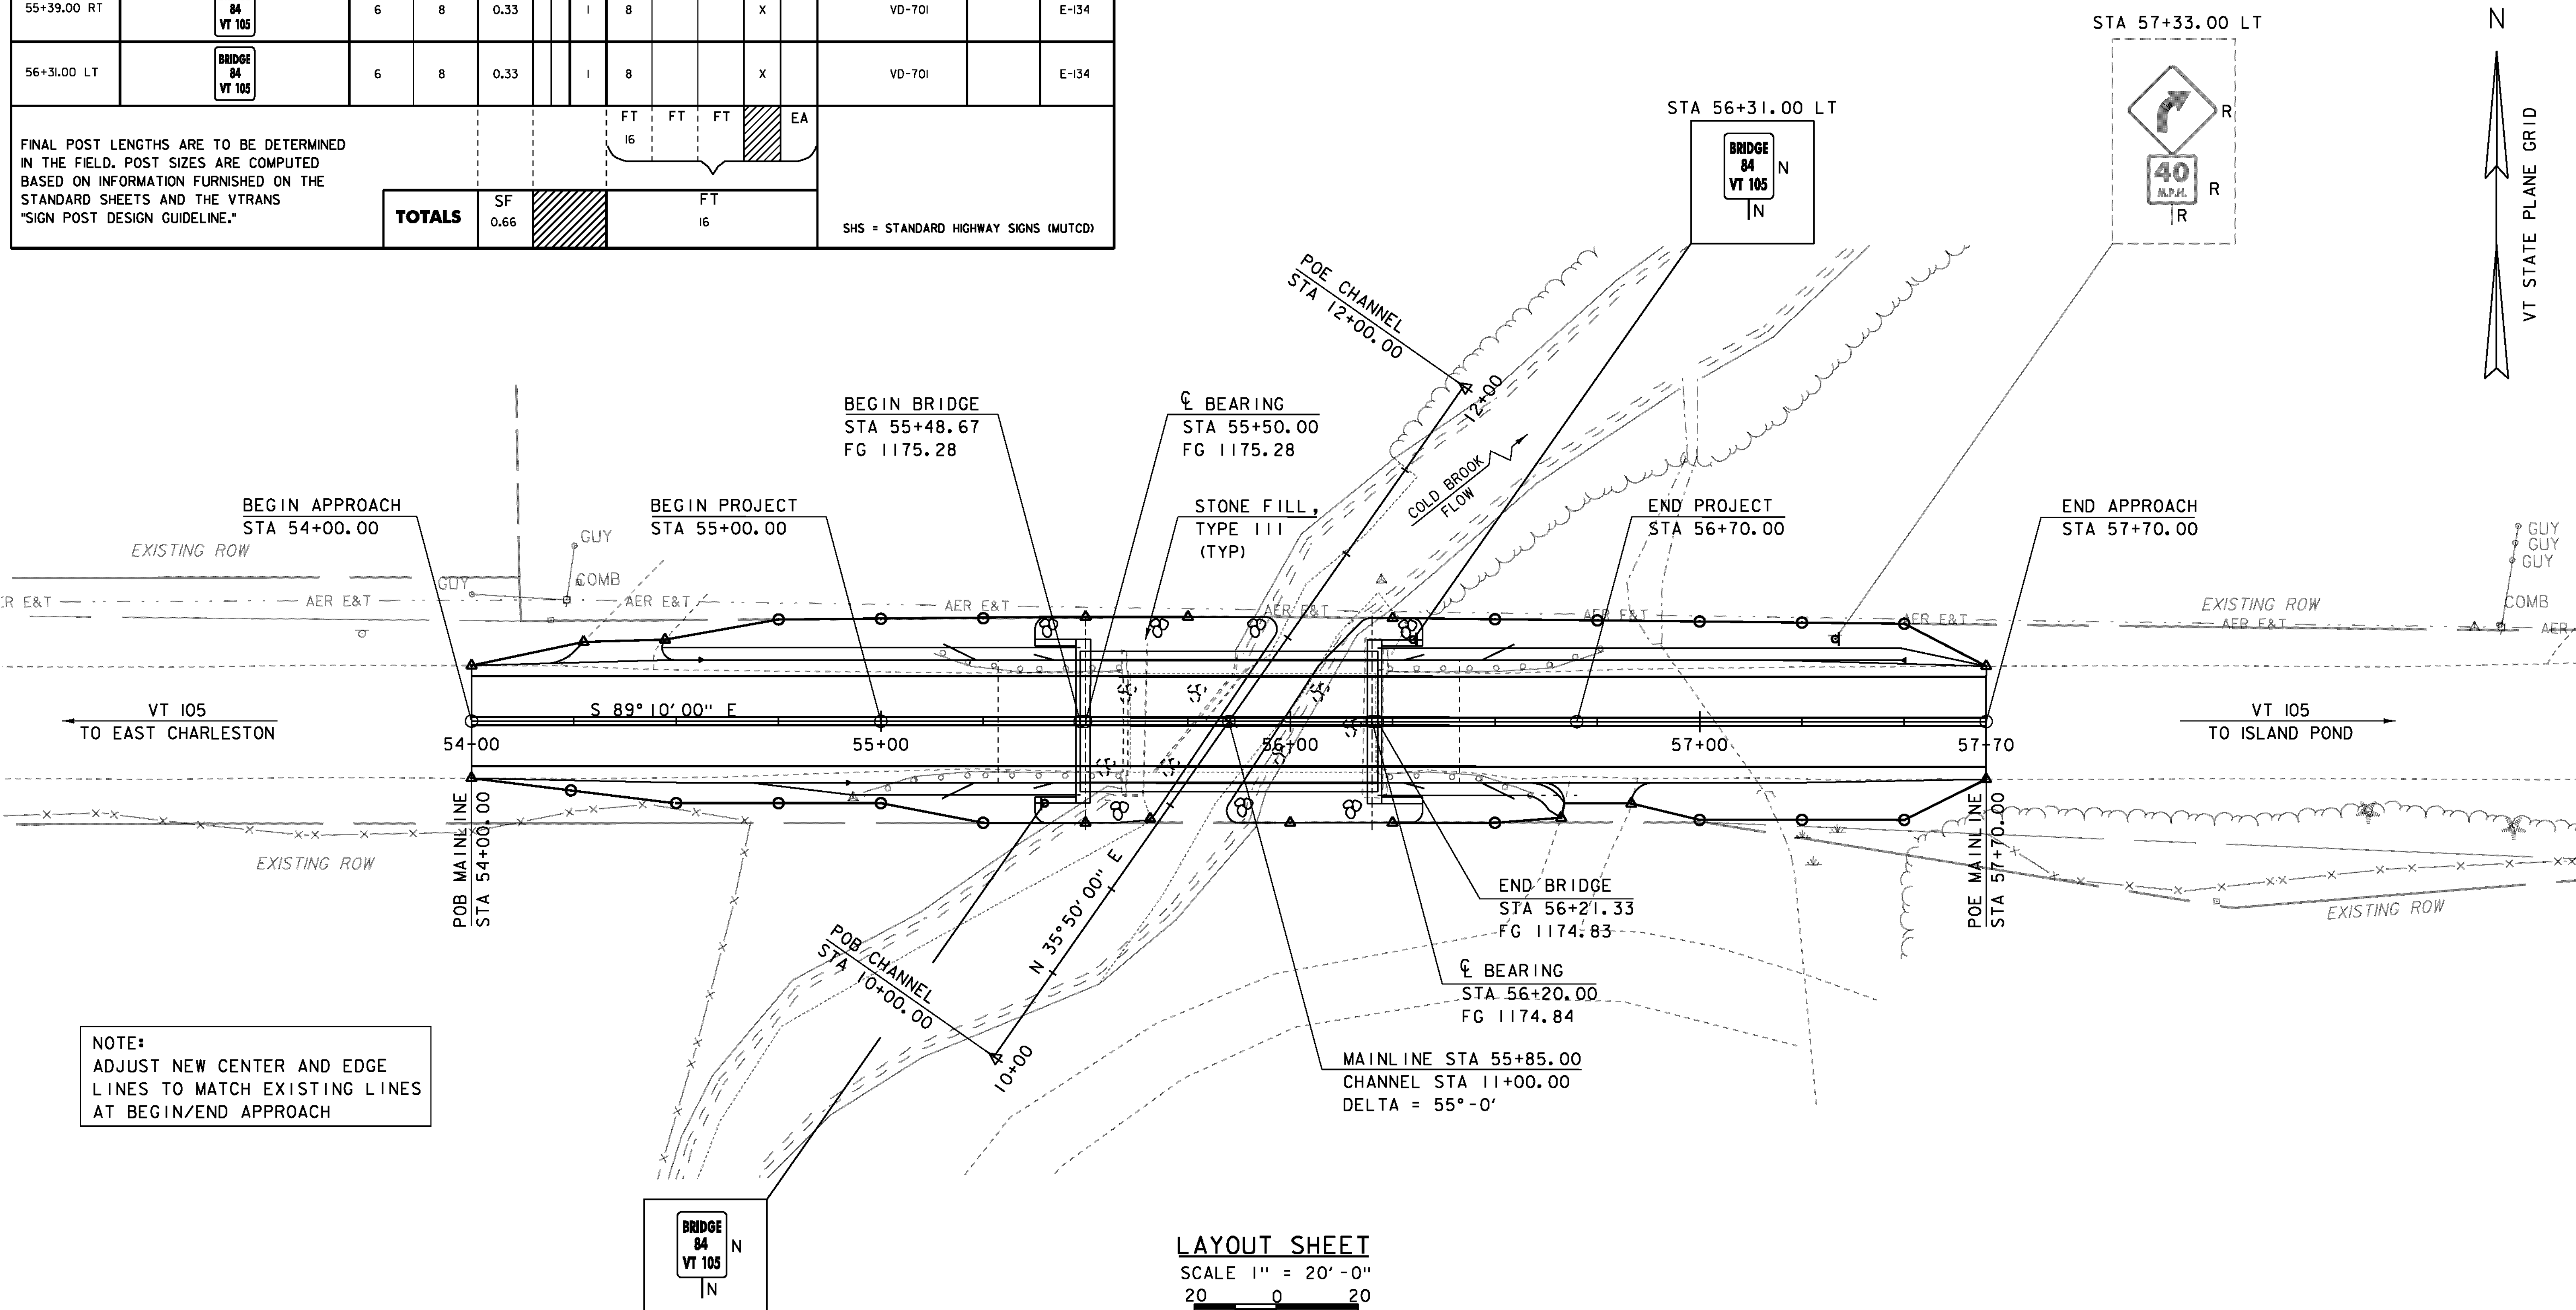

NOTE:
 ADJUST NEW CENTER AND EDGE LINES TO MATCH EXISTING LINES AT BEGIN/END APPROACH

LAYOUT SHEET
 SCALE 1" = 20'-0"
 20 0 20

- CONSTRUCT PAVED APRON (5 FT)
 STA 54+18.00 - 54+50.00 LT
 STA 56+62.00 - 56+88.00 RT
- SPECIAL PROVISION (REMOVAL OF TEMPORARY BRIDGE AND APPROACHES)
 STA 55+00.00 - 57+00.00
- TRAFFIC SIGNS, TYPE A
 STA 55+39.00 (RT)
 STA 56+31.00 (LT)
- 4" WHITE LINE (LT & RT)
 STA 54+00.00 - 57+70.00
- 4" YELLOW LINE (DOUBLE)
 STA 54+00.00 - 57+70.00

PROJECT NAME: BRIGHTON
 PROJECT NUMBER: ER STP 034-3(25)
 FILE NAME: s11b208bdr.dgn
 PROJECT LEADER: K. HIGGINS
 DESIGNED BY: J. SALVATORI
 LAYOUT SHEET
 PLOT DATE: 12-SEP-2012
 DRAWN BY: J. SALVATORI
 CHECKED BY: W. LAMMER
 SHEET 9 OF 36